



S.S. Kumaiovo Mkt. 1036.

Sketches showing position of electric welding on seams
of combustion chambers fire side in red.


Port Ford Boiler.

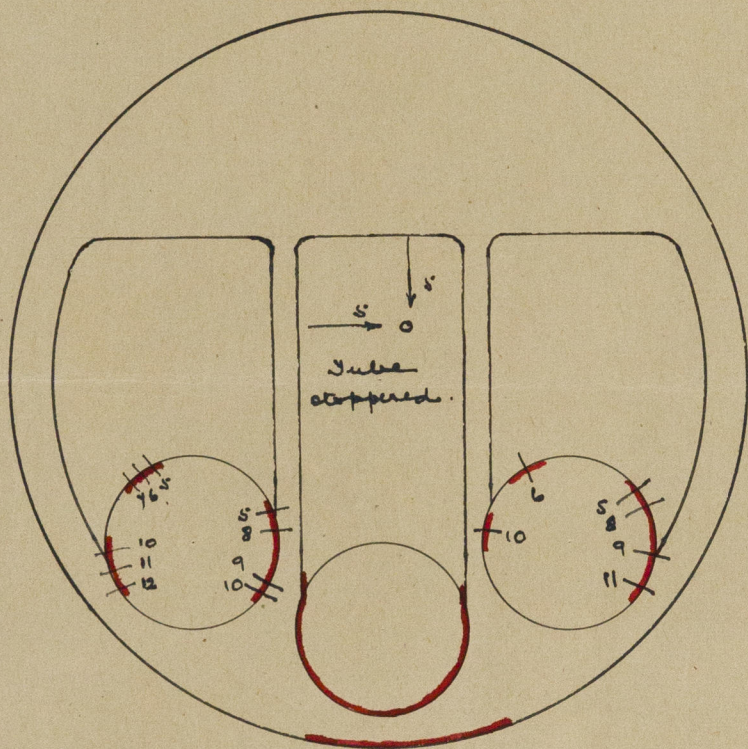

Port Aft Boiler.

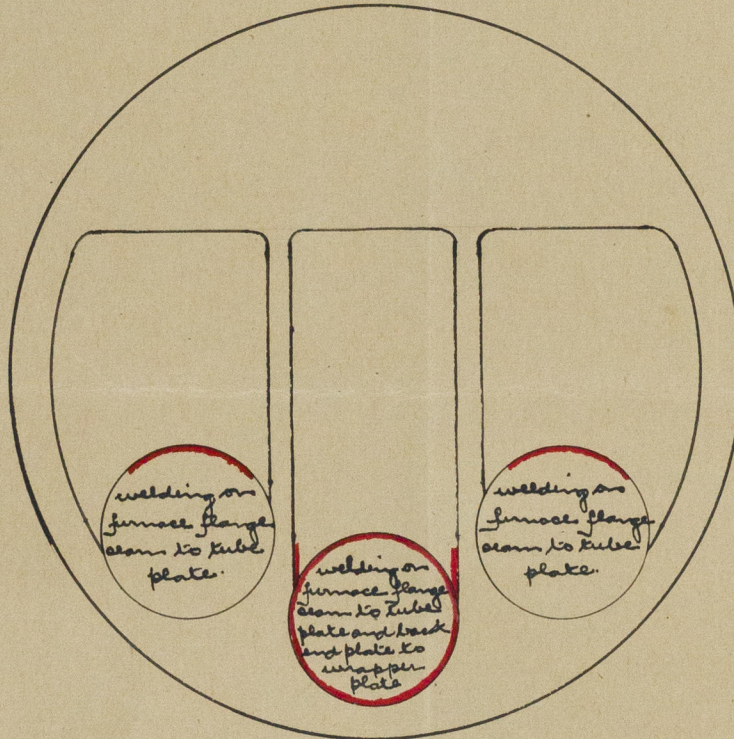

Starboard Aft Boiler.

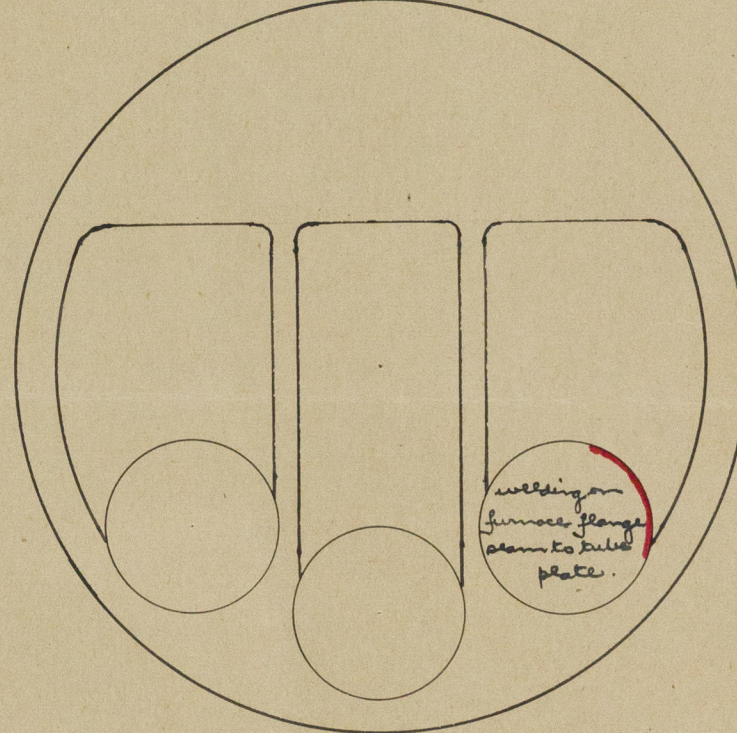

© 2019
H. D. Jones
Maiden 6/44.
Register
Foundation

W248-0143.1