


LONDON COPY,

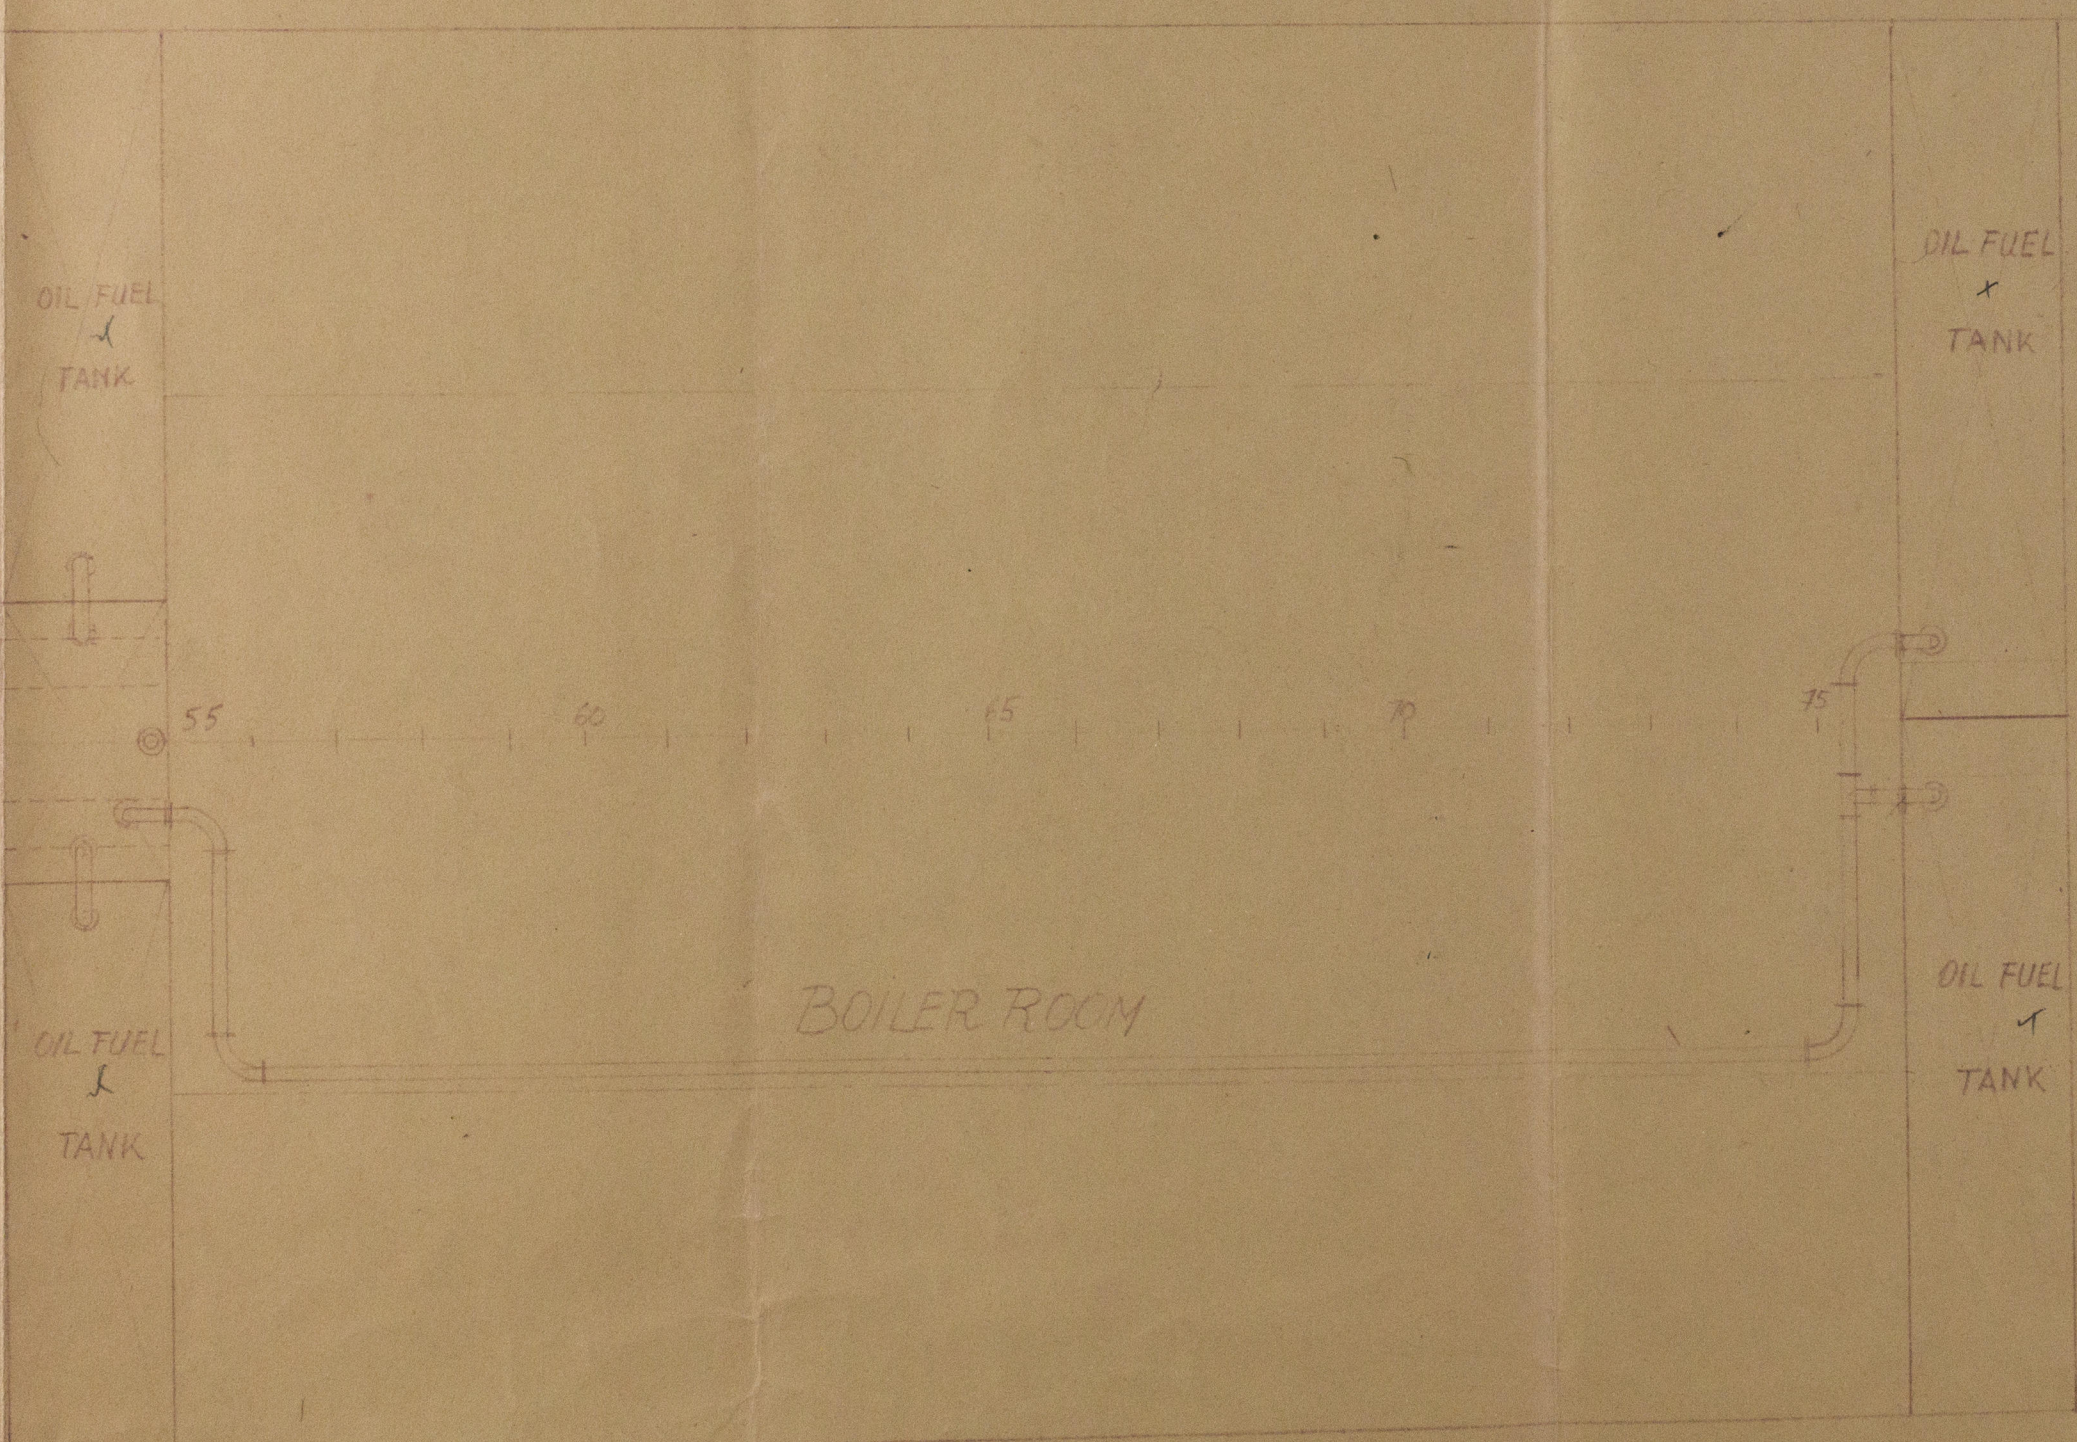

Size of air & overflow pipes
as per Section 20 D, bl. 2.
Provision to be made for sounding
tanks.
Plan of pumping arrangement to be submitted.
The flash point of the oil fuel to be above 100°F. and
the remaining requirements of Section 20 of the Rules
(1925-26) to be complied with so far as they are applicable.

12/11/35
1/10

5/5 KUMANOVO

DISPOSITION OF PROPOSED
OIL FUEL TANKS

1:50

Number	Brodogradilište, Split A.D.	Proj. / Ime
	Spedište: Split Francuska Obala 2	Kont. / Pregl.
	DISPOSICIJA TANKOVA ZA NAFTU - 5/5 KUMANOVO	Crt. br.
Mjerilo	1:50	Prib.

S. S. Kumanova Miss
No. 492.

W248-0183



© 2019

Lloyd's Register
Foundation