


List of Fittings

Order No.	Description Predmet	Bore Point	Order No.	Description Predmet	Bore Point
83	Cross pipe Križni razgranak	2"	100	Cross pipe Križni razgranak	1 1/2"
84	" " " "	1 1/2"	101	Bulkhead branch piece Prilazni komad na pregradi	1"
85	Valve Ventil	2"	102	" " " "	1"
86	Three way pipe Troputni razgranak	1 1/2"	103	" " " "	1"
87	Valve Ventil	1"	104	Three way pipe Troputni razgranak	1 1/2"
87a	" " " "	1"	105	Bulkhead branch piece Prilazni komad na pregradi	1"
88	Bulkhead branch piece Prilazni komad na pregradi	1"	106	Valve spindle rod Šipka ventilkog vretena	3/4"
89	" " " "	1"	107	" " " "	3/4"
90	Three way pipe Troputni razgranak	2 1/2"	108	Three way pipe Troputni razgranak	1 1/2"
91	" " " "	1 1/2"	109	Valve Ventil	1 1/2"
92	Valve Ventil	1"	109a	" " " "	1 1/2"
93	" " " "	1"	110	" " " "	1 1/2"
94	Bulkhead branch piece Prilazni komad na pregradi	1"	111	Three way pipe Troputni razgranak	1 1/2"
95	" " " "	1"	112	" " " "	2 1/2"
96	Three way pipe Troputni razgranak	1 3/4"	113	" " " "	2 1/2"
97	" " " "	2 3/4"	114	Valve Ventil	1"
98	" " " "	1 1/2"	115	Steam pipe connection Spojnica za parne cevi	1"
99	" " " "	1 1/2"	116	Valve Ventil	1"
			117	Steam pipe connection Spojnica za parne cevi	1"

List of Pipes

Order No.	Description Predmet	Bore Point	Order No.	Description Predmet	Bore Point
1	To Installation za grijac i sisaljke	2"	15	Exhaust from Heating Bunker Aft Izlaz pare od grijaca tanka straž	1"
2	To Heating Plant za grijac	1"	16	" " " " Forw P. P. 16a	1"
3	To Transfer Pump za cirkulac. sisaljku	1 1/2"	17	" " " " Bunkers	1 1/2"
4	To Heating O.F. Bunker Aft. P. za grijanje tanka	1 1/2"	18	" " " " " tankova	1 1/2"
5	" " " "	1 1/2"	19	Drain from Observation tank Izlaz iz cistilice ufillara	1 1/2"
6	" " " " Forw P. 16a	1 1/2"	20	To Fire Extinguishing system U ratrogasni sustav	1 1/2"
7	" " " " " P. 21	1"	21	To O. Board connection S. za dani vanbrodski priključak	1"
8	Exhaust from Heating Plant Pumps Izlaz pare iz sisaljke grijaca	1 1/2"	22	" " " " " P	1"
9	" " " " " P. 3/4	3/4"	23	Drain to Bilge Izlaz u kaljužu	1"
10	" " " " Transfer Pump	2"			
11	To condenser N. Kondenzator	2"			
12	Drain from Heater Water Collector Odvod vode iz kolektora grijaca	1"			
13	Exhaust " " " " 1 1/2"	1 1/2"			
14	Exhaust from Heating Bunker Aft Izlaz pare od grijaca tanka	1"			

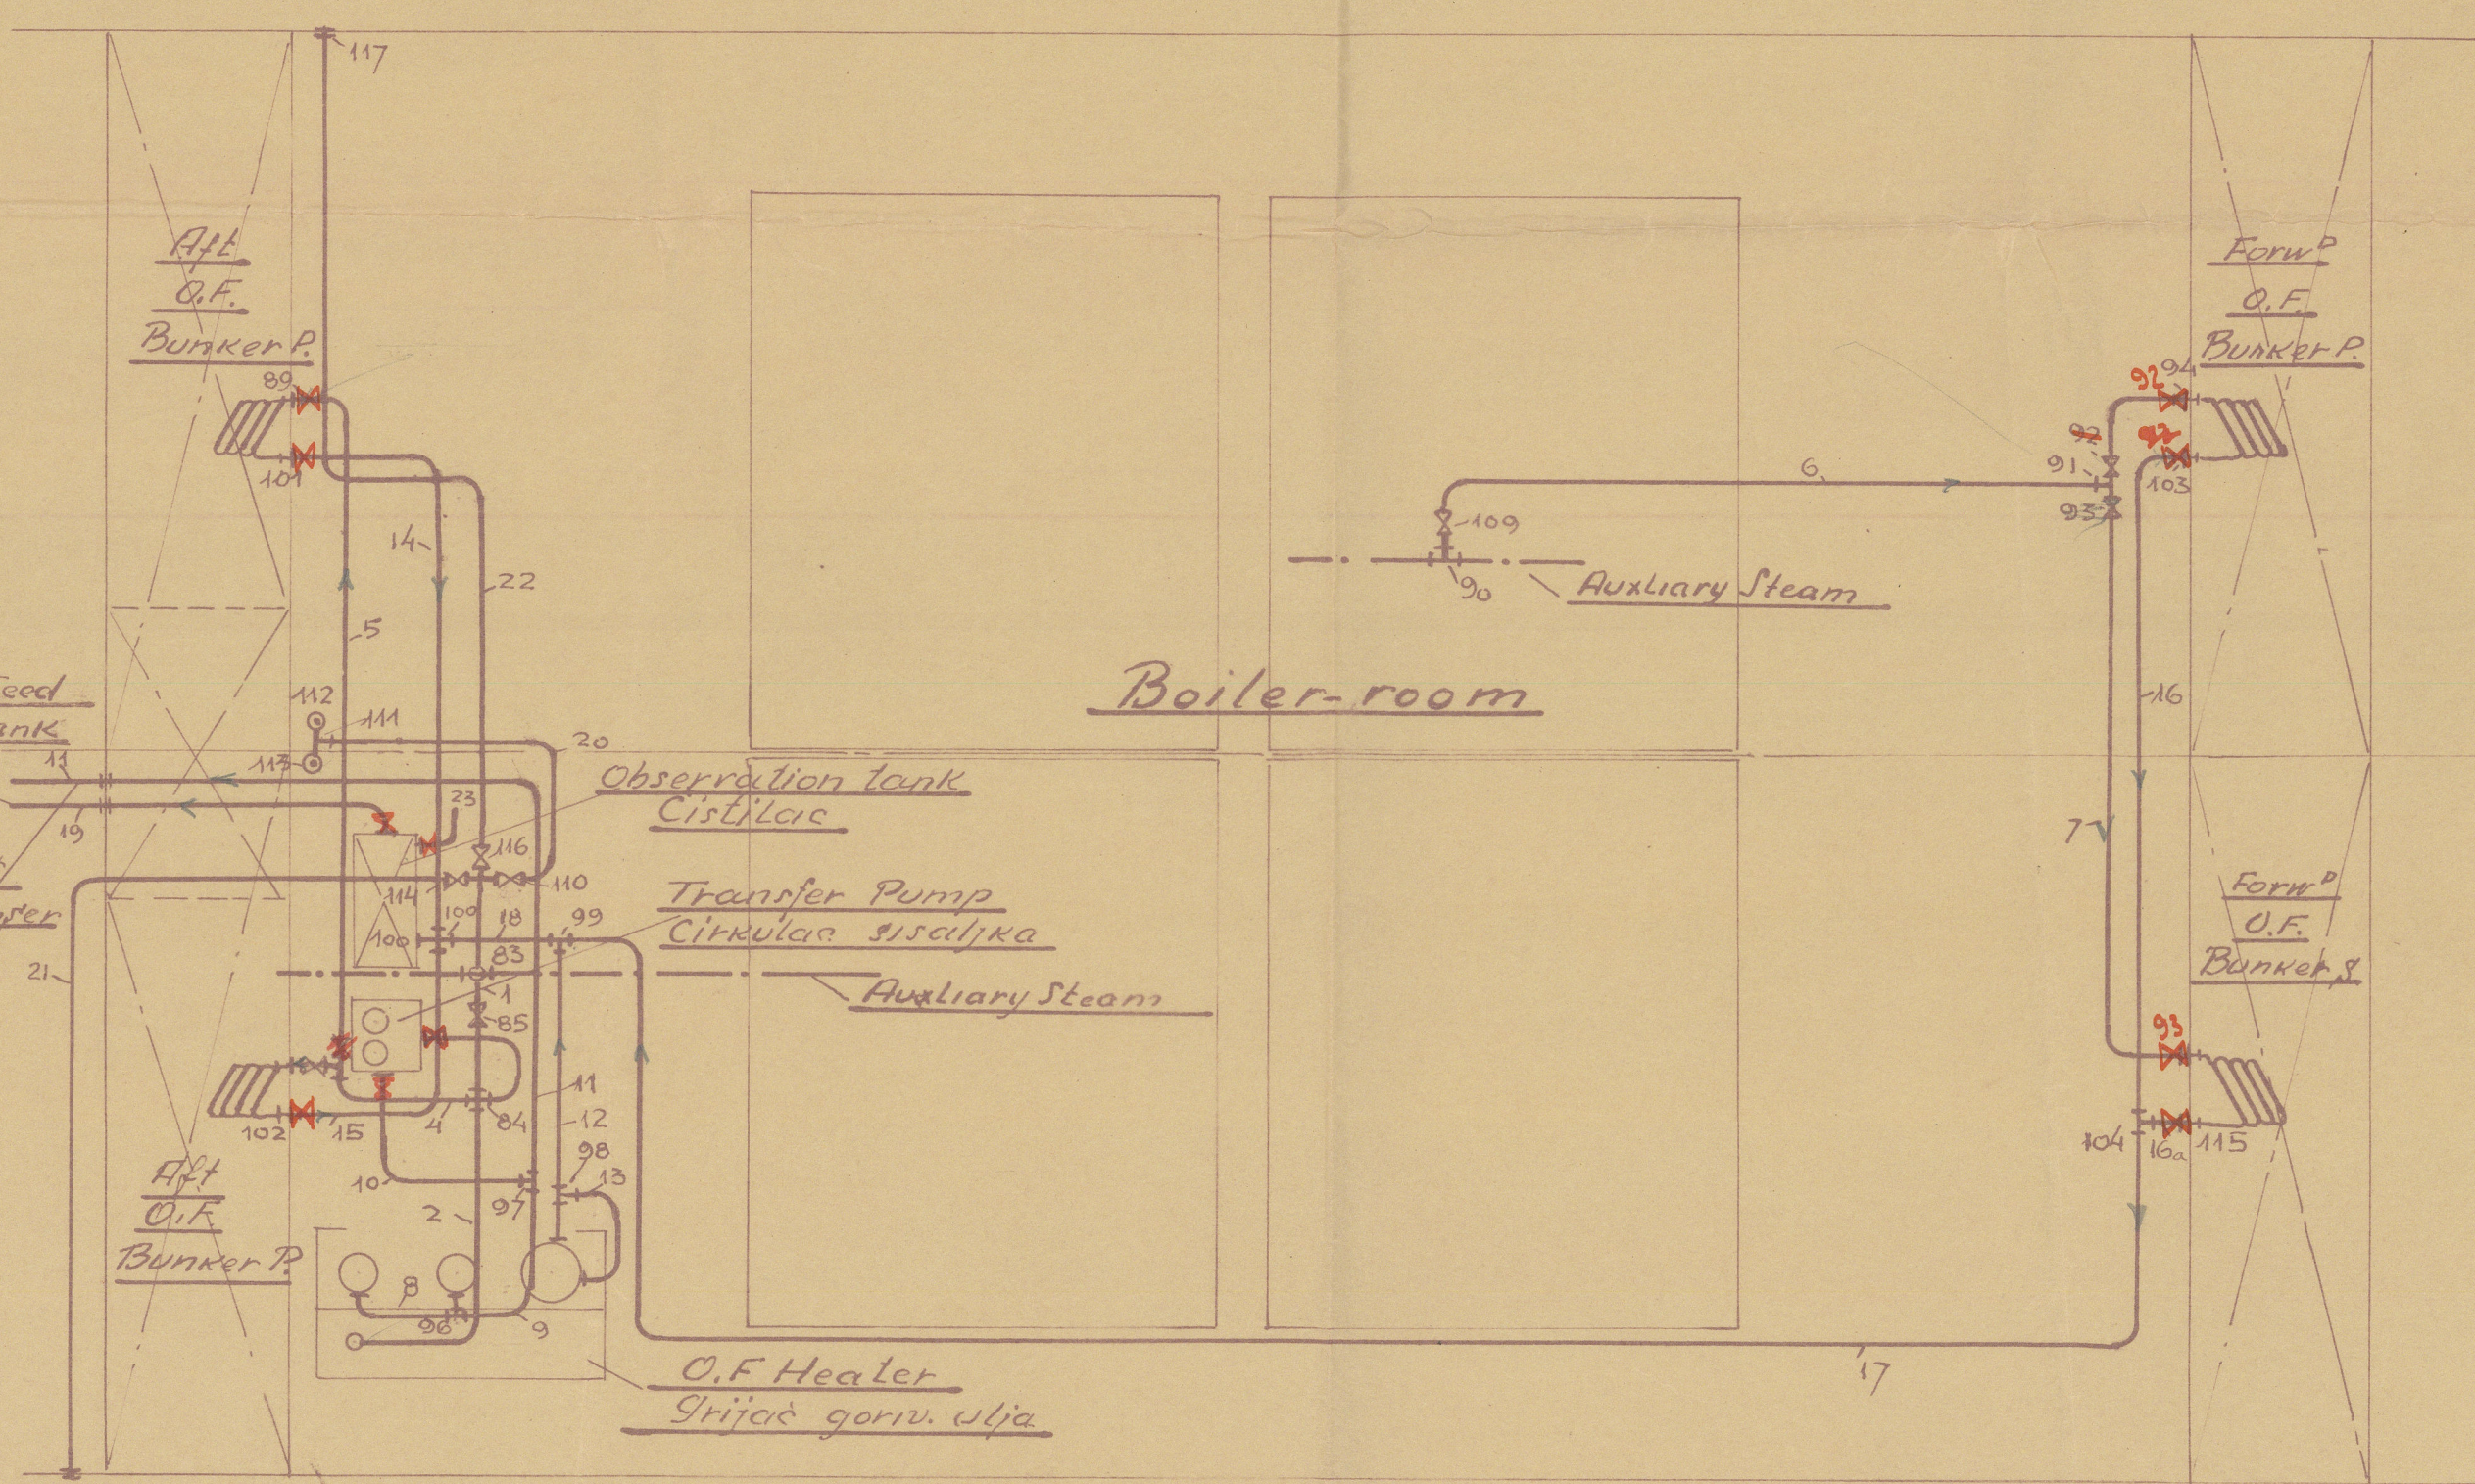

Note: O.F. Heaters Transfer Pump all Pipes & Fittings are ordered from Wallsend Slipway & Engineering Co. - Conforming to Lloyd's Reg. requirements.

Number and position of steam and exhaust valves to be to the Surveyor's satisfaction. Scantlings of steam pipes to be as per Rules. W.J.F. 22/11/35.

Nav. br.	Brodogradilište „Split“ A.D.	Dr. br.	1645
	Sjedište: Split Francuska Obala 2	Pr. br.	1645
Steam & Water Pipe Arrangement Cevovod za paru i vodu		Cr. br.	
Mjerilo: 1:50	Pr. br.	1645	
W248-0189		Register Foundation	



*St. Kumanova, Opus n. 11*  
*No. 492*

LONDON COPY.



© 2019

Lloyd's Register

W248-0189 Foundation