
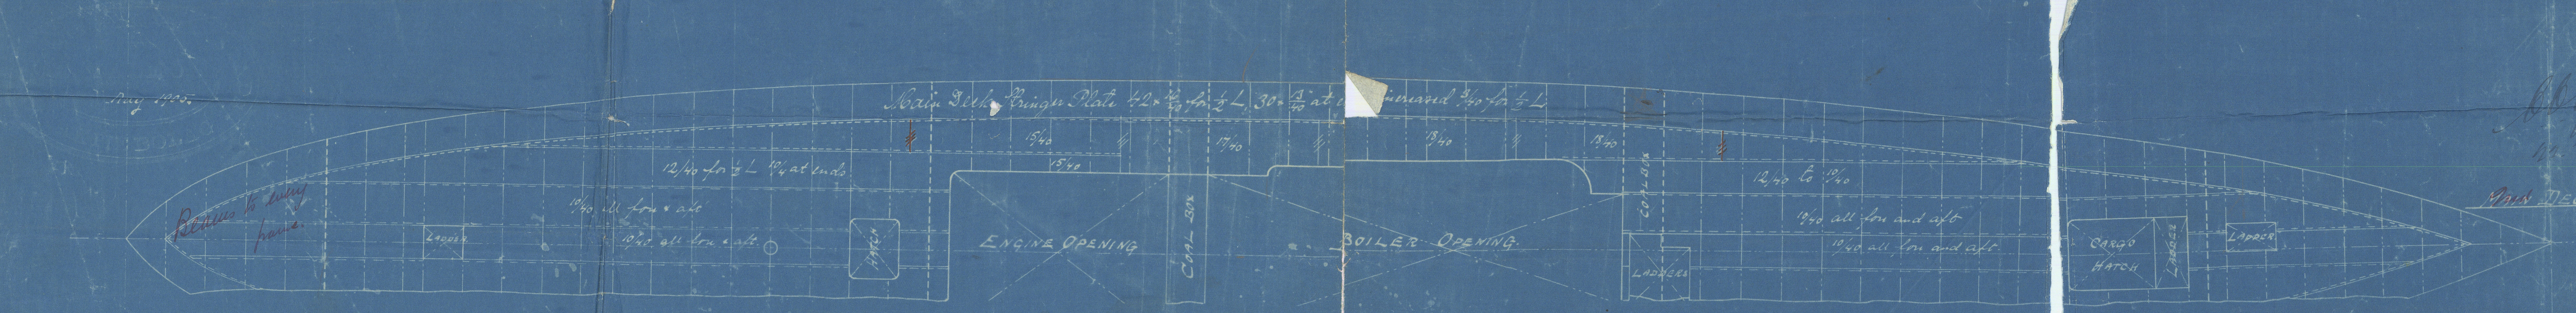
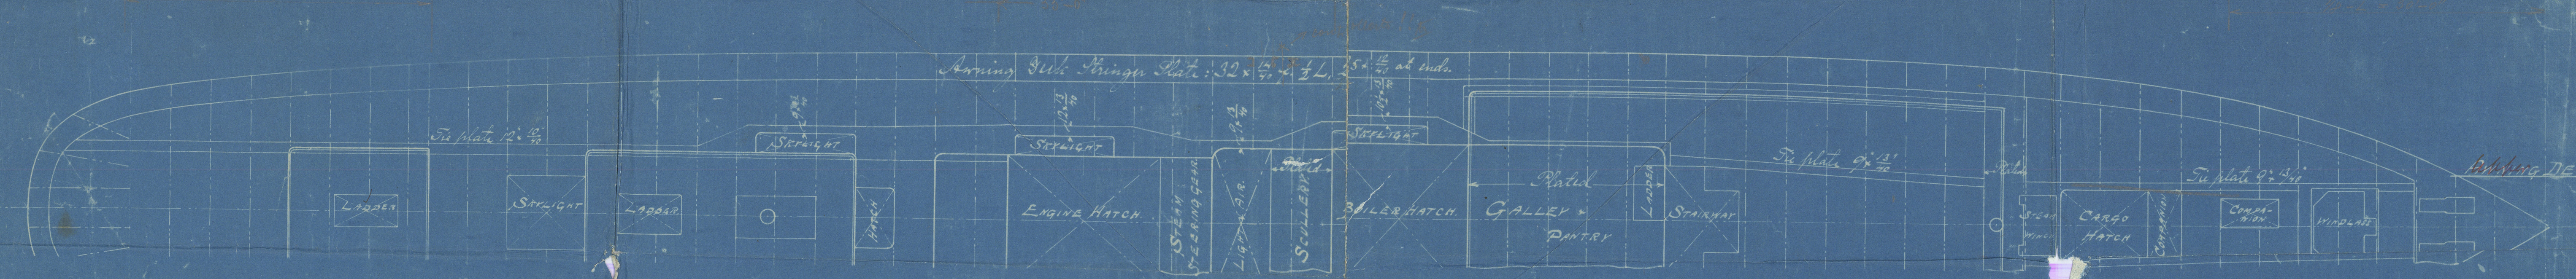


AWNING DECK PASSENGER TWIN SCREW STEAMER

SS N° 91.

SCALE $\frac{1}{8}$ " = 1 FOOT

LENGTH BETWEEN PERPENDICULARS — 240'-0"
BREADTH MOULDED — 35'-0"
DEPTH MOULDED TO MAIN DECK — 15'-0"
HEIGHT OF AWNING DECK — 7'-6"

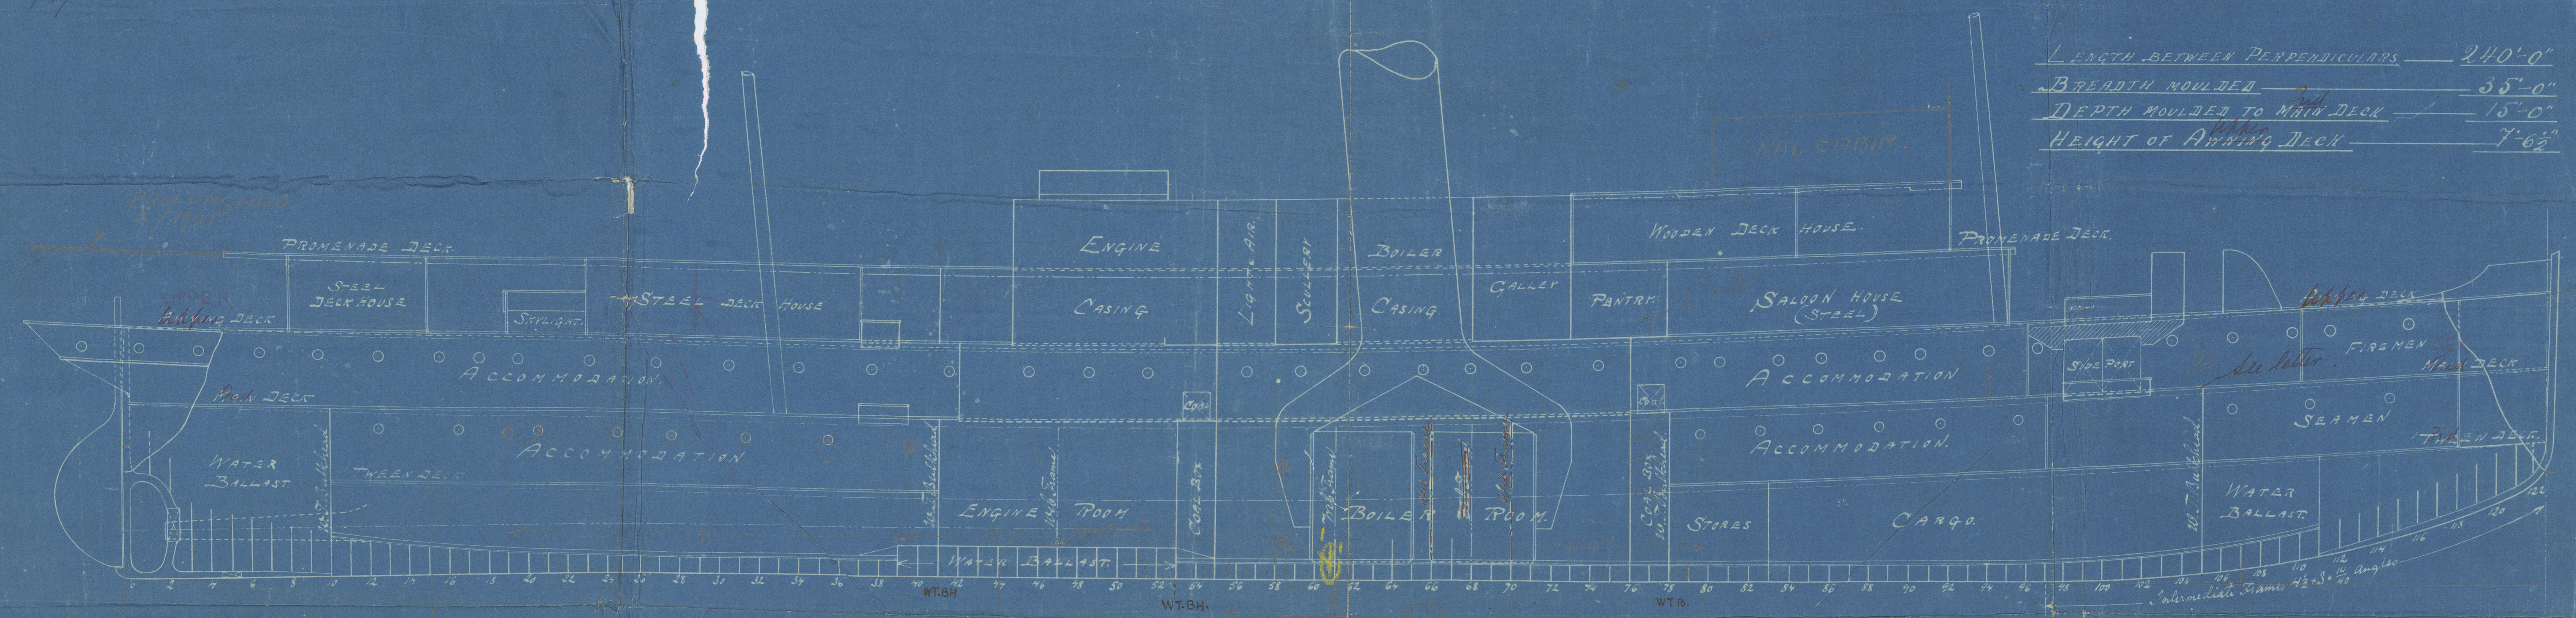

8/s " KUMANOVO "

Report Volume No. 2846

recd 10/27/25

S/P. KUMANOVO

CONSTITUTIONAL

PLAN.



© 2019

Lloyd's Register
W 248-0206
Foundation