
PLANAFTFOR

S.S. KINGSWOOD  
AUXILIARY BOILER.

SECTION SHEWING STARB® COMB. CHAMBER.SCALE  $\frac{1}{2}$ " = 1 FOOT.

W.H.

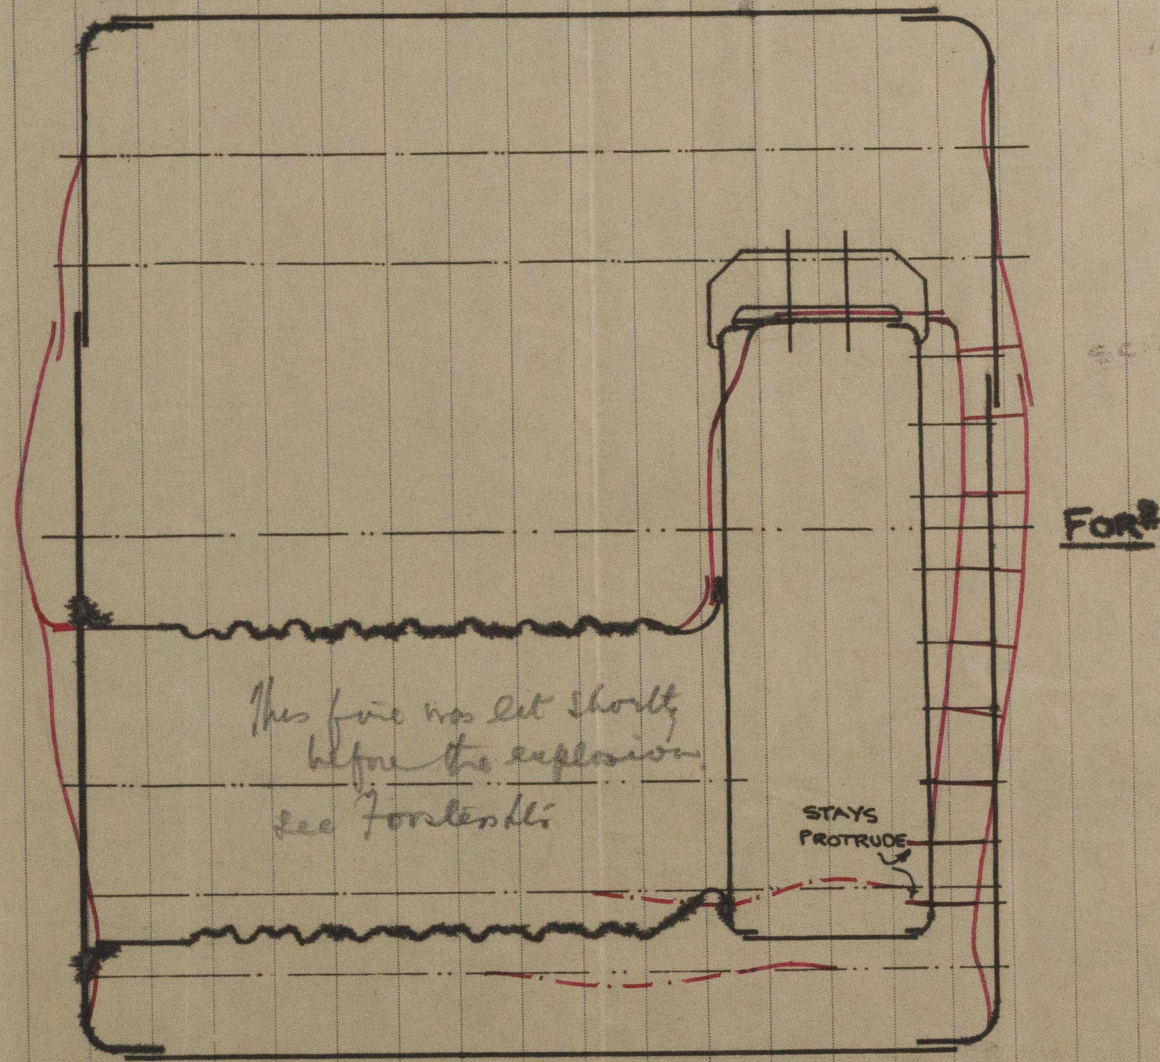

© 1920

Lloyd's Register  
Foundation