


S.S. KINGSWOOD
AUXILIARY BOILER

AFT

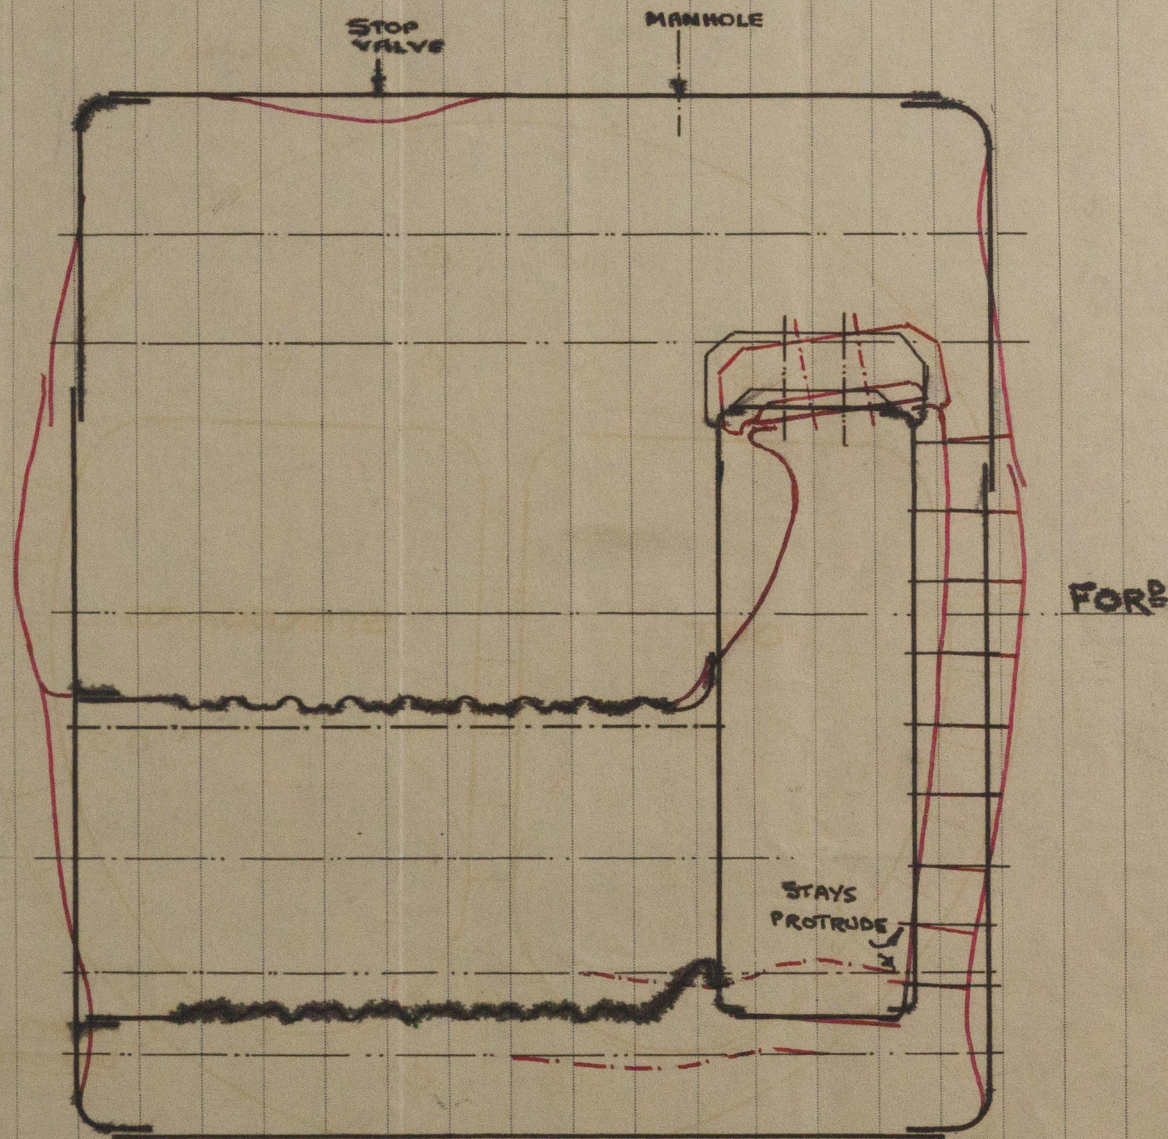

SECTION SHEWING PORT COMB. CHAMBER.

SCALE $\frac{1}{2}$ " = 1 FOOT.

W.H.

5m. 137. T.

W249-0050