



COMBINED ELASTIC & FRICTIONAL COUPLING.

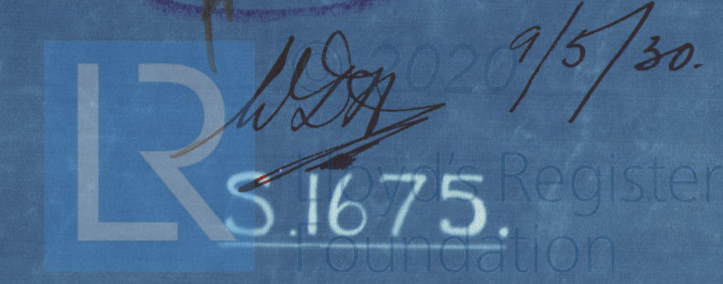

W249-0106

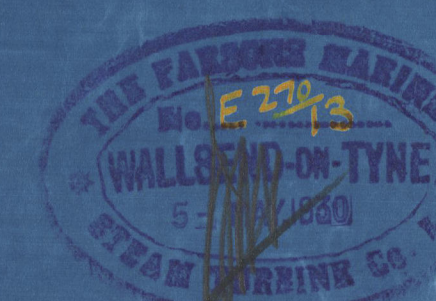


S/S "KINGSWOOD"

Elastic Coupling

Messrs Parsons Marine

Nº 240

London

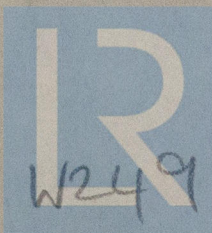

© 2020

Lloyd's Register  
Foundation