



17/5/30

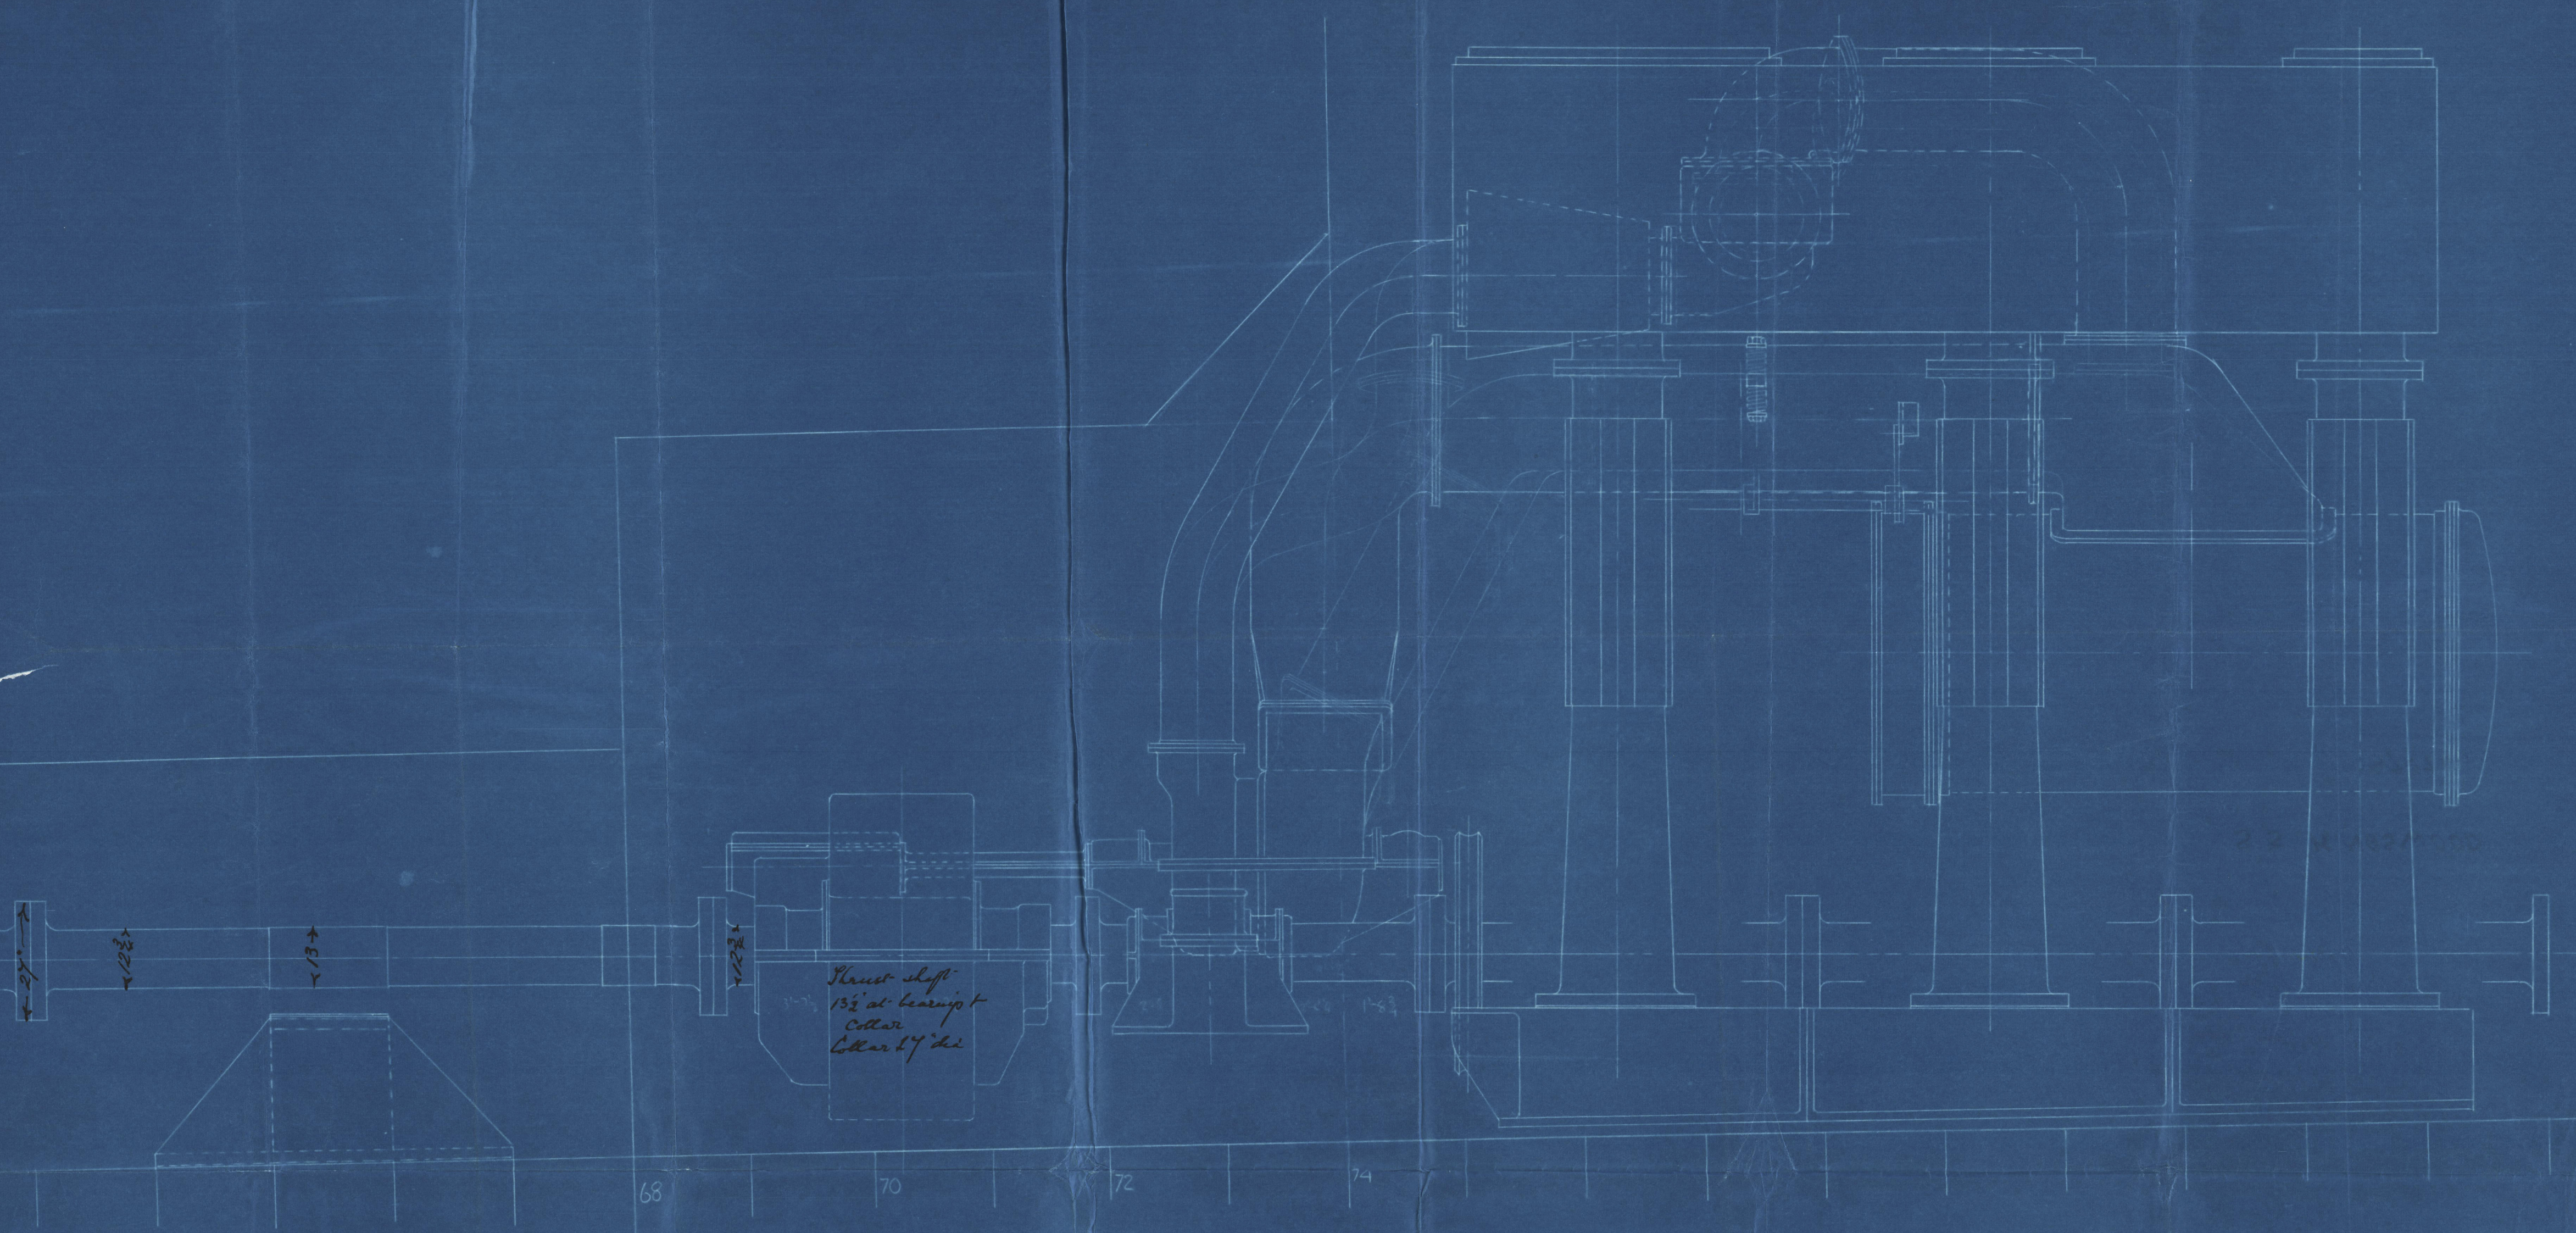

Thrust shaft
13 1/2" at bearing
collar
Collar 1 1/4" dia

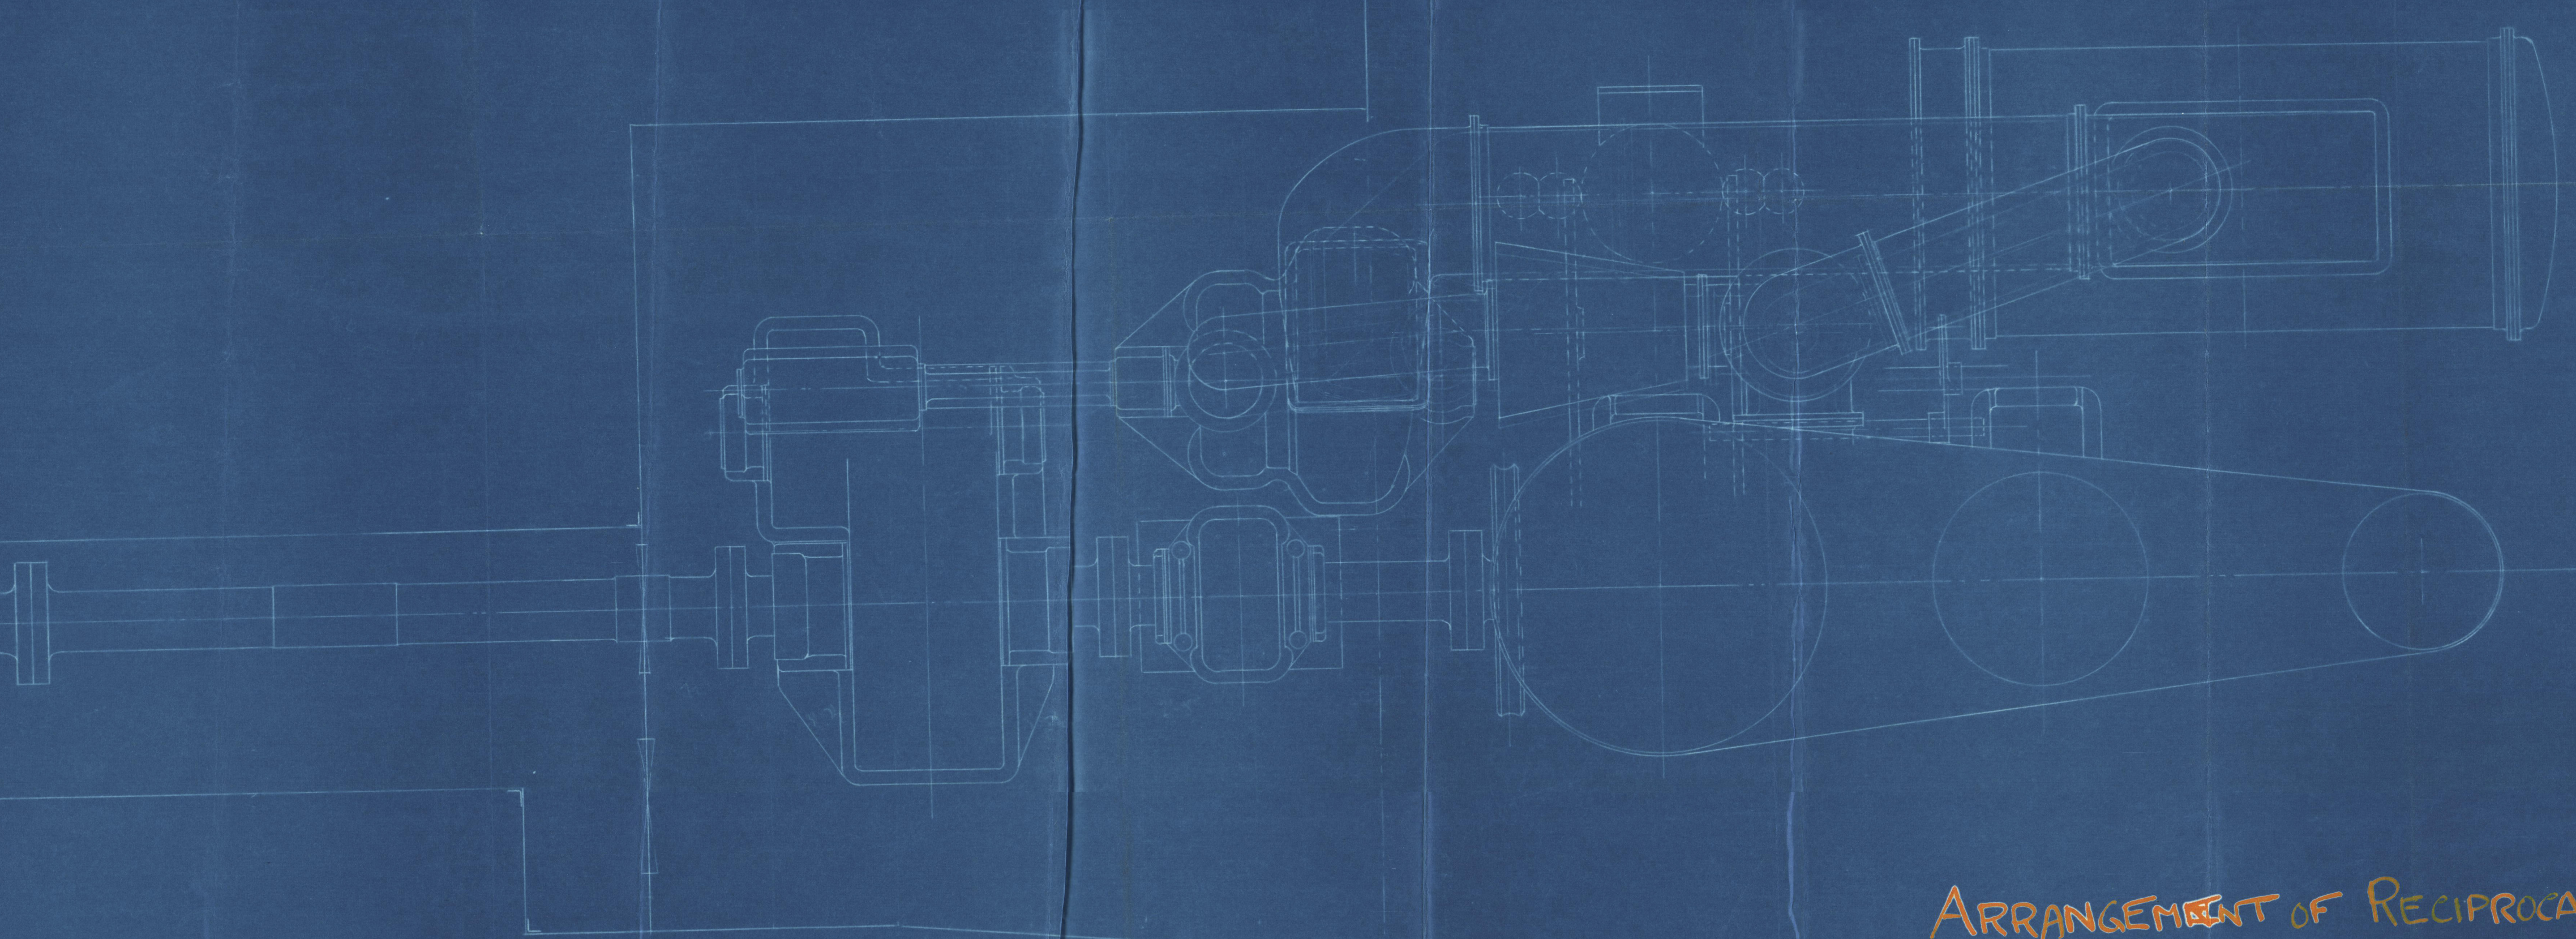

SCALE: 1/2" = 100T.

ARRANGEMENT OF RECIPROCATING ENGINE,
TURBINE & GEARING. A.D.
ENGINE NO 270. 9/5/30 E.D.

THE SHIPBUILDING
WALTON & TYNE
MAY 1930
SHIPPING
TUNING CO

R

Register
of
Inventions

110-1622

S/S "KINGSWOOD"

Machinery Arrangement
from Parsons Marine
No 240

S. S. "KINGSWOOD."
NEWCASTLE ON TYNE.

Report No. 87074.

W249-0111



© 2020

Lloyd's Register
Foundation