


15.10.28

S. S. 409. PROFILE & DECK PLANS.

DIMENSIONS - 405'-0" B.P. x 53'-6" M^{LD} x 29'-1" M^{LD} TO UPPER DECK.

SCALE $\frac{1}{8}$ " = 1 FOOT.


CLASS 100 A.I.

 

POOP DECK.


BRIDGE DECK.

FORECASTLE DECK.

 

TWEEN DECK FRAMES FITTED WHERE MARKED THIS-1" -
SEE MIDSHIP SECTION FOR POOP & FORECASTLE FRAMES.

PANTING ARRANGEMENT TO BE SUBMITTED.
PLAN OF BOTTOM STRENGTHENING FORWARD TO BE SUBMITTED.

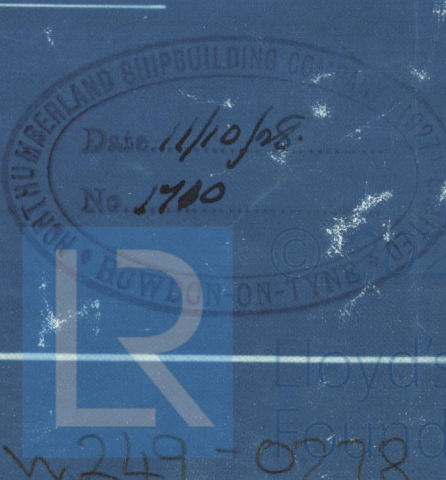

2

Profile and Deck plan


W. 409

Northumberland SBCo (1927) Ltd

S. S. Kingwood

NEWCASTLE ON TYNE.

Report No. 84177

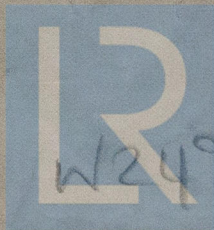

© 2020

Lloyd's Register
Foundation