
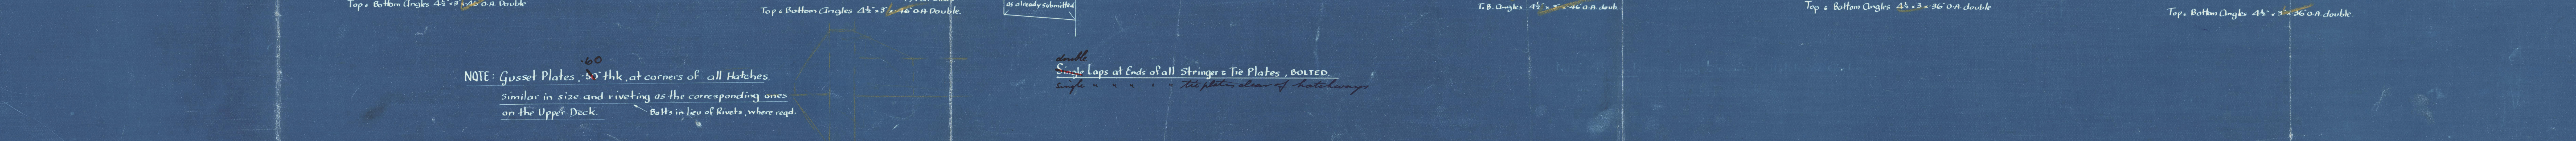
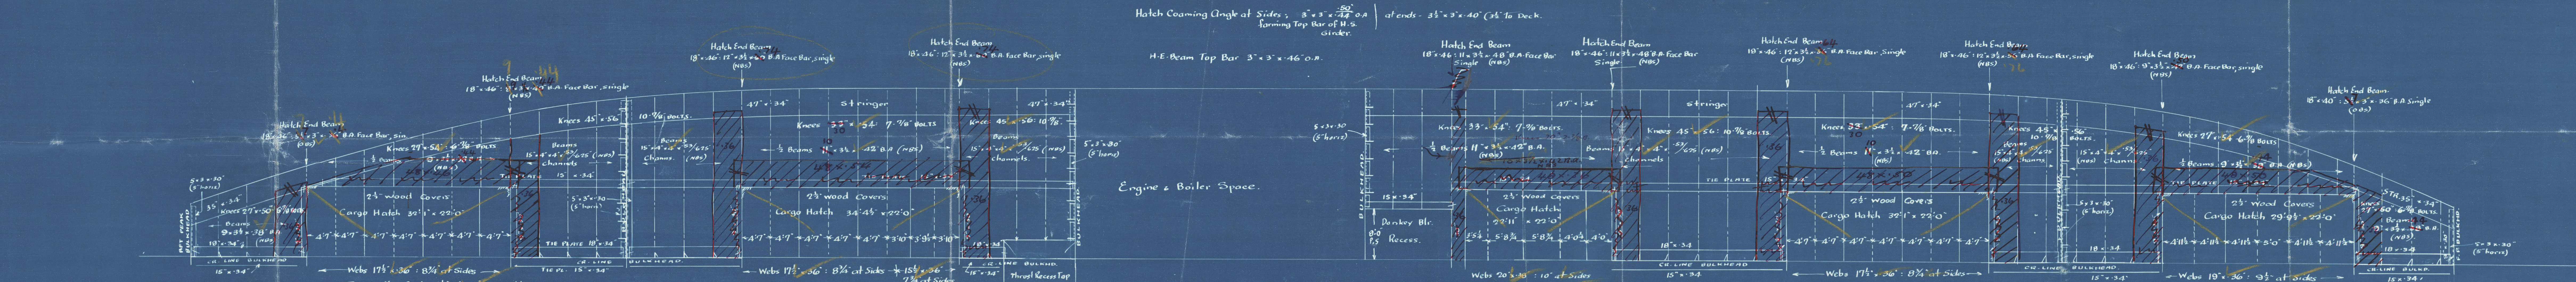
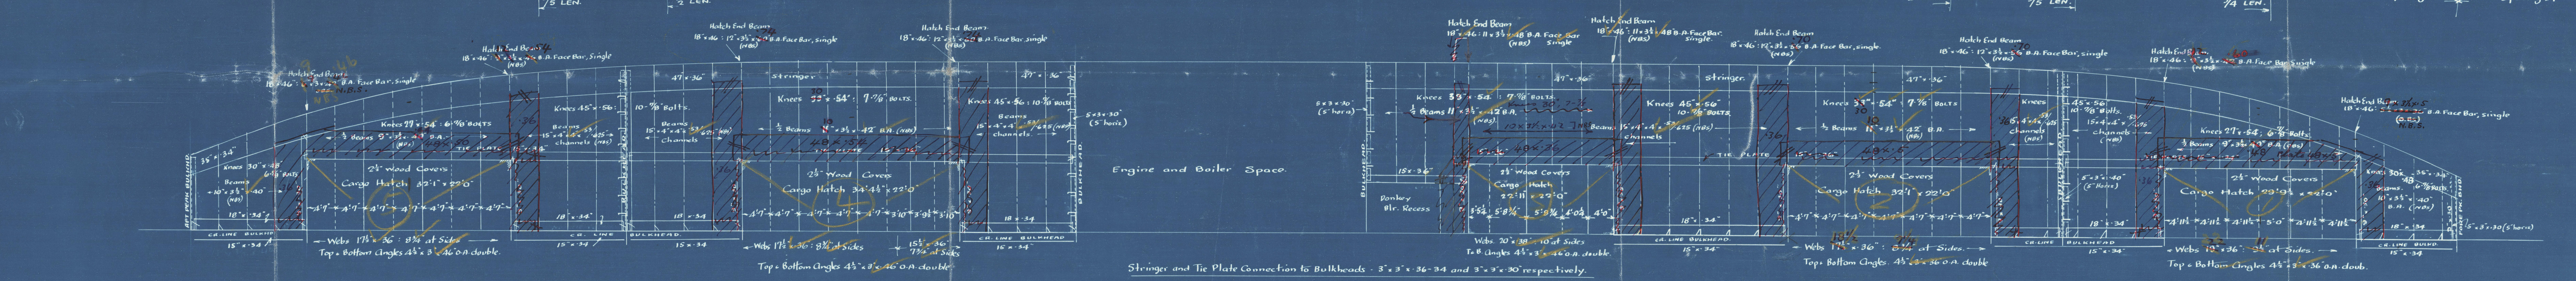


No 409.

SEMI-PERMANENT ADDITIONAL DECKS.

Scale 1/8" = 1 foot.


7/11/28.
1814.

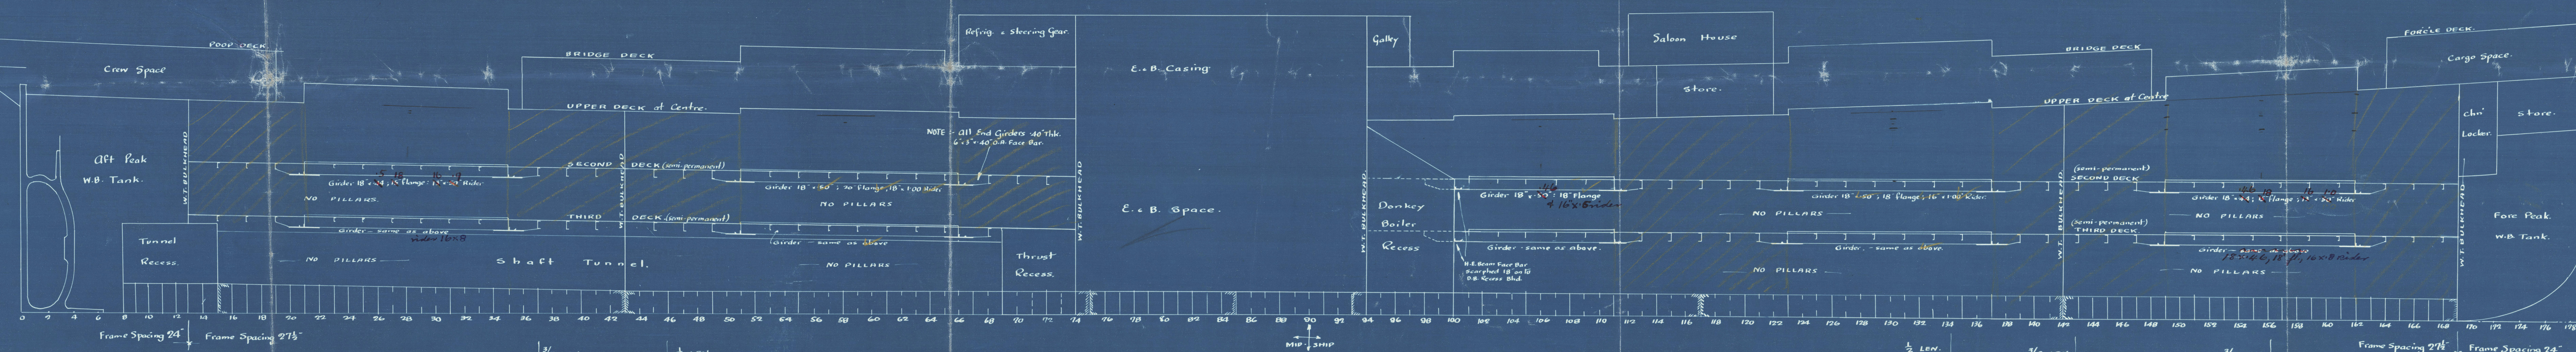

NOTE: Gusset Plates, 5/16" Hk. at corners of all Hatches. Similar in size and riveting as the corresponding ones on the Upper Deck. Bolts in line of rivets, where reqd.

MIDSHIP SECTION.

SCALE 1/8" = 1 FOOT.

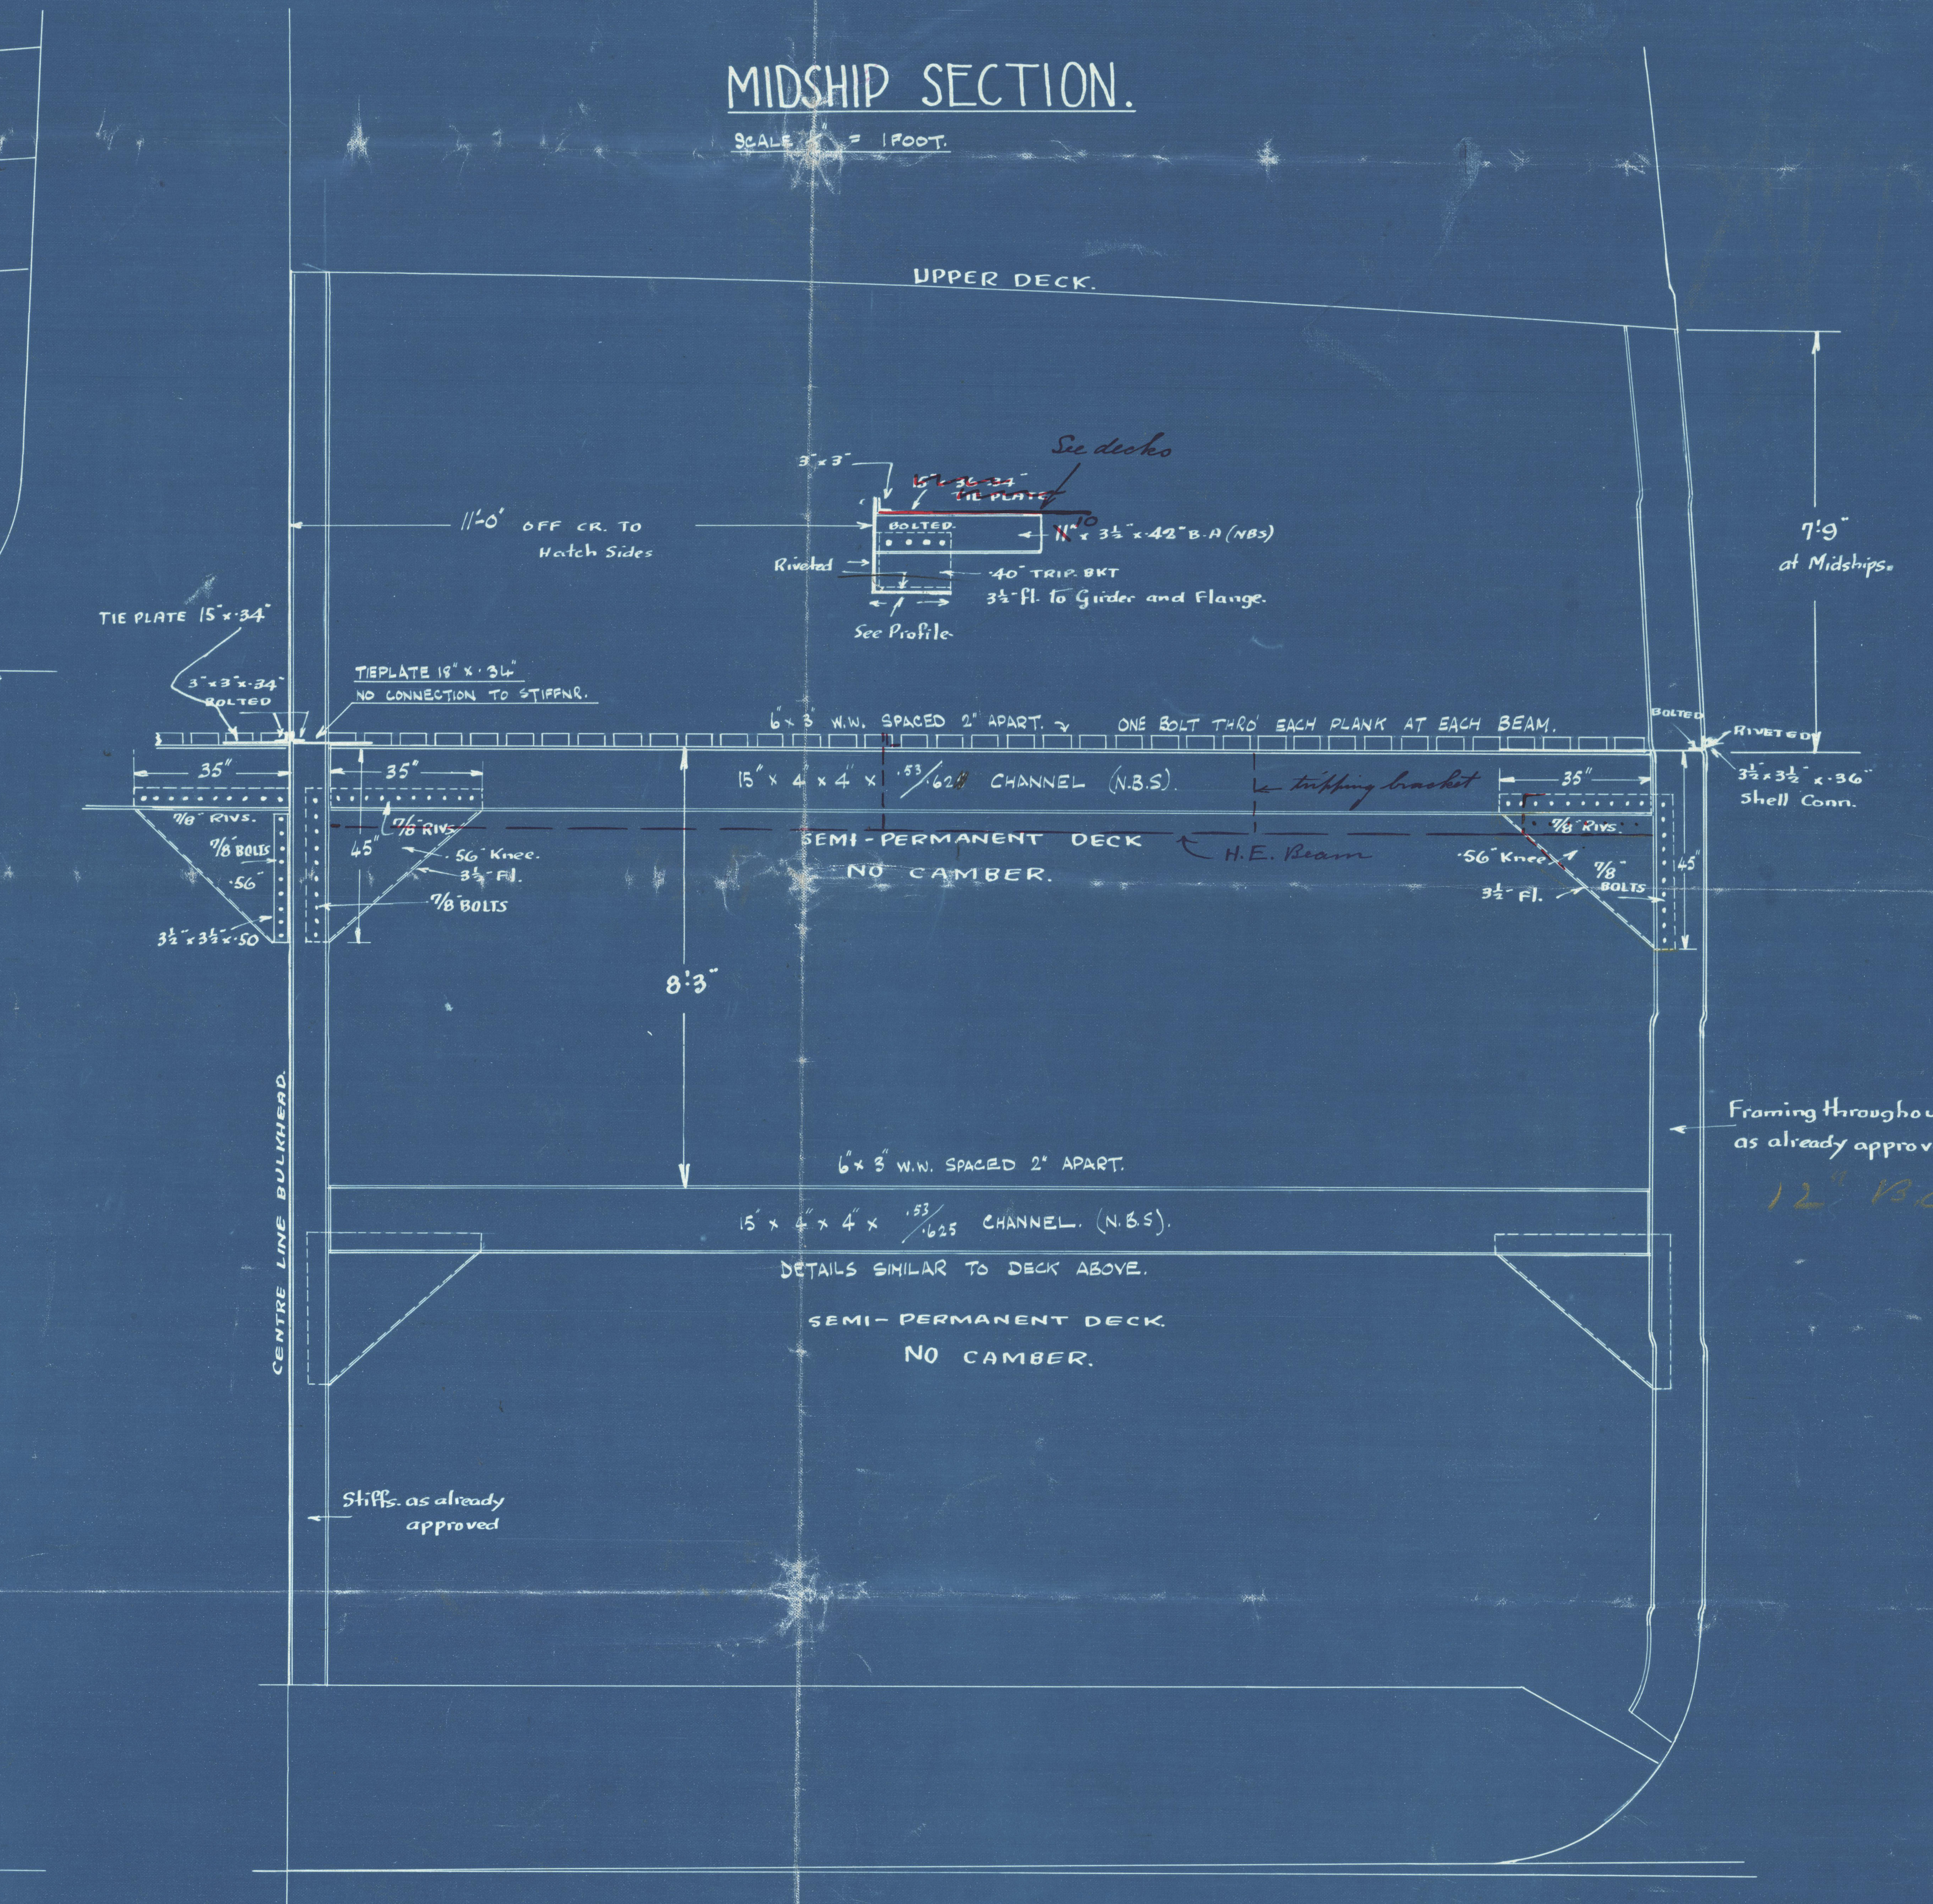

NOTE: Gusset Plates, 5/16" Hk. at corners of all Hatches. Similar in size and riveting as the corresponding ones on the Upper Deck. Bolts in line of rivets, where reqd.

12.11.28

+

Northumberland S.B. Co's 409

Proposed additional decks

S.S. KINGSWOOD

N.W.C. 84177.

~~GEN. DCX 1282~~



Office

W249



© 2020

Lloyd's Register Foundation