




Nº 409.

SEMI-PERMANENT ADDITIONAL DECKS.

Scale 1/8" = 1 foot.

Officer

All bolts to be fitted

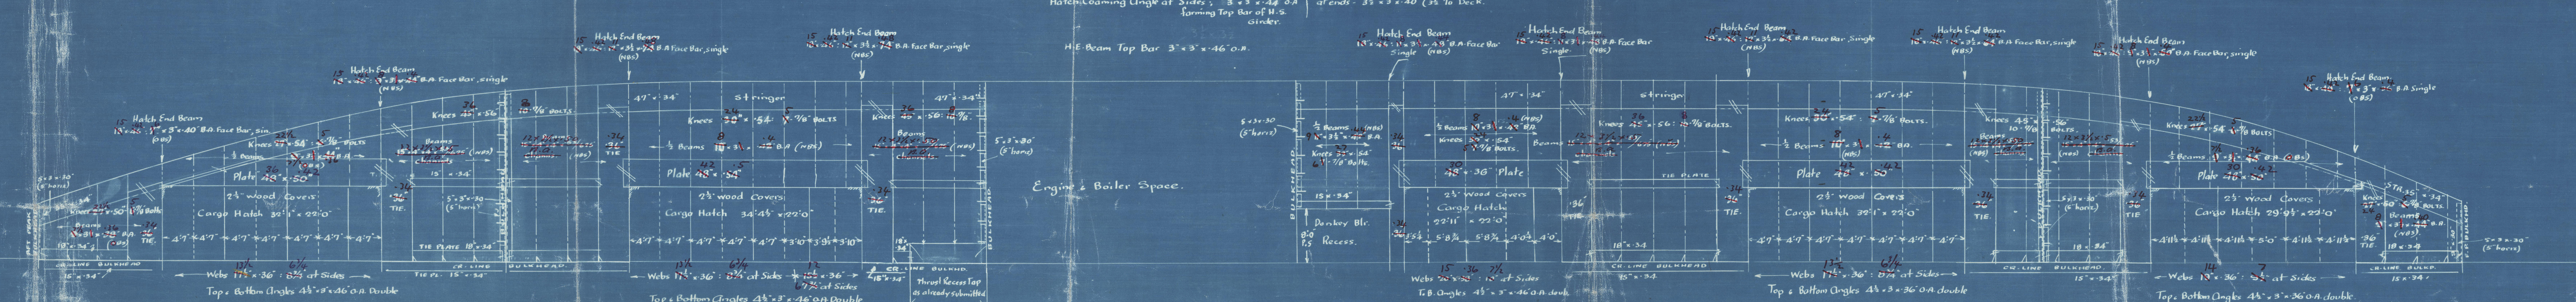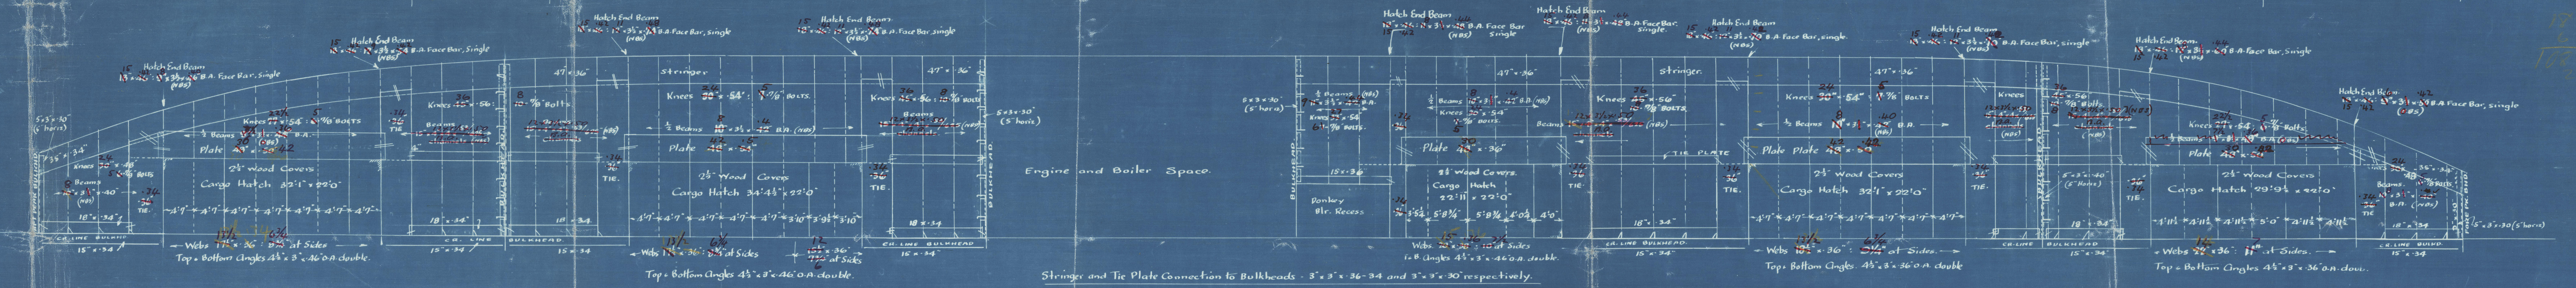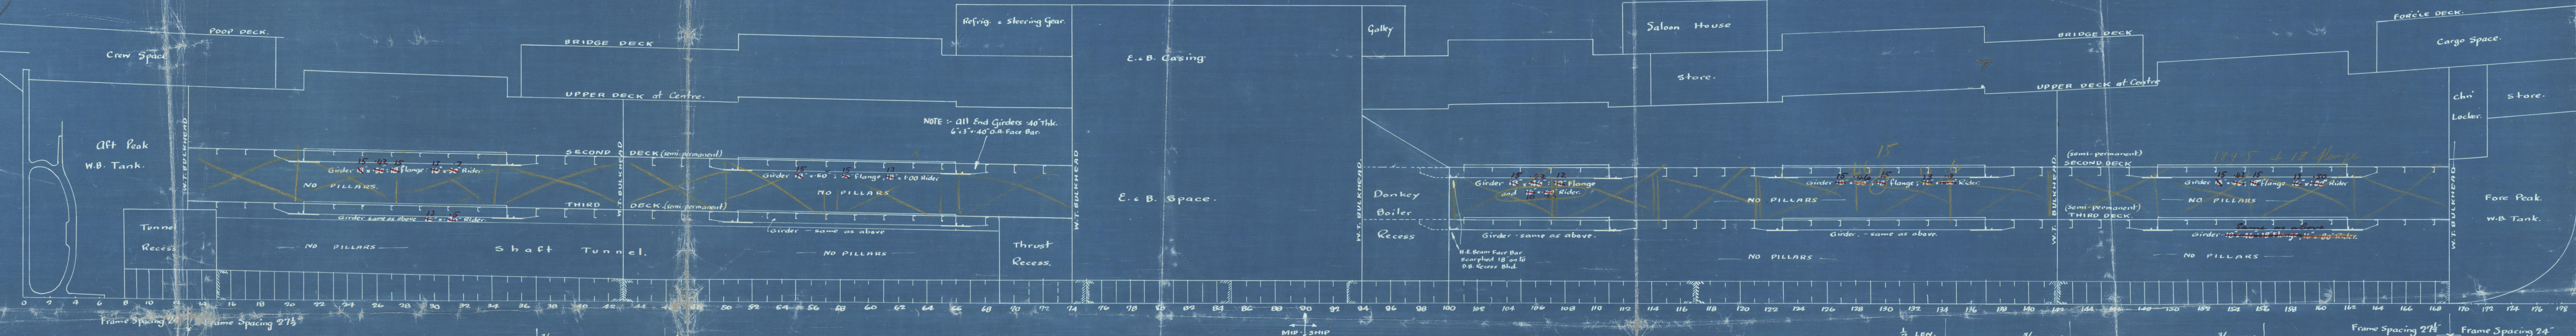


NOTE: Gusset Plates, 60" thick, at corners of all Hatches, similar in size and riveting as the corresponding ones on the Upper Deck.

Double Laps at Ends of all Stringers, Tie Plates, BOLTED. Single - - - - - Tie Plates clear of Hatches.

MIDSHIP SECTION.

Scale 1/8" = 1 foot.

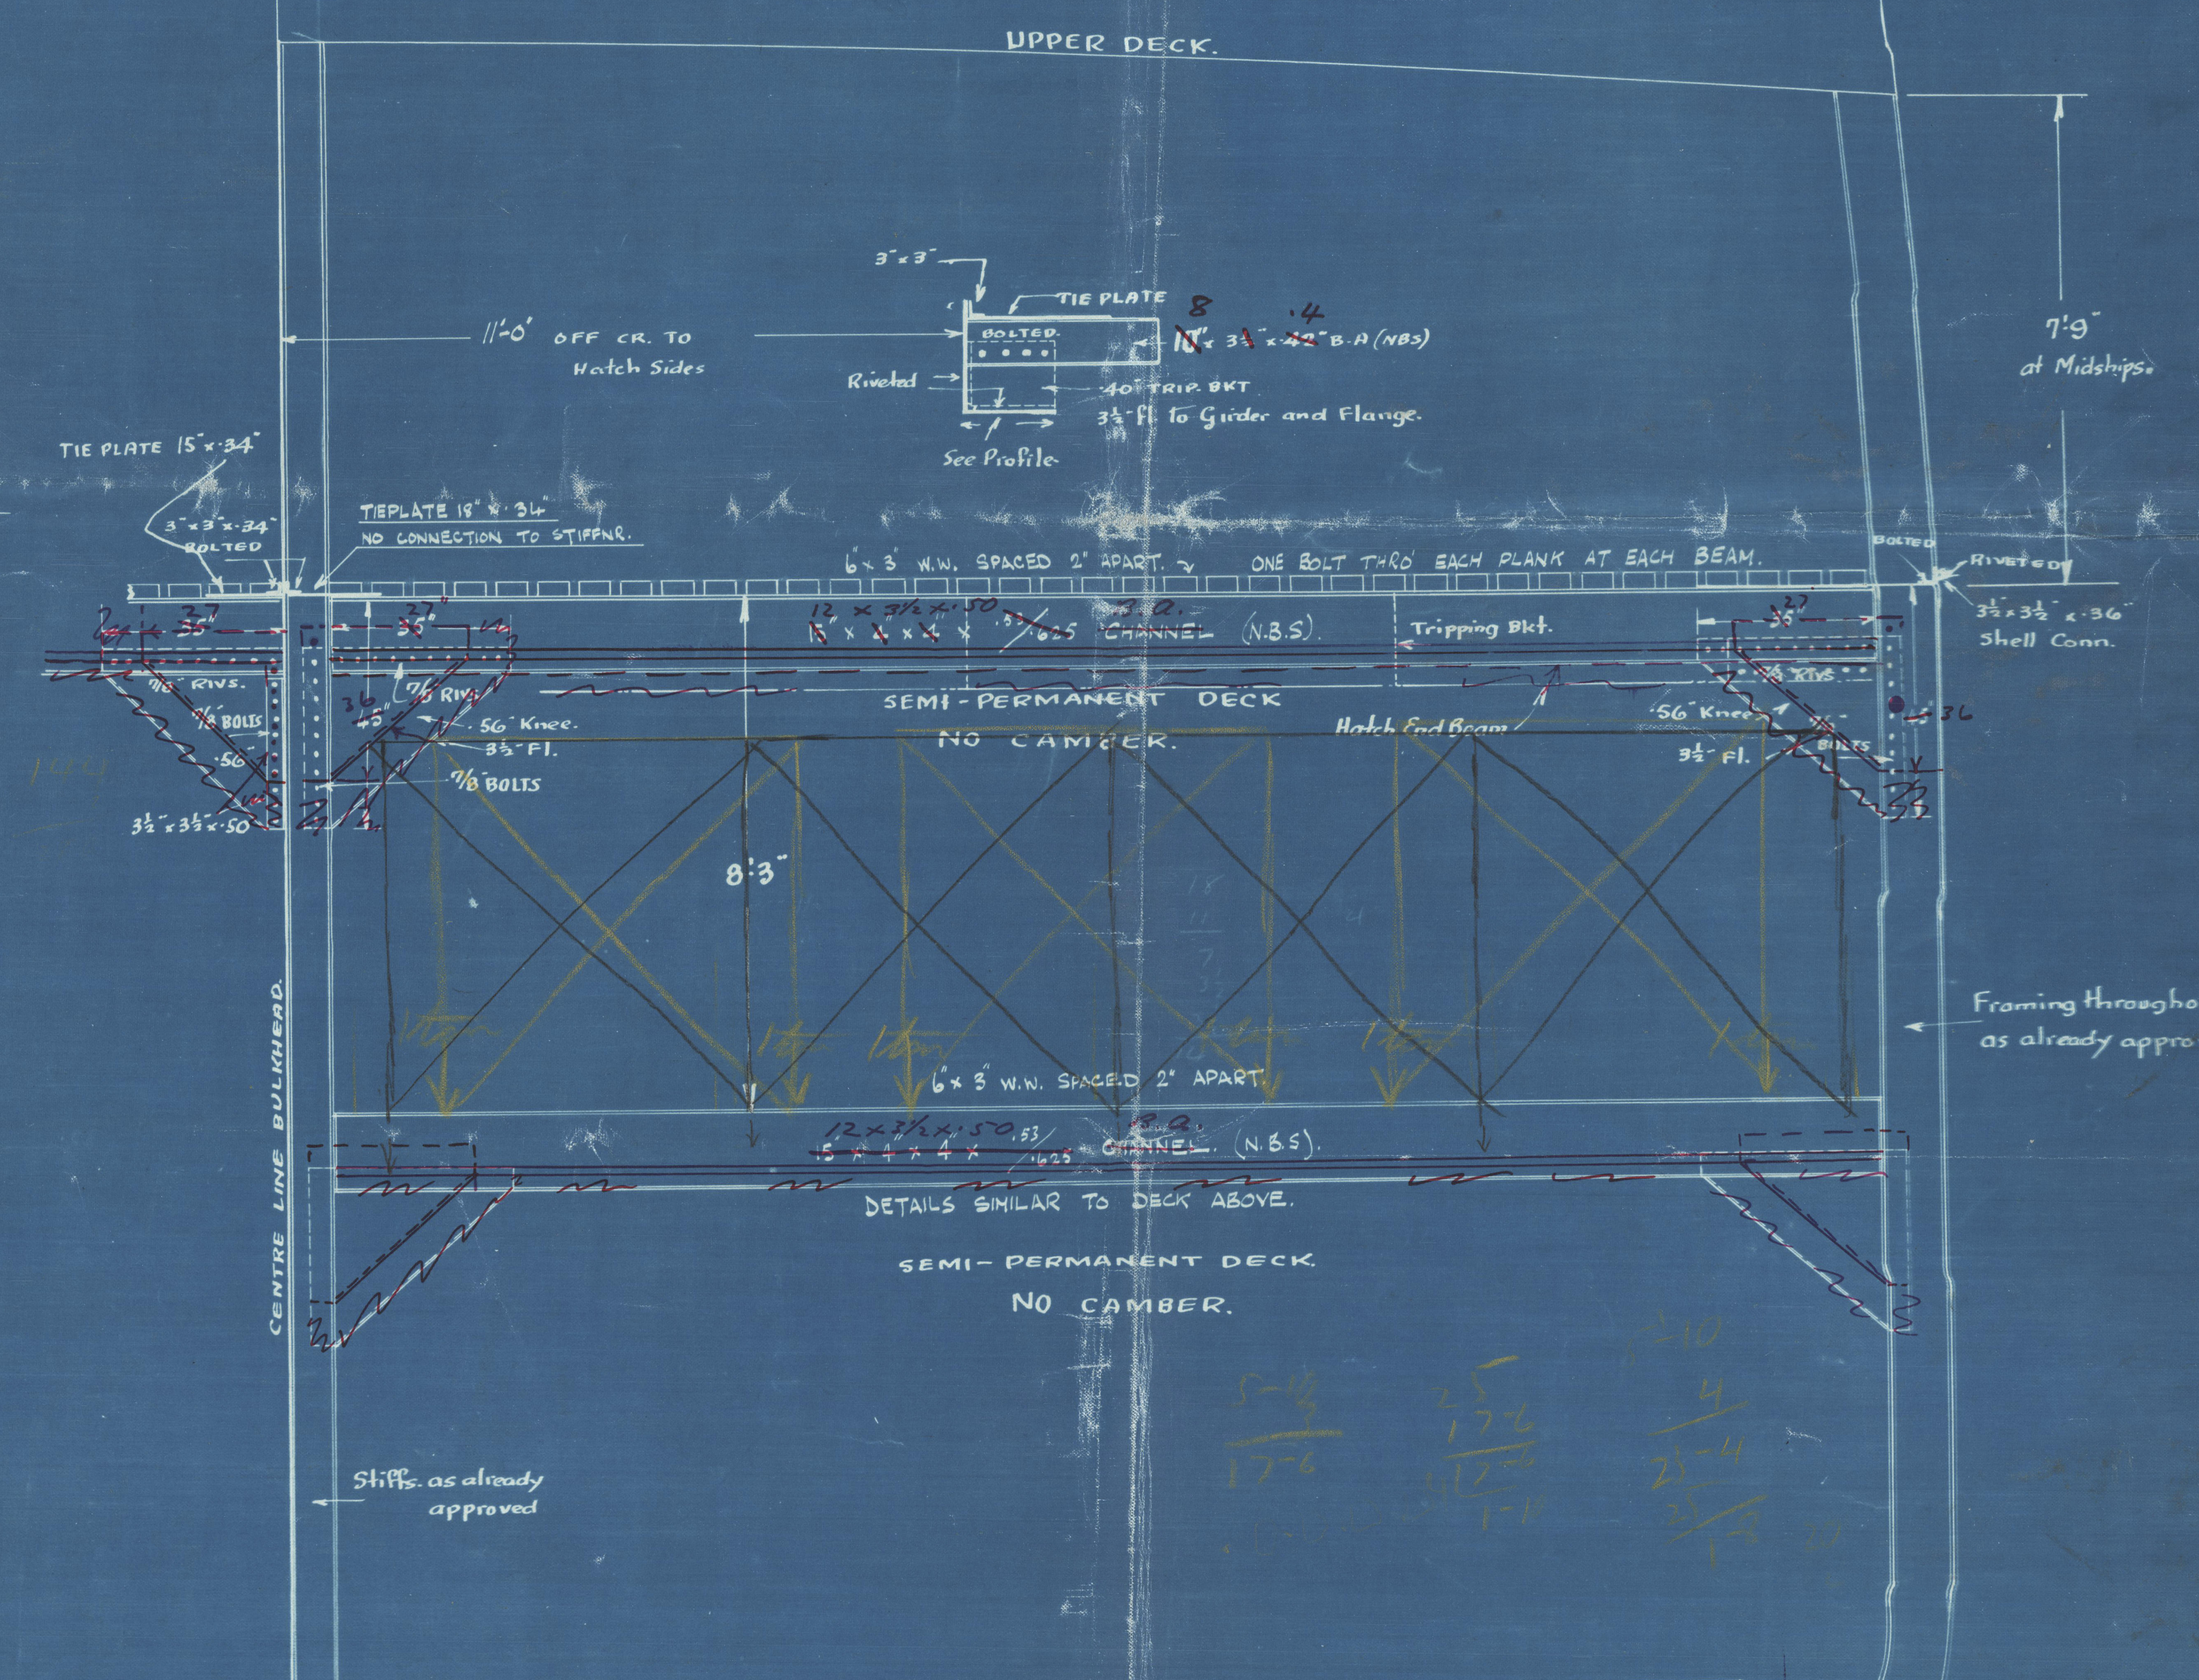

19.11.28
WJ
824

W249-0283

Northumberland S.B. Co.

No 409

SS. "Kingswood"

NW. 84177.

Amended plan of
temporary docks

~~GEN. BOX NO 282~~

W249 - 0283

W. H. H. H.



© 2020

Lloyd's Register
Foundation