


# SHIP No 213.

## DIAGRAM OF ELECTRIC LIGHT WIRING & SWITCHBOARD.

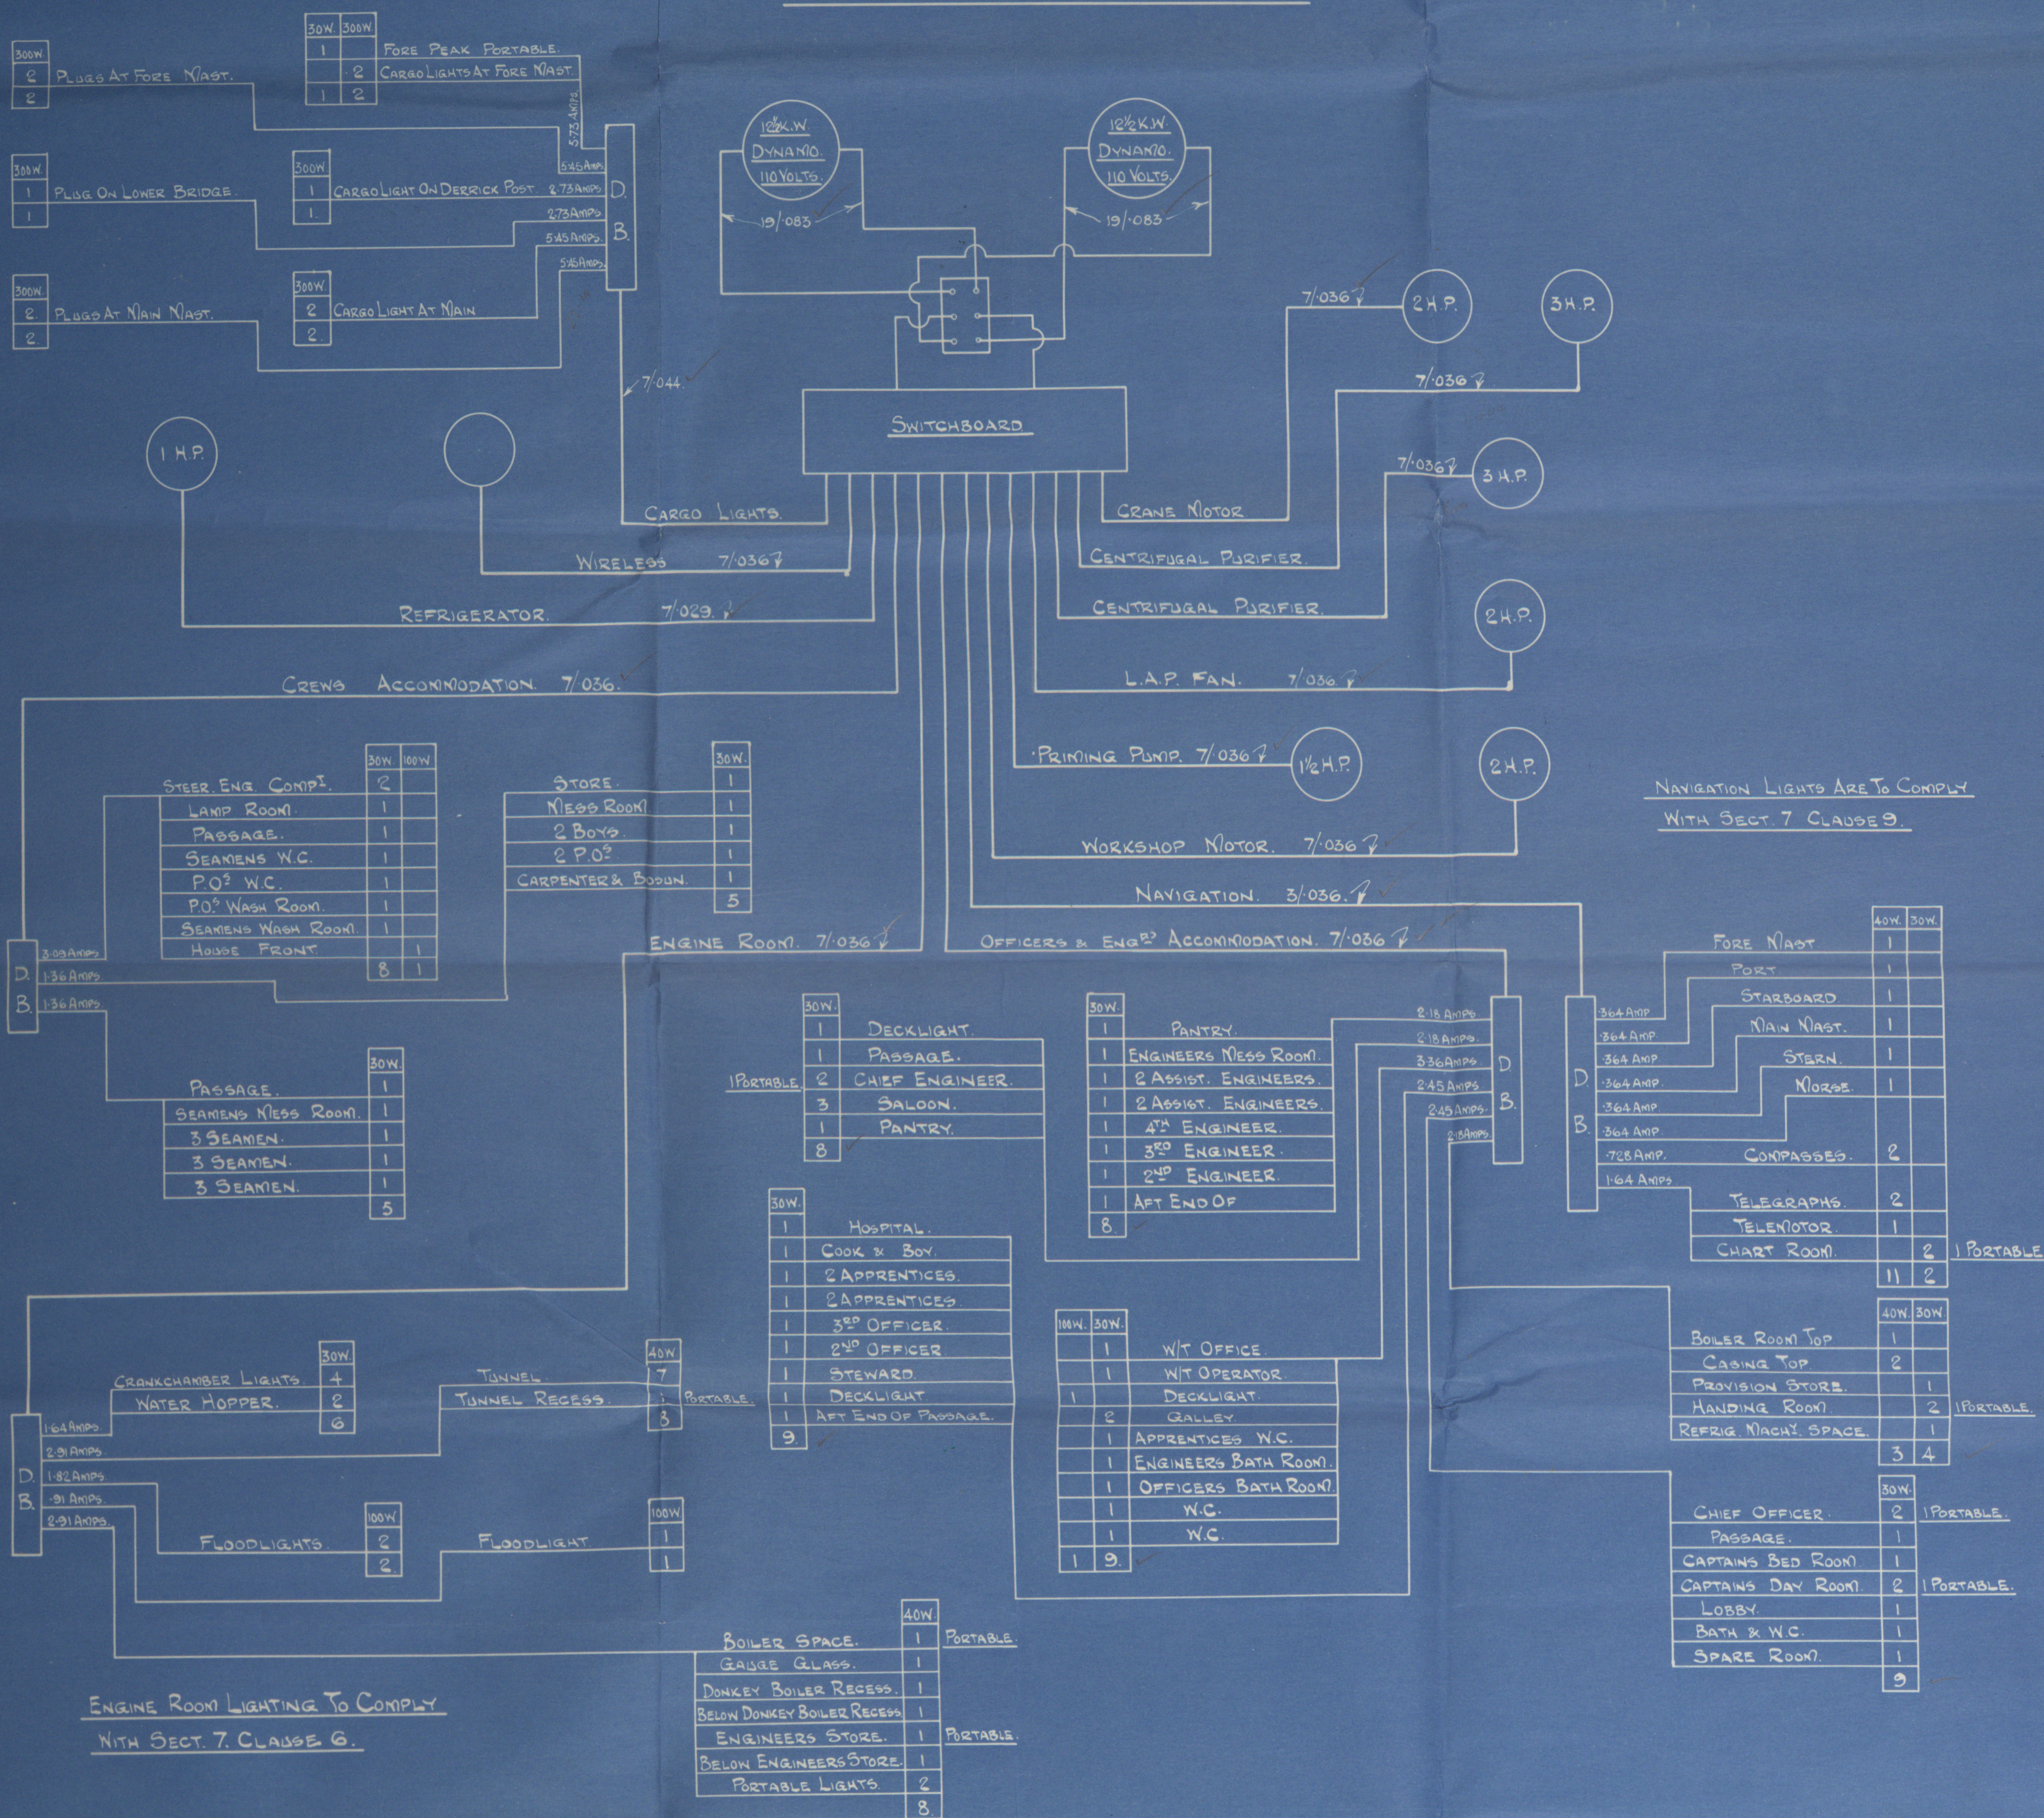

CABLES IN MACHINERY SPACES, GALLEYS, LAUNDRIES, BATHROOMS & LAVATORIES OR WHERE UNAVOIDABLY EXPOSED TO THE WEATHER OR THE ACTION OF SEA WATER ARE TO BE LEAD COVERED OR RUN IN CONDUIT. SECT. 6 CLAUSE 3(a)

SECTIONAL AREAS OF CABLES TO BE IN ACCORDANCE WITH SECT. 4 & TABLES 1 & 3.

SUBDIVISION OF CIRCUITS TO BE IN ACCORDANCE WITH SECT. 7, CLAUSE 1.

PLAN No P. 29.



LONDON COPY.




The Burntisland S. B. Co. Ltd.'s

Yard No. 213

Diagram of Electric Light  
Wiring.

Mr. Derrymore

1th Rept No. 19520.

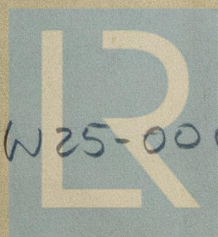

© 2019

W25-0004

Lloyd's Register  
Foundation