
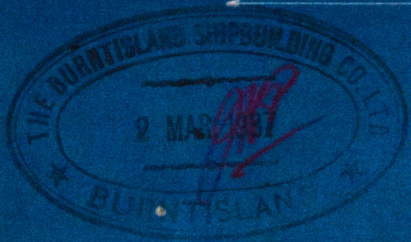
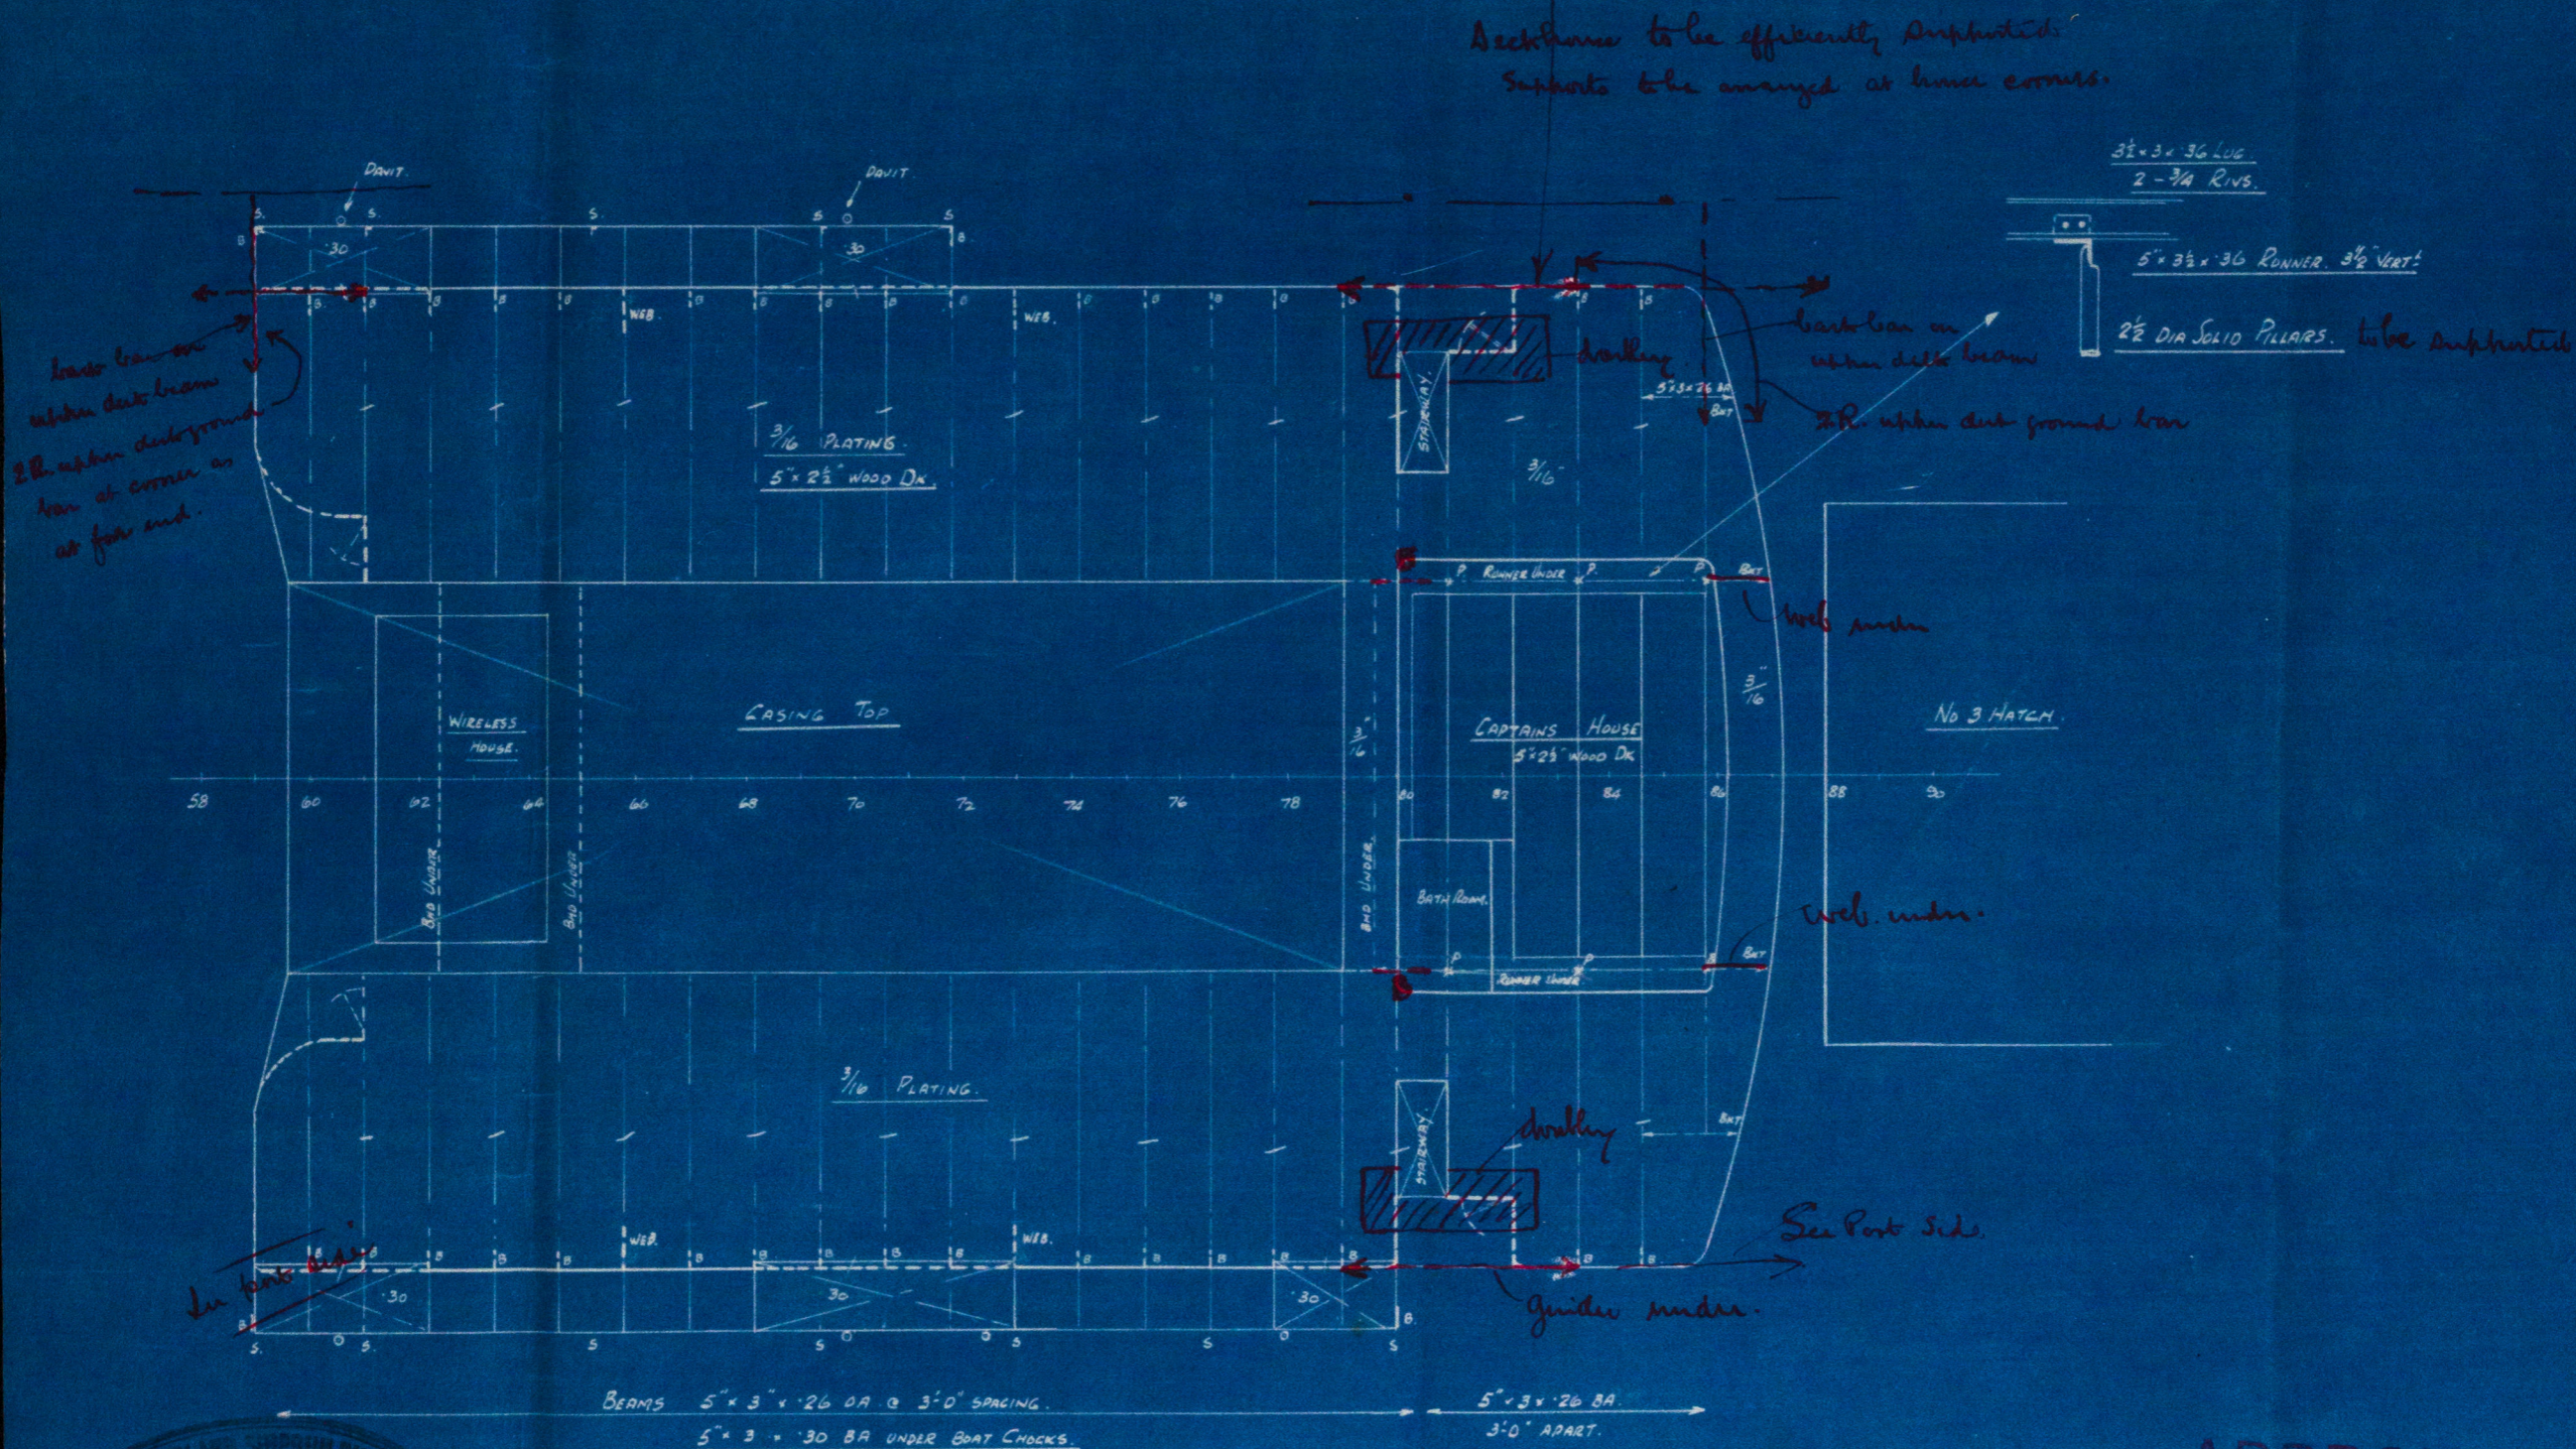
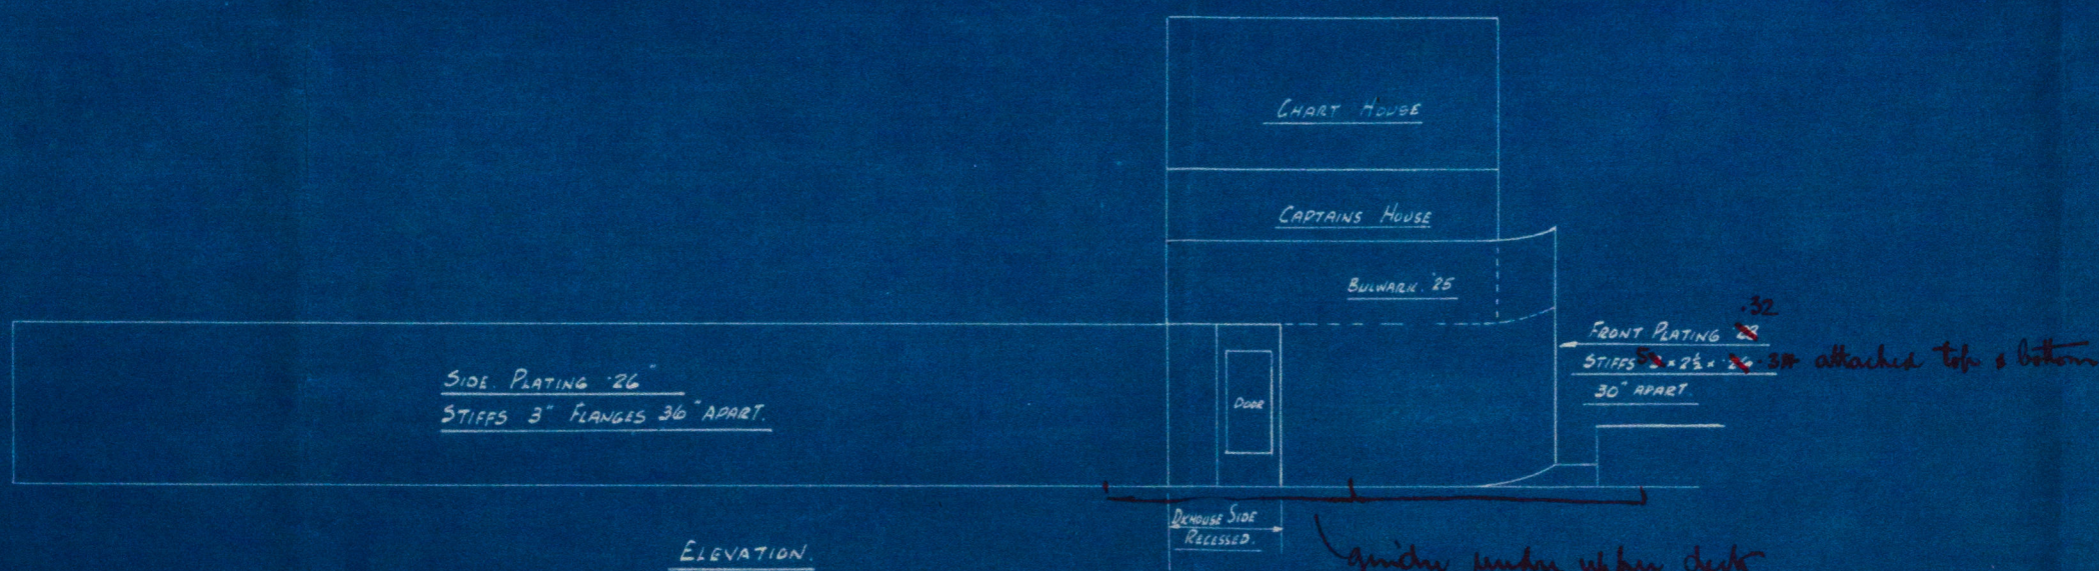


# SHIP NO 213 MIDSHIP DECKHOUSE

SCALE  $\frac{1}{8} = 1 \text{ FOOT}$

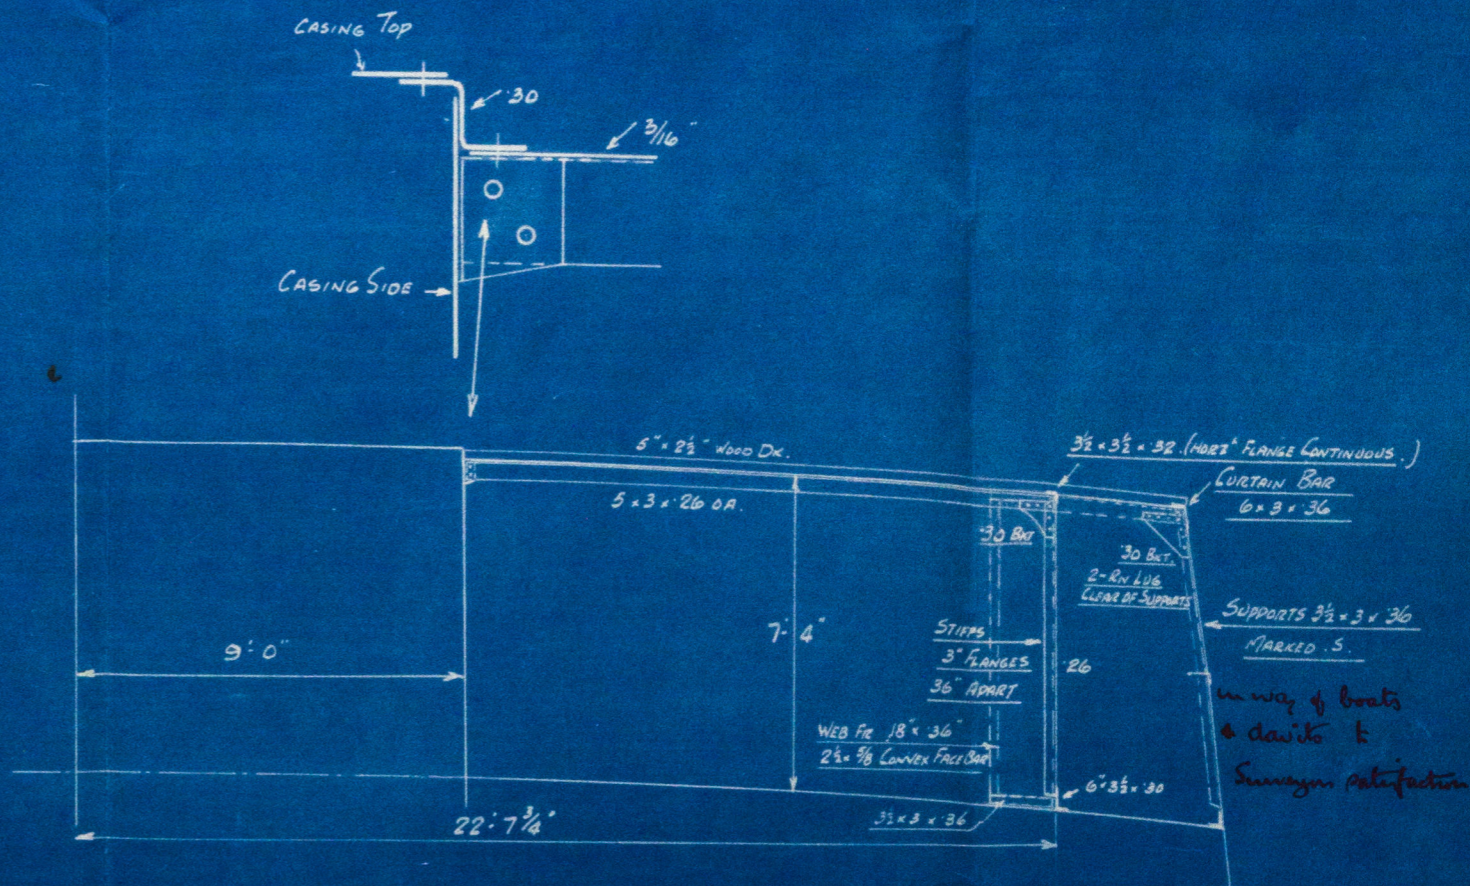

PLAN NO P.15.

APPROVED  
LLOYD'S REGISTER OF SHIPPING  
H. H. H. H.  
DATE 10/3/37  
Foundation

WRS-0070

Burnt Island SBCFA  
No 213

---

Midship Deckhouse

---

m. v. "Werrymore"

Lth. Rpt. No. 19520

W25-0070

a



© 2019

Lloyd's Register  
Foundation