


SCALE $\frac{1}{2}$ " = ONE FOOT.

4. 12. 15.
5. 1. 16.
10. 1. 16

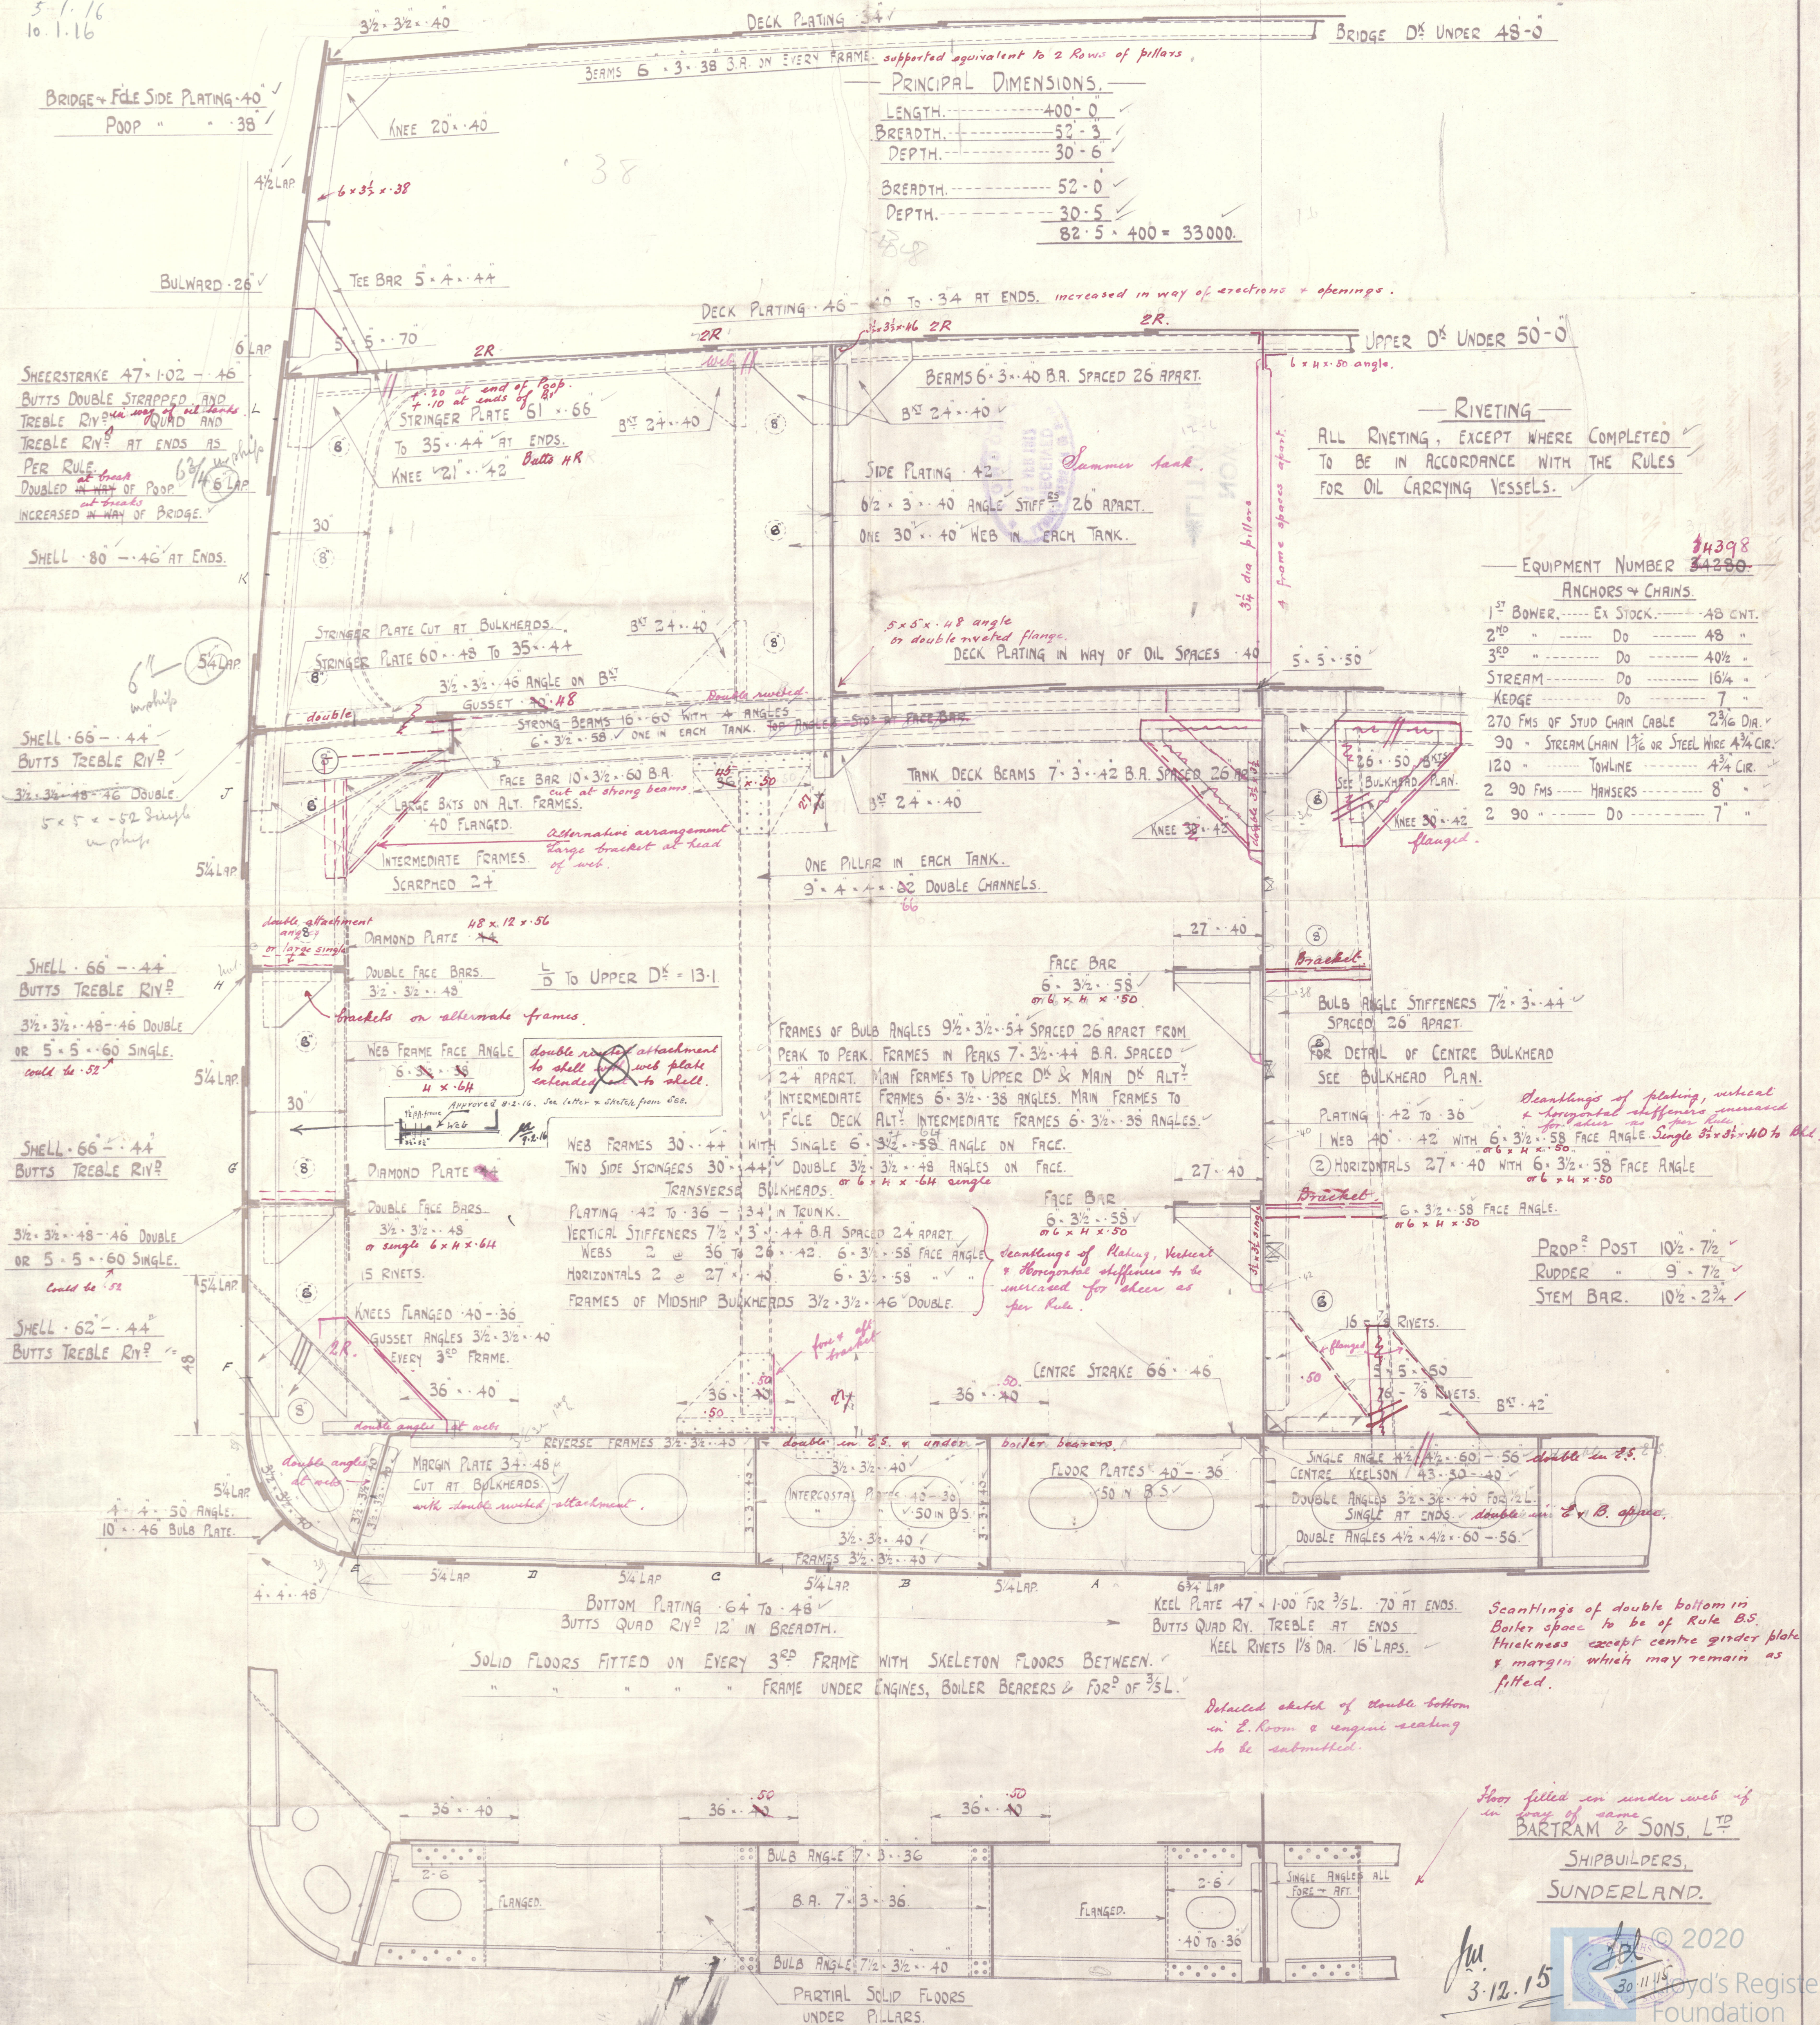


SUNDERLAND

Messrs BARTRAM & SONS L^d

AMENDED MIDSHIP SECTION
AS OIL CARRIER.

No. 238

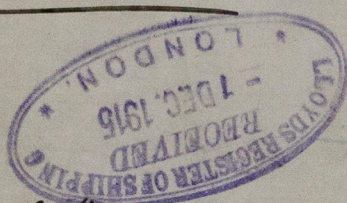

S.S. "OLEARY"




Converted Oiler

ex. Dockleaf^s
now "LITIOPA"

SUNDERLAND RPT. No. 26955

NOW

✻ LITIOPA ✻

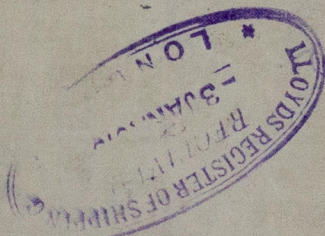

LR

X250-0176

Lloyd's Register
Foundation