


The suction valves or cocks at all oil fuel & cargo oil storage tanks, other than double bottom tanks, to be fitted & controlled as per Section 20 D, Clause 6(a) of the Rules.

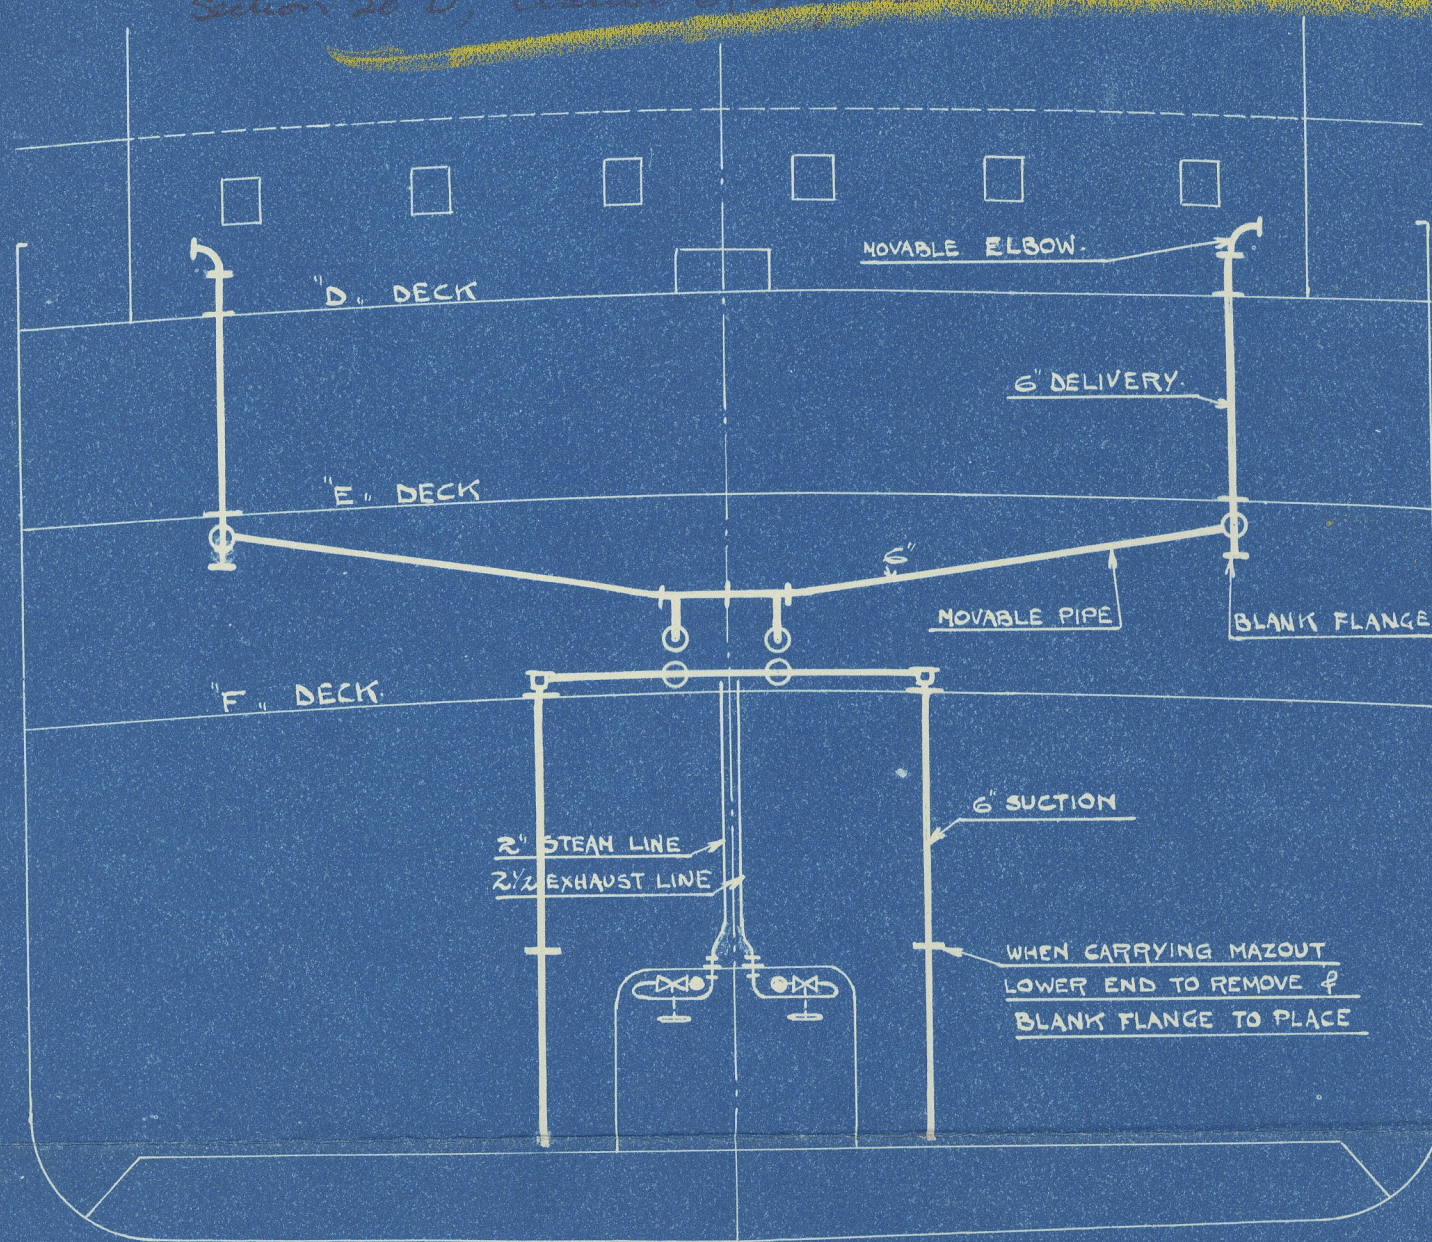

The flash point of the oil fuel to be above 100°F and the flash point of the cargo oil to be above 100°F. To be complied with as far as they are applicable.

Aut report  
No. 18750

5/5" LEOPOLDVILLE

FILLING & DELIVERY PIPES FOR PALM OIL TANKS

SCALE 1/100

7-3-33

5-2  
No 1495

W251-0032