


SCHEME OF PALM OIL PUMPING
ARRANGEMENT.

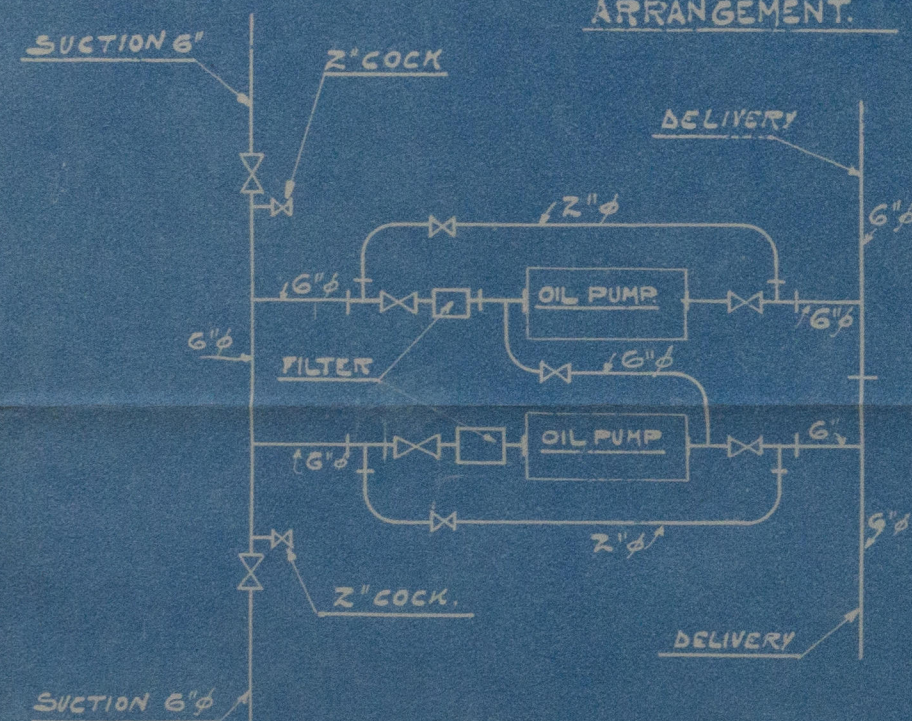

S/S "LEOPOLDVILLE"


Antwerp Report No. 18759

INSTALLATION OF PALM OIL PUMPS.

Scale: 1/20.

The suction valves or cocks at all oil fuel & cargo oil storage tanks, other than double bottom tanks, to be fitted & controlled as per Section 20 D, Clause 6(b) of the Rules

The flash point of the oil fuel to be above 150°F. and the remaining requirements of Section 20 D, Clause 6(b) (1932-33) to be complied with so far as they apply.

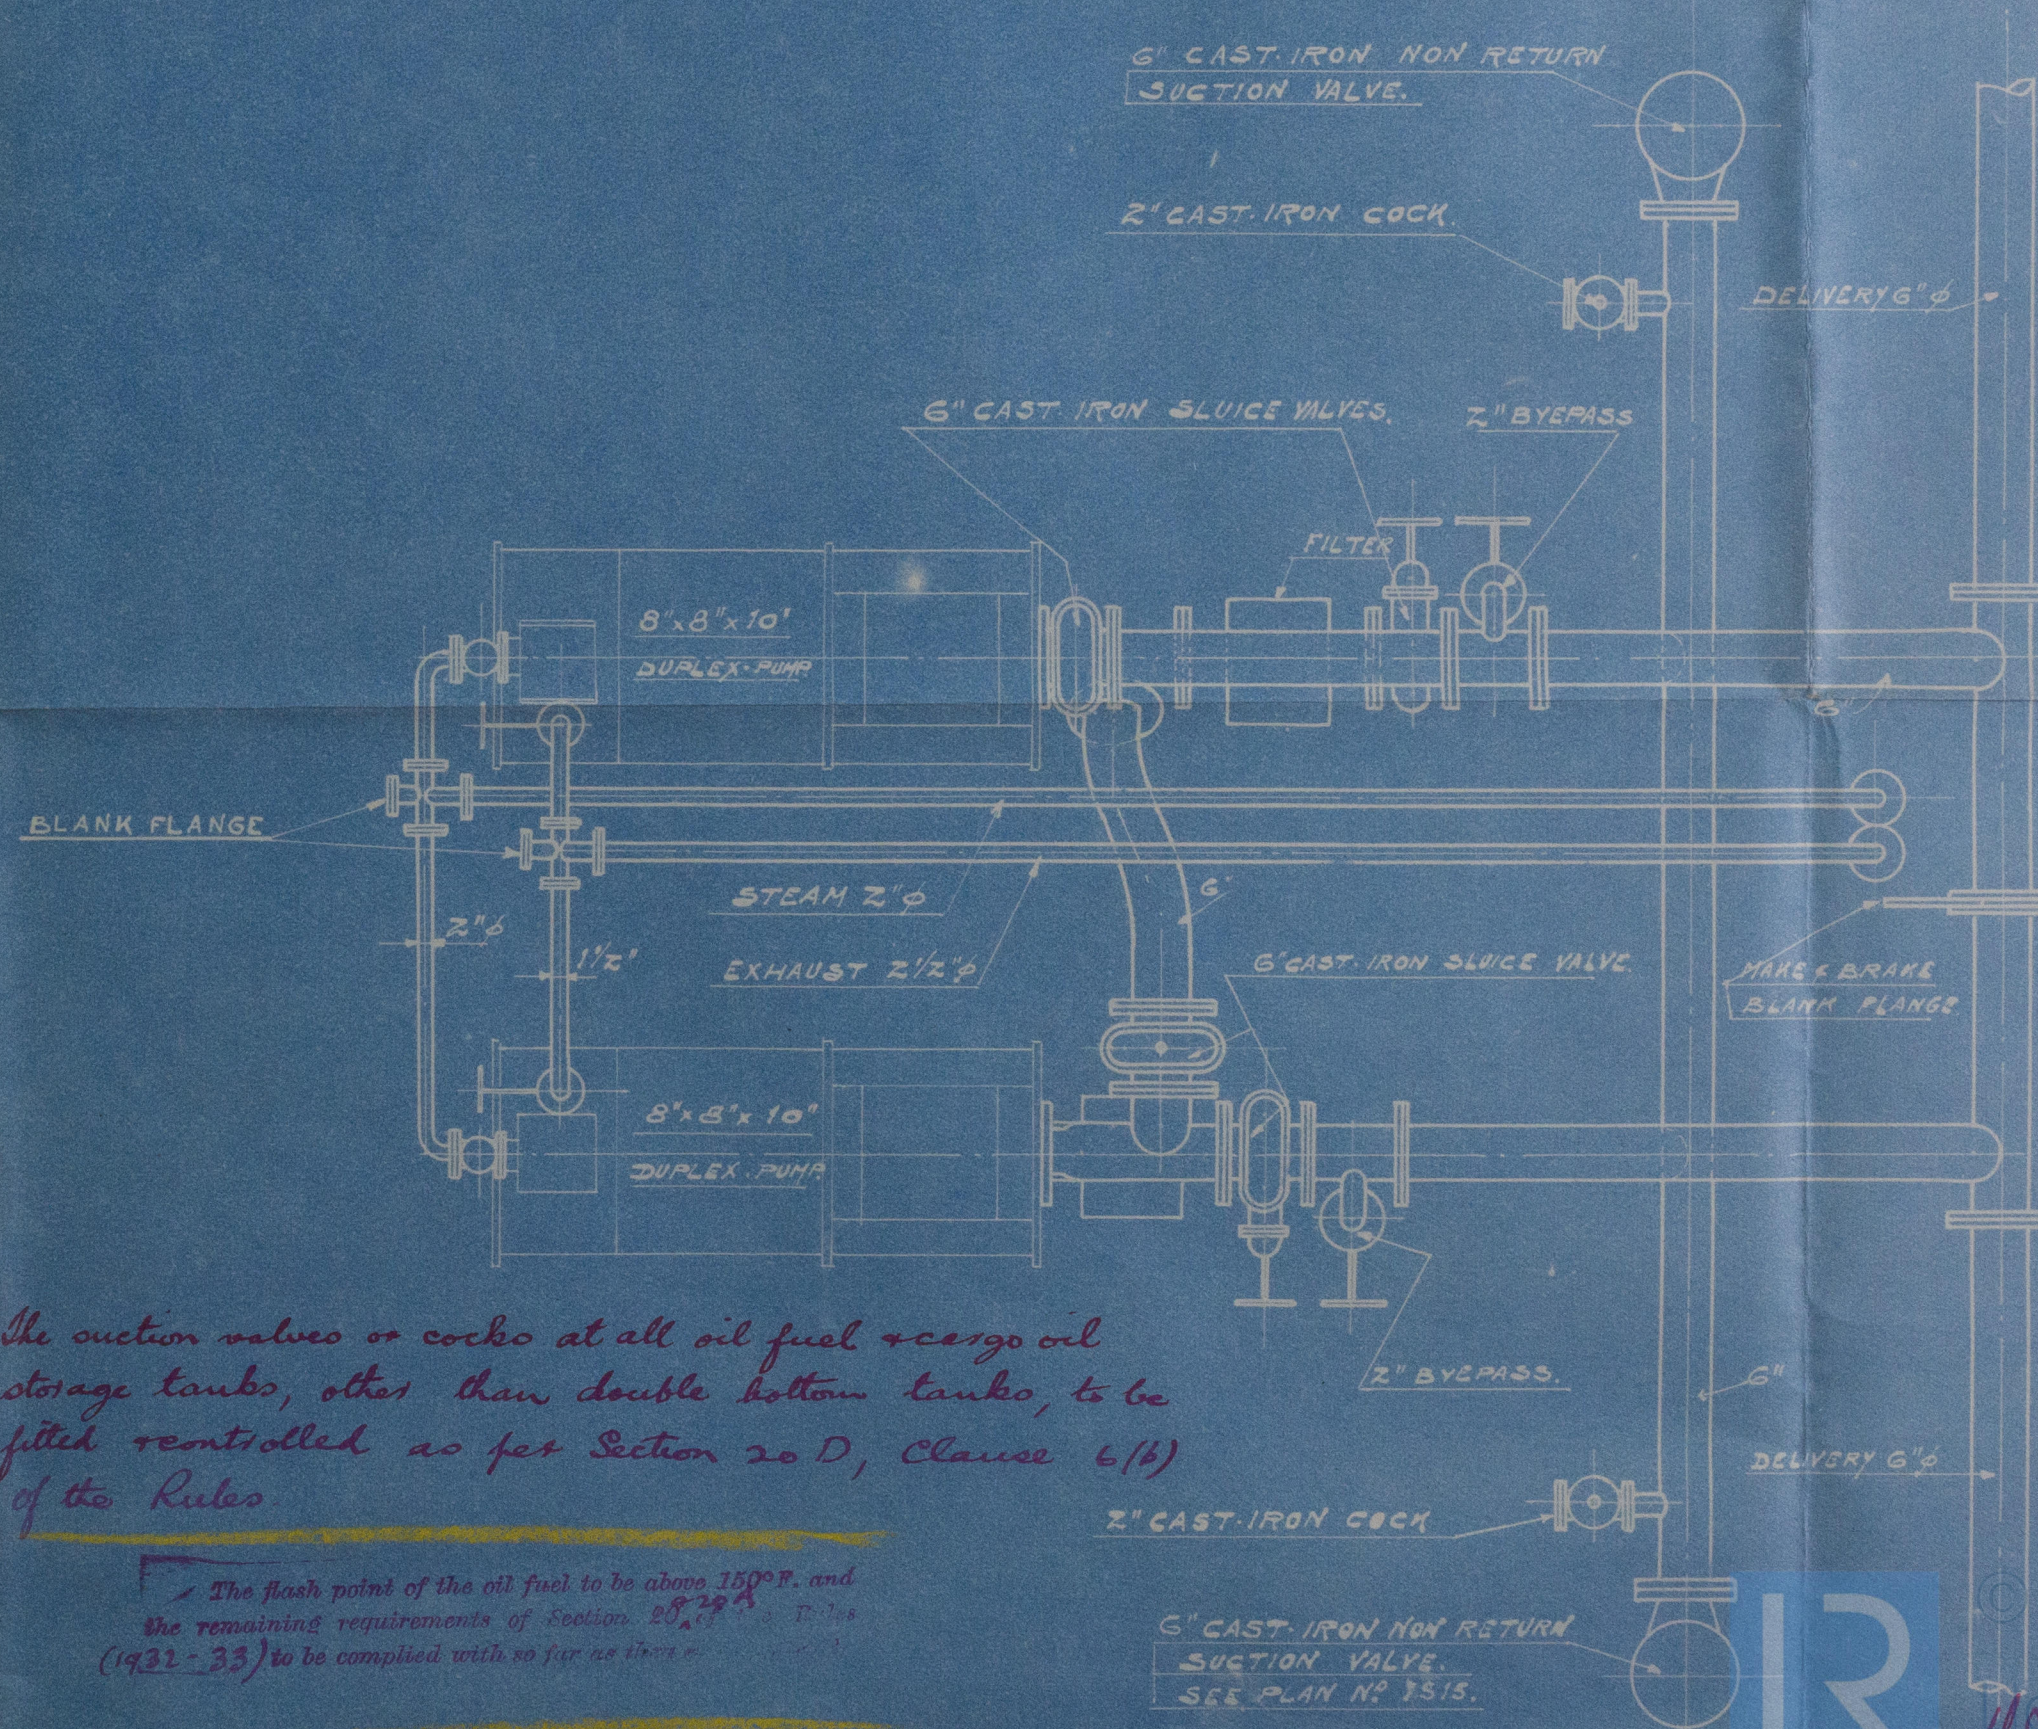

Nº 1514. 9C 3.

8.3.33

W251-0033

R

© 2013 Lloyd's Register Foundation