


5 o'clock

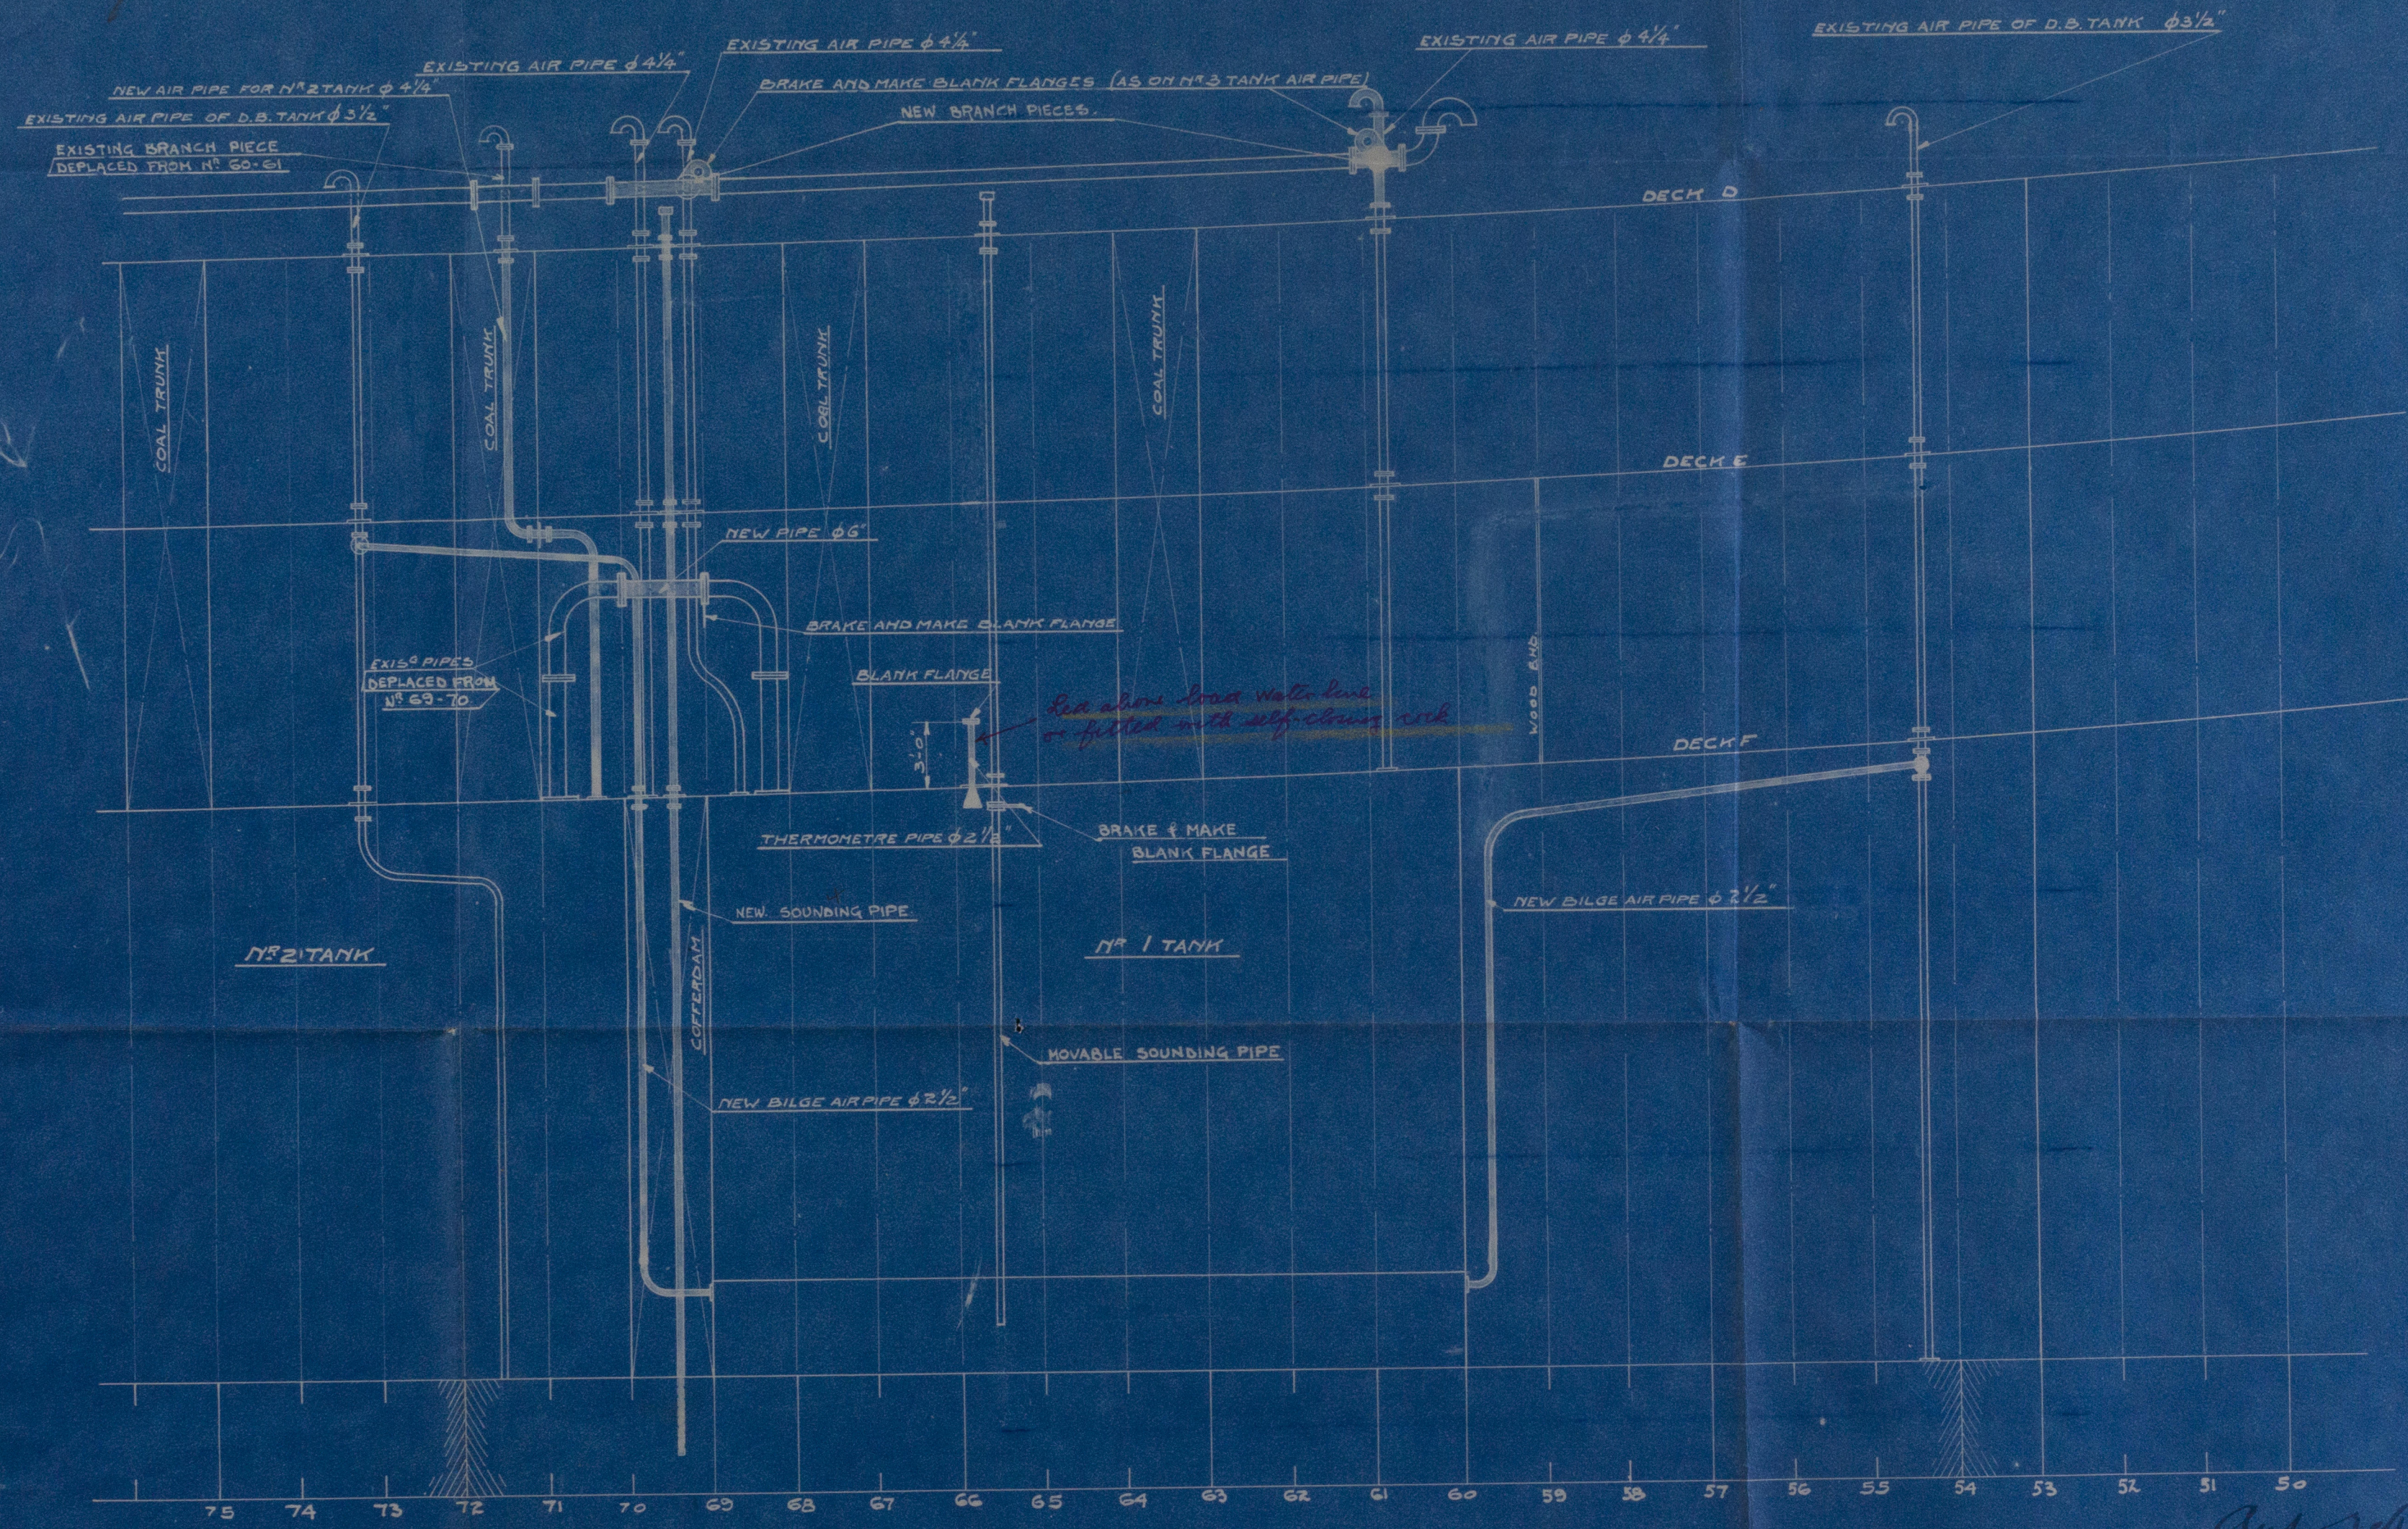

London
B.W.

The flash point of the oil fuel to be above 150°F. and the remaining requirements of Section 20 of the Rules (432.3) to be complied with so far as they are applicable.

100.13
3/3/33

Aut. rept. No. 18753
S/S "LEOPOLDVILLE"

ALTERATIONS ON AIR-OVERFLOW & SOUNDING PIPES

S.C. 2.

SCALE 1/50

20-2-33

N° 1502

*Height of air pipes not altered
Scantlings of tanks
not affected.*
D.F.
11/3/33

1251-0036