


5/8" LEOPOLDVILLE Aut. Vh  
PROPOSED ALTERATION ON BILGES No 18753  
IN NO 1 MAZOUT OR PALM OIL TANK

*Suggest amendments  
on this copy  
B.V.N.*


*Scale 1/10*

1<sup>ST</sup> PROPOSITION  
INDEPENDENT DRY BILGES

NOTE - AIR-BILGE SUCTION AND SOUNDING PIPE TO BE FITTED

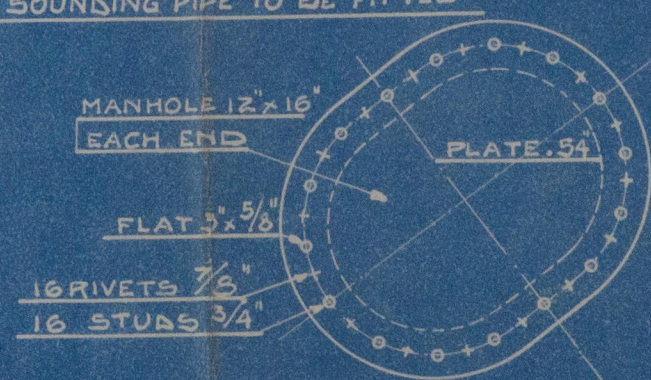


*Preserving Tank  
when OF in D.B.*

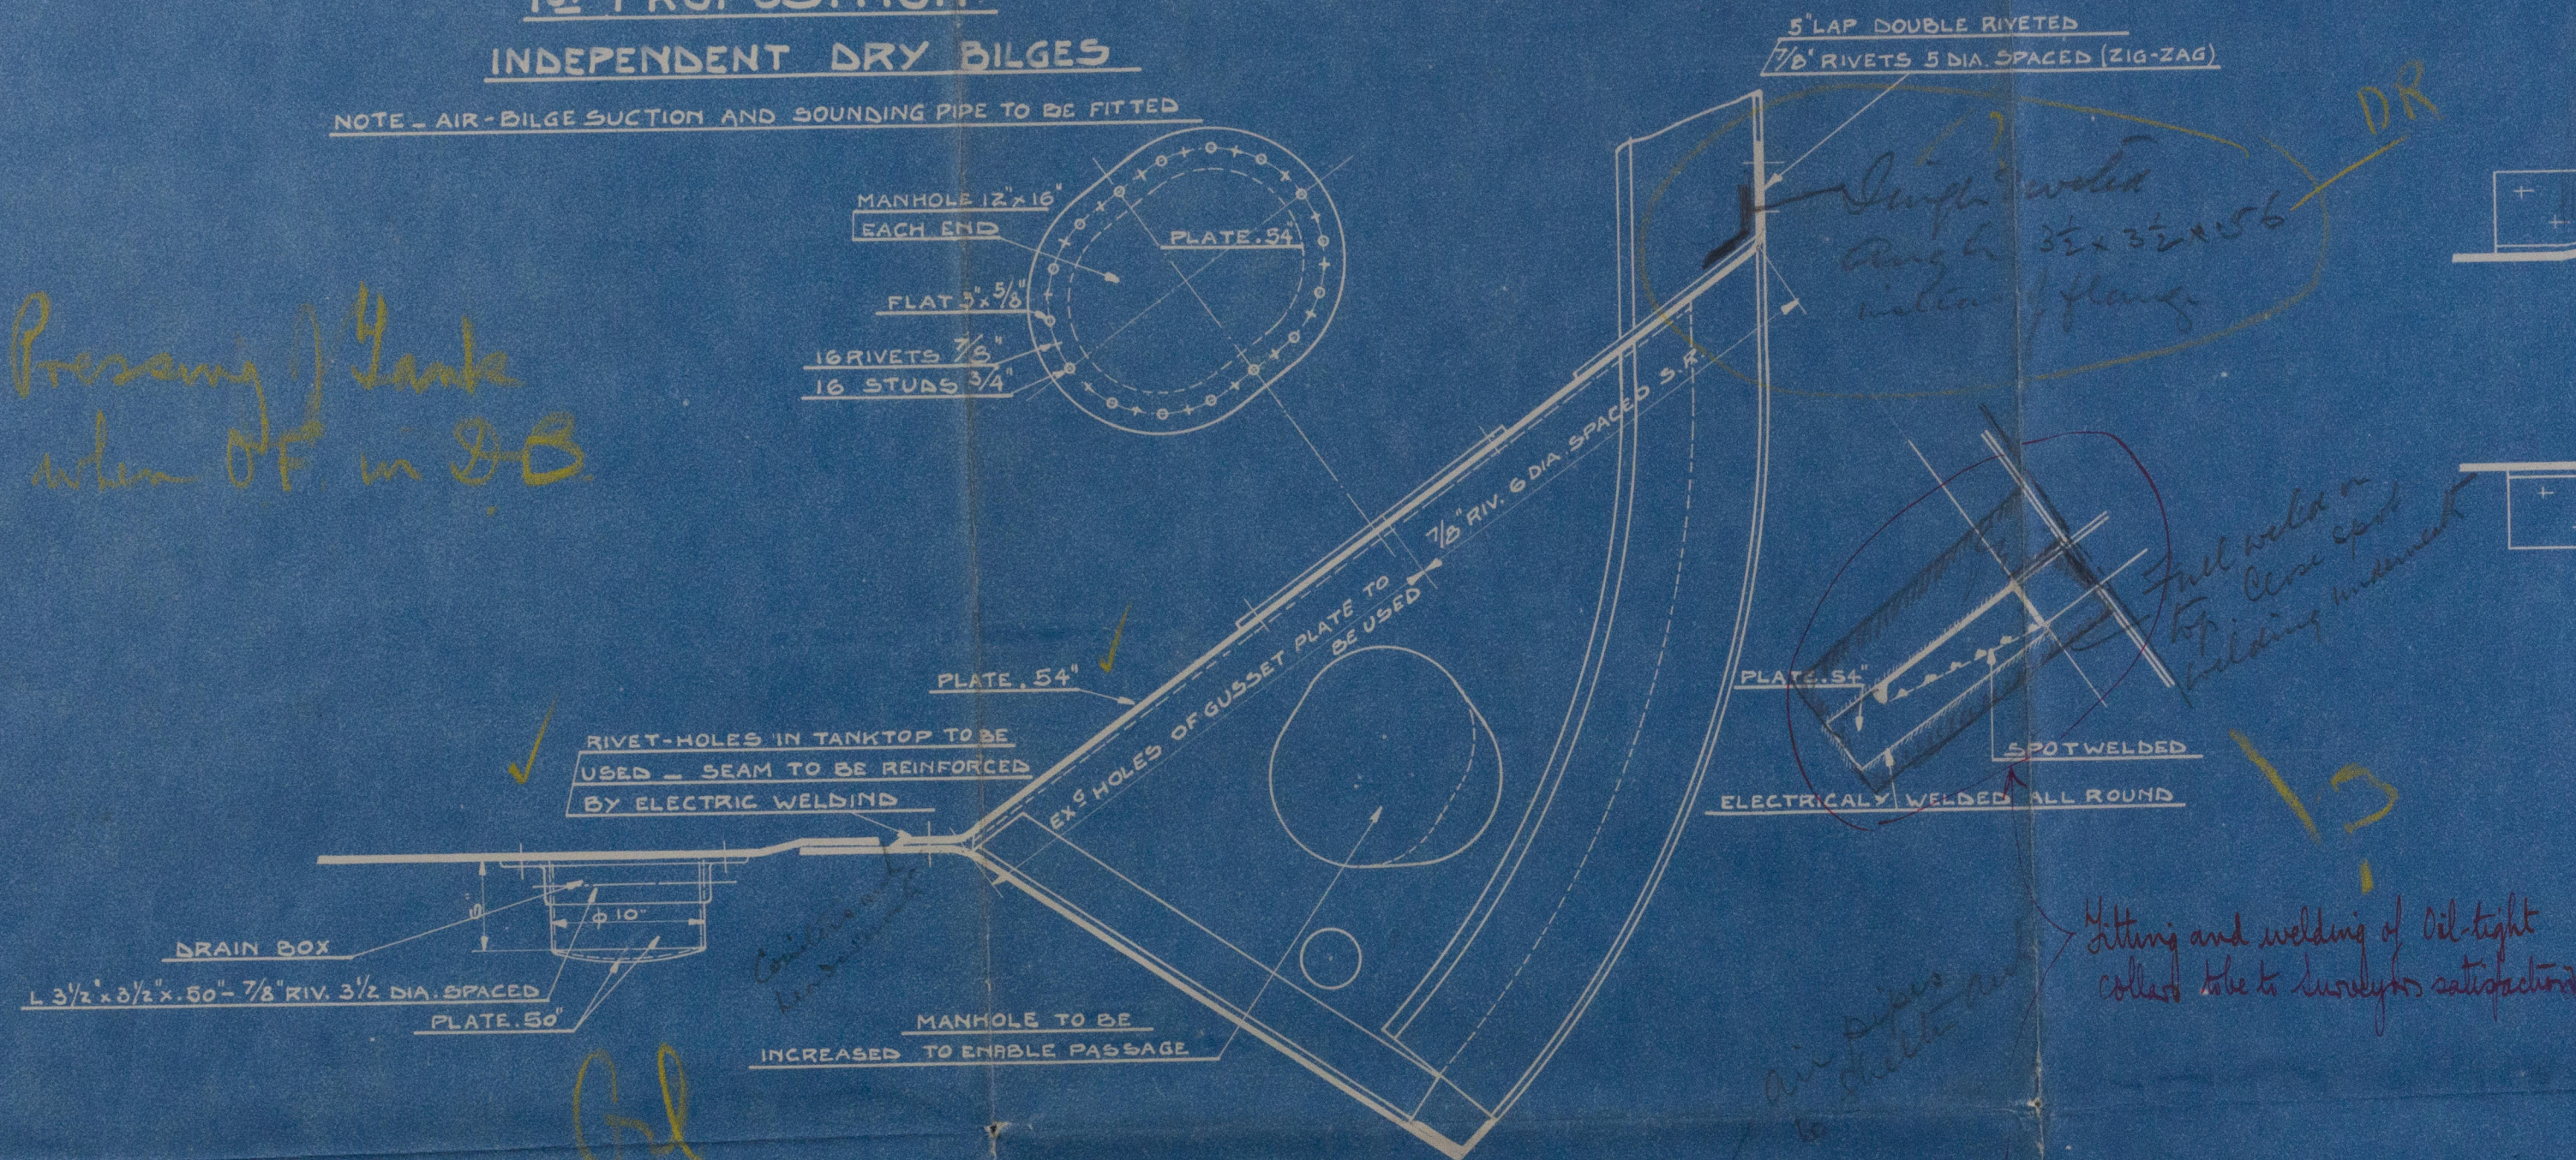


2<sup>ND</sup> PROPOSITION - DOUBLE BOTTOM EXTENDED

NOTE - EXISTING AIR PIPE TO BE ALTERED

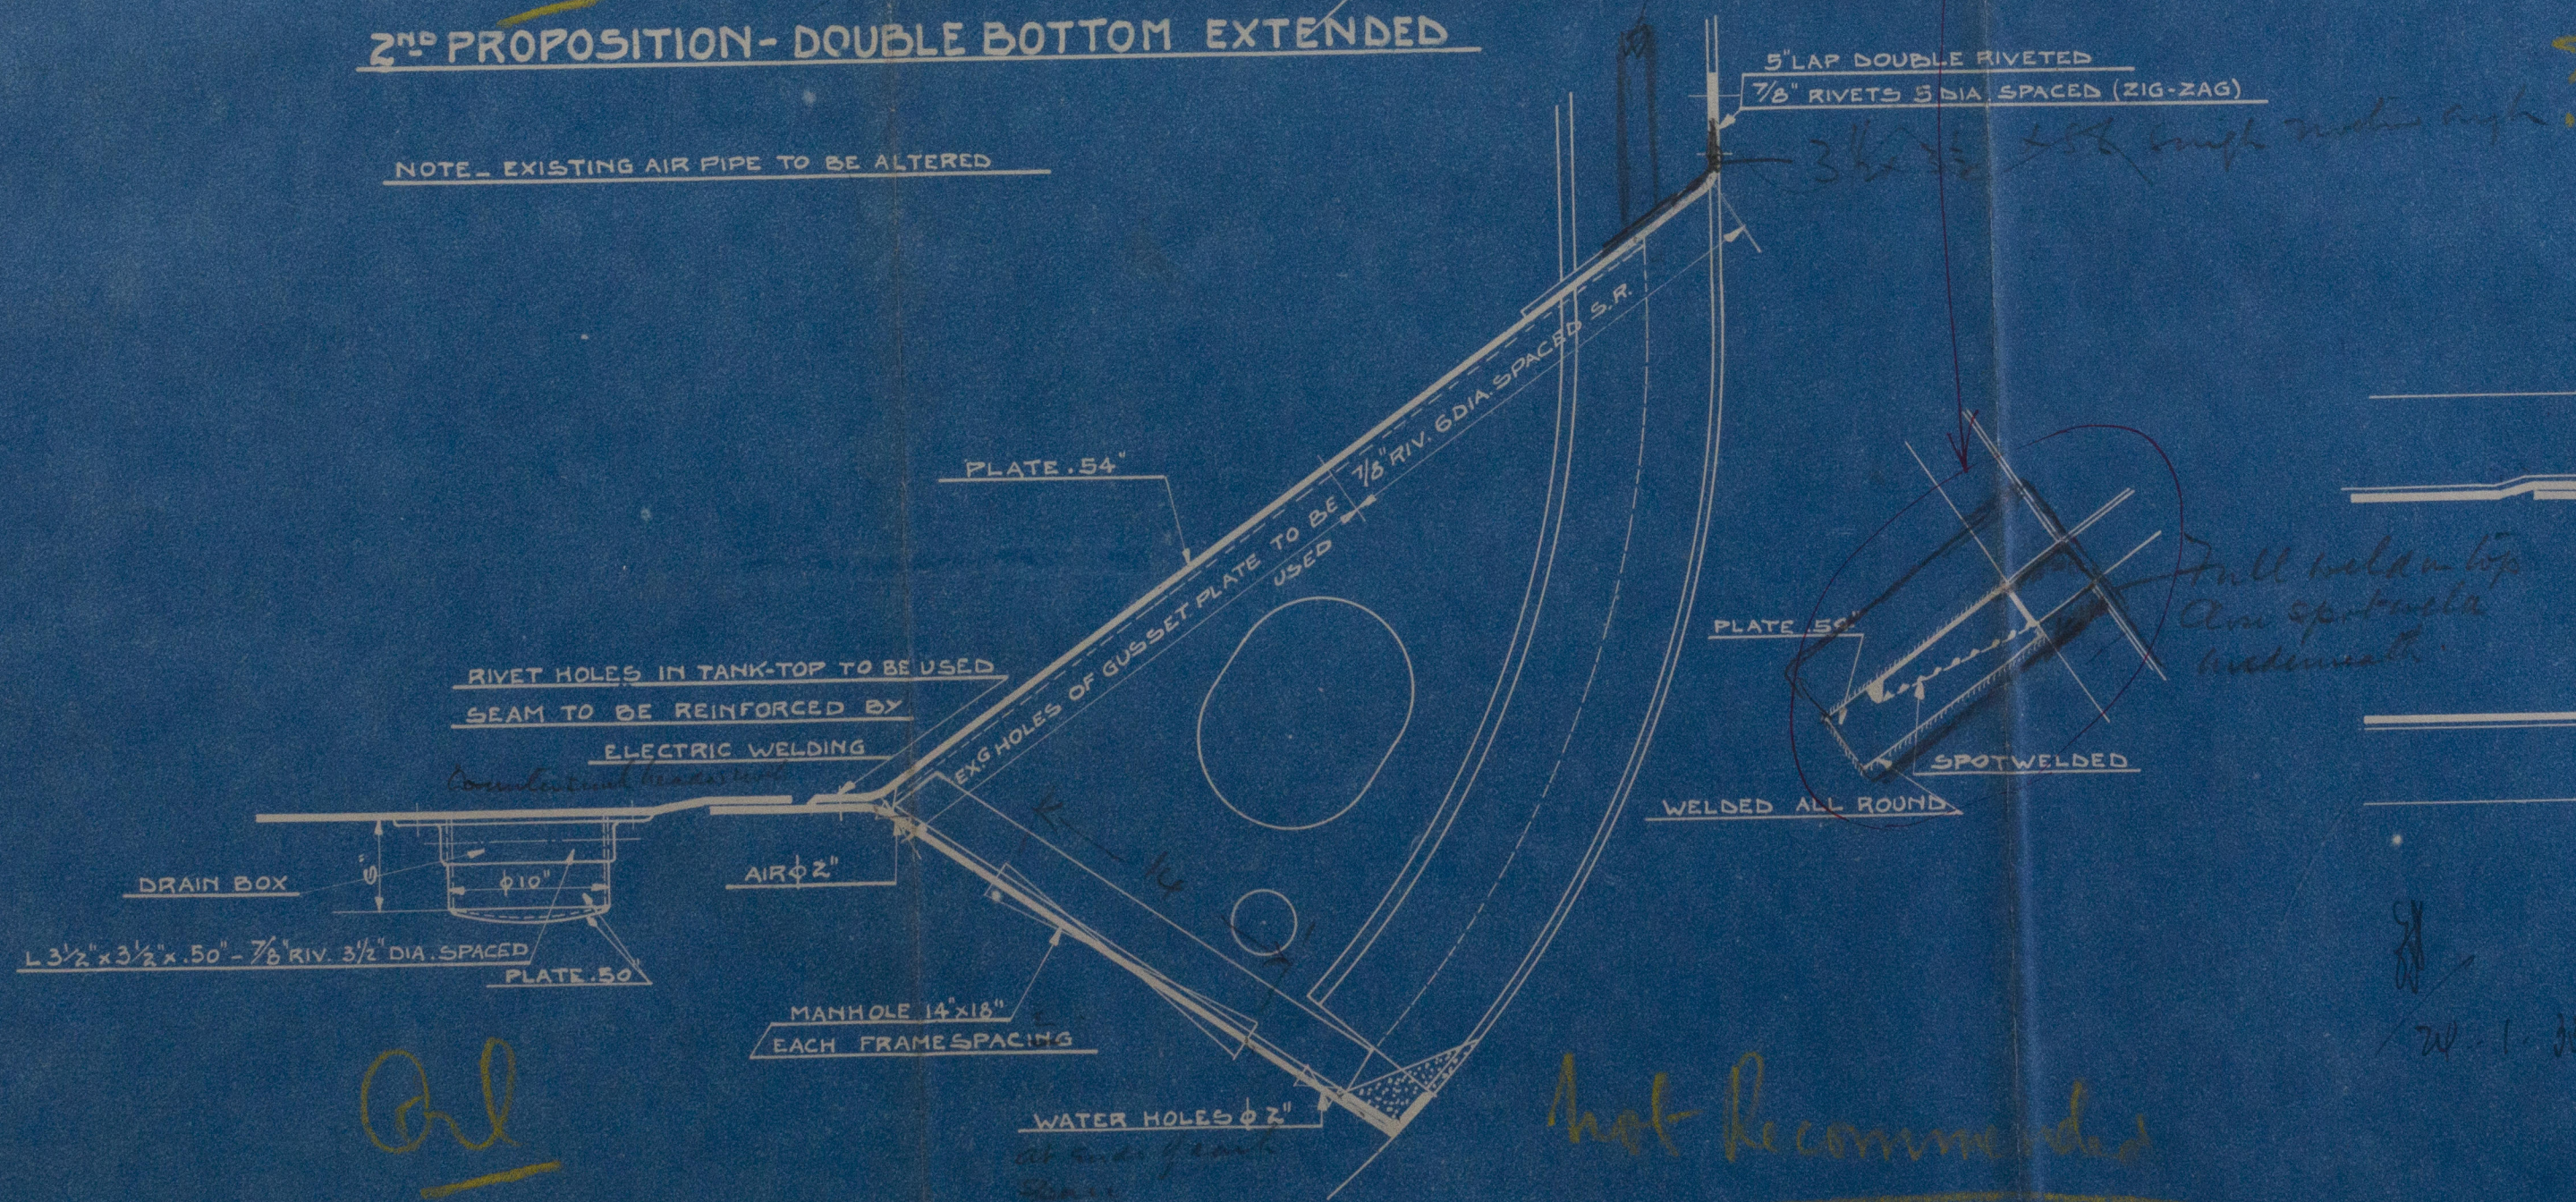


*Not Recommended*

ATTACHMENT ON NO 69 BULKHEAD

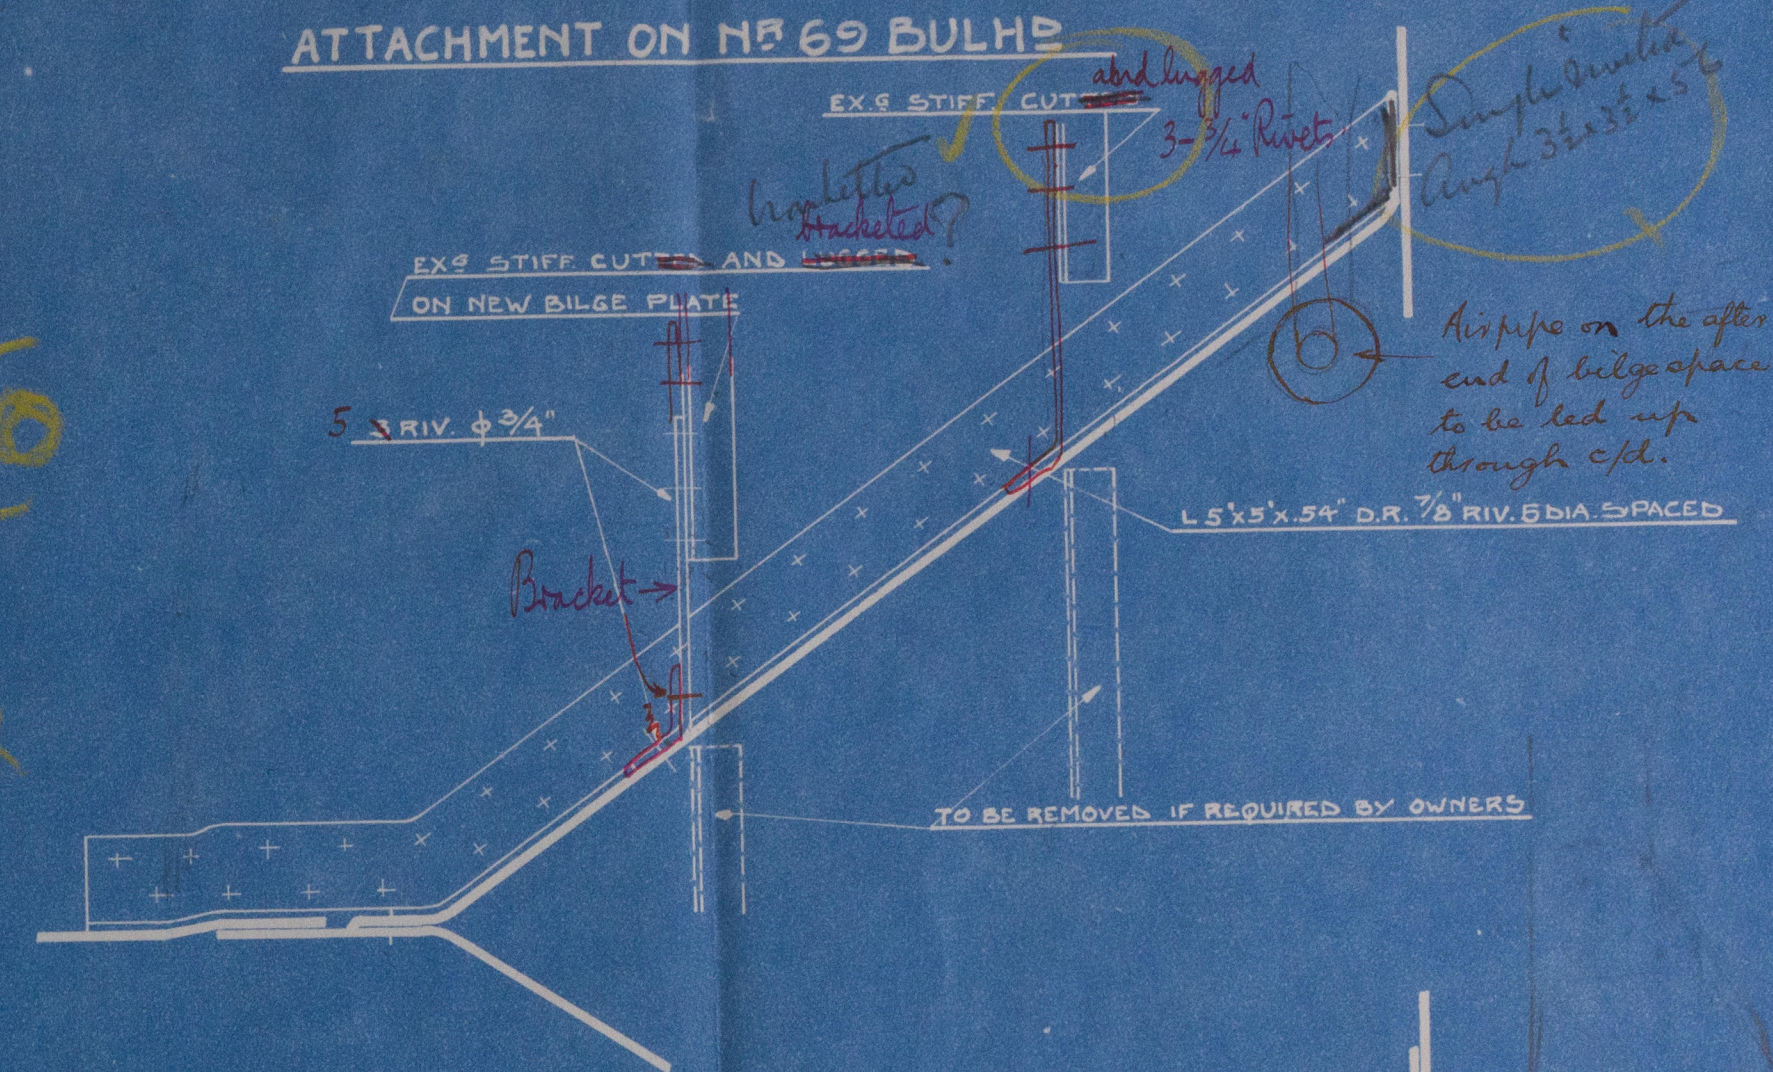

ATTACHMENT ON NO 60 BULKHEAD

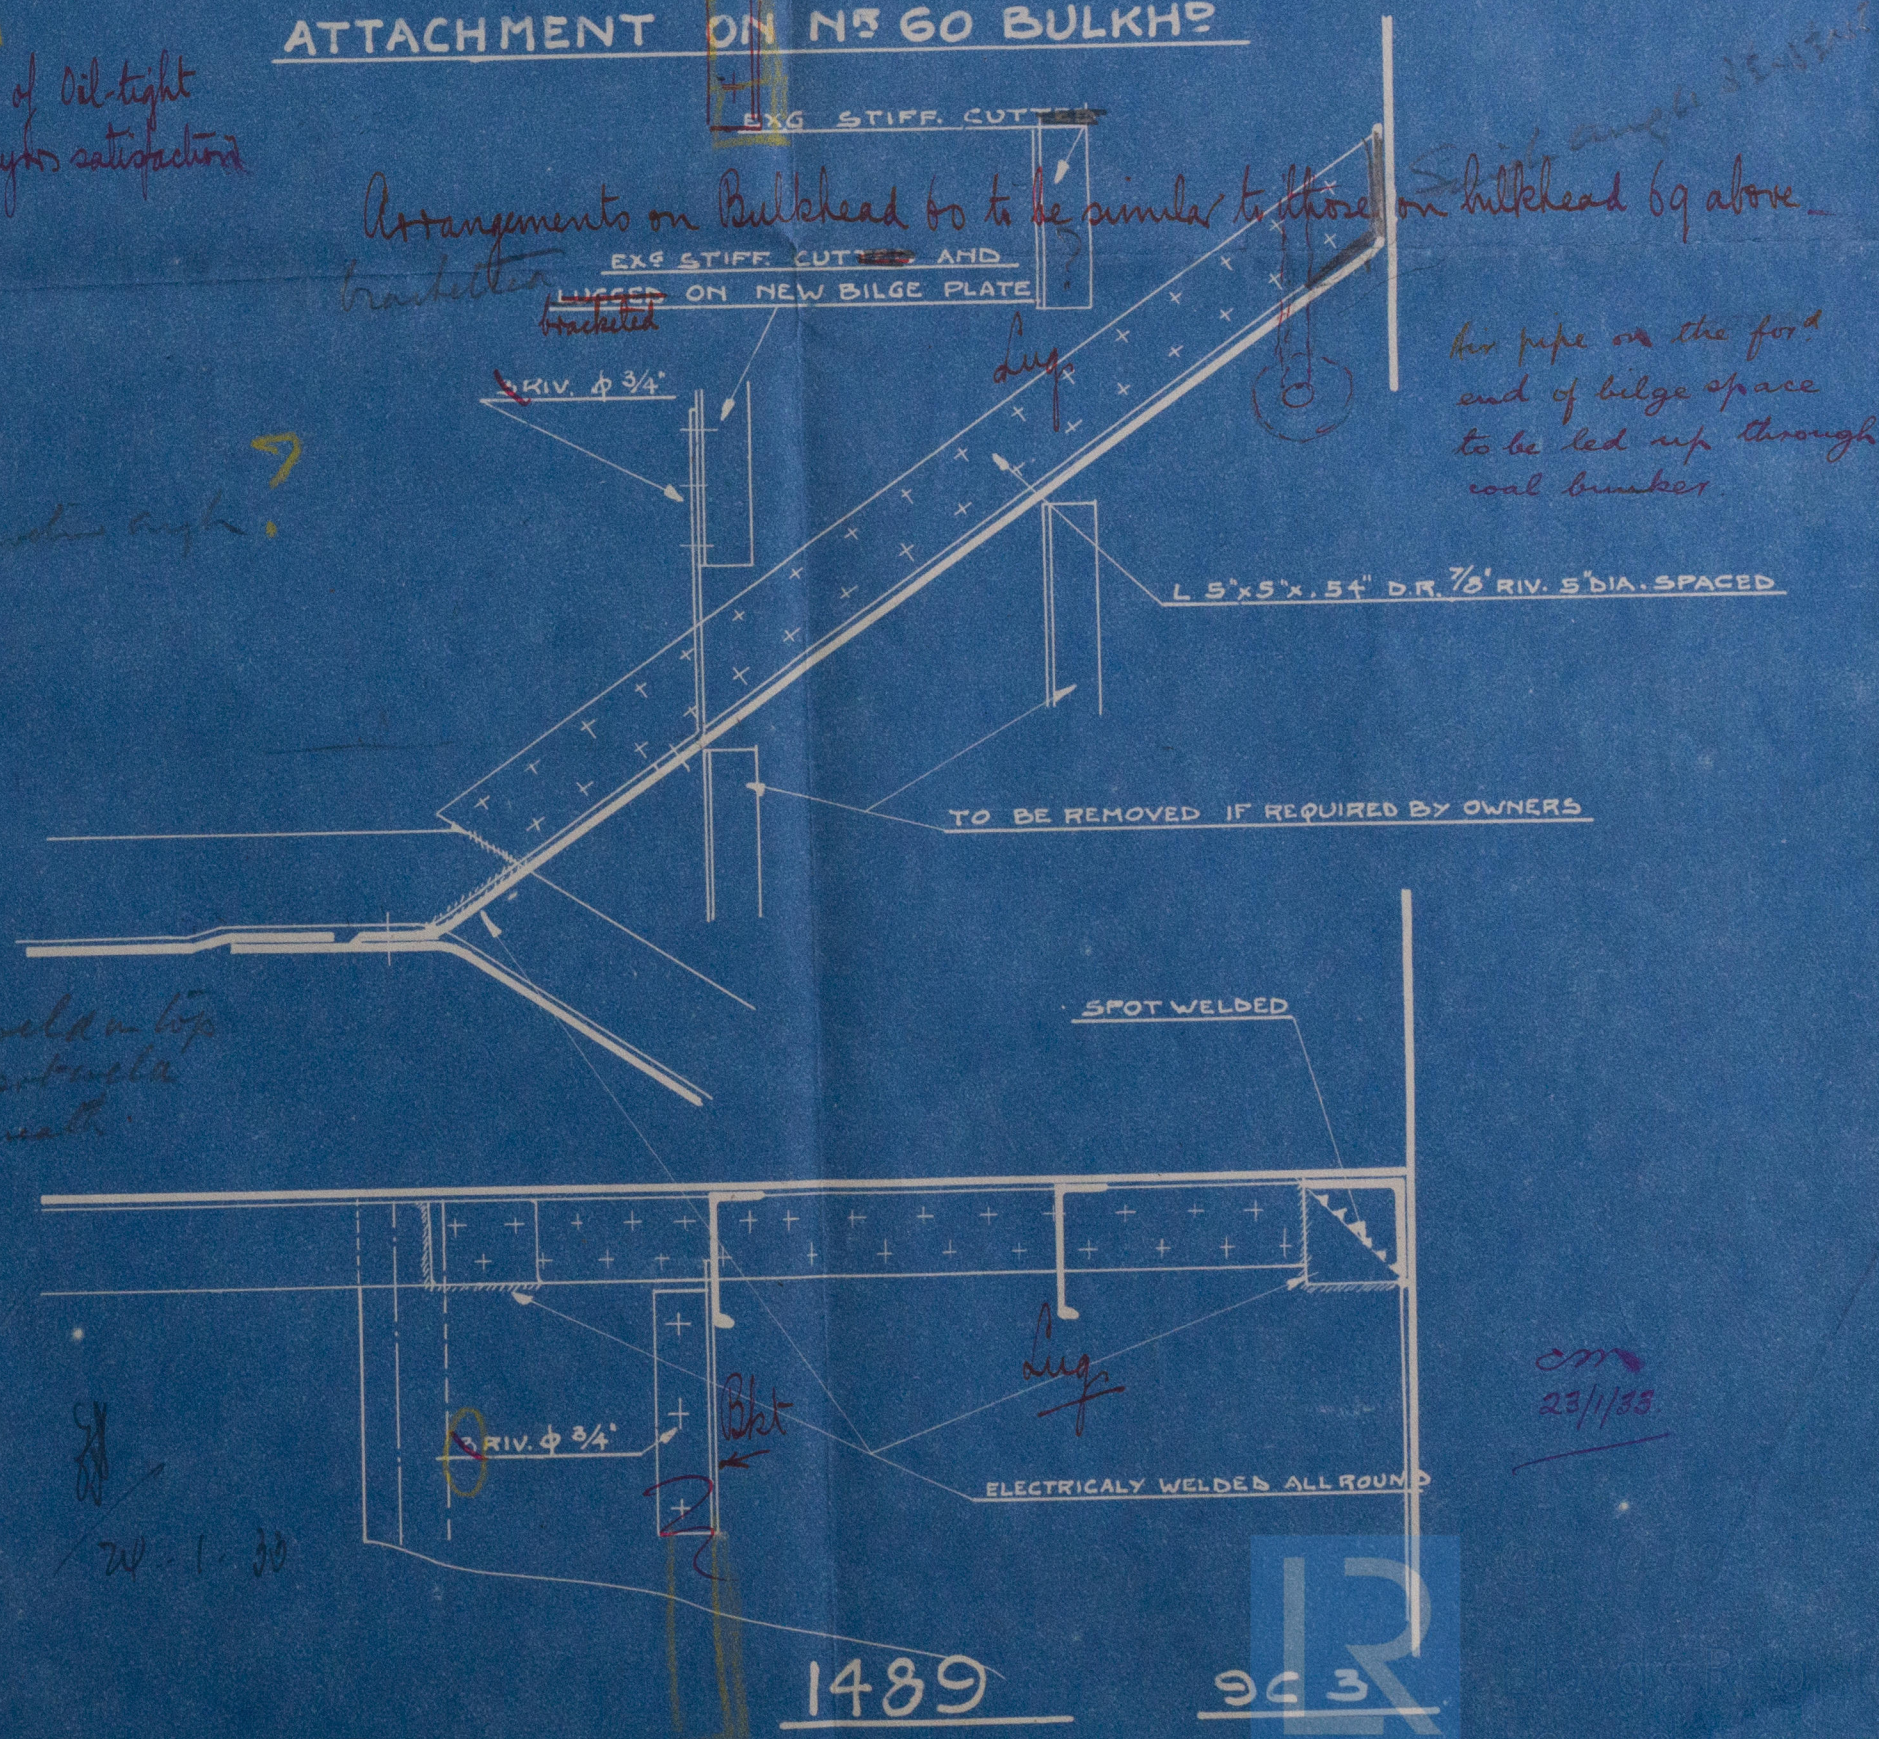

1489

943

W251-0037