
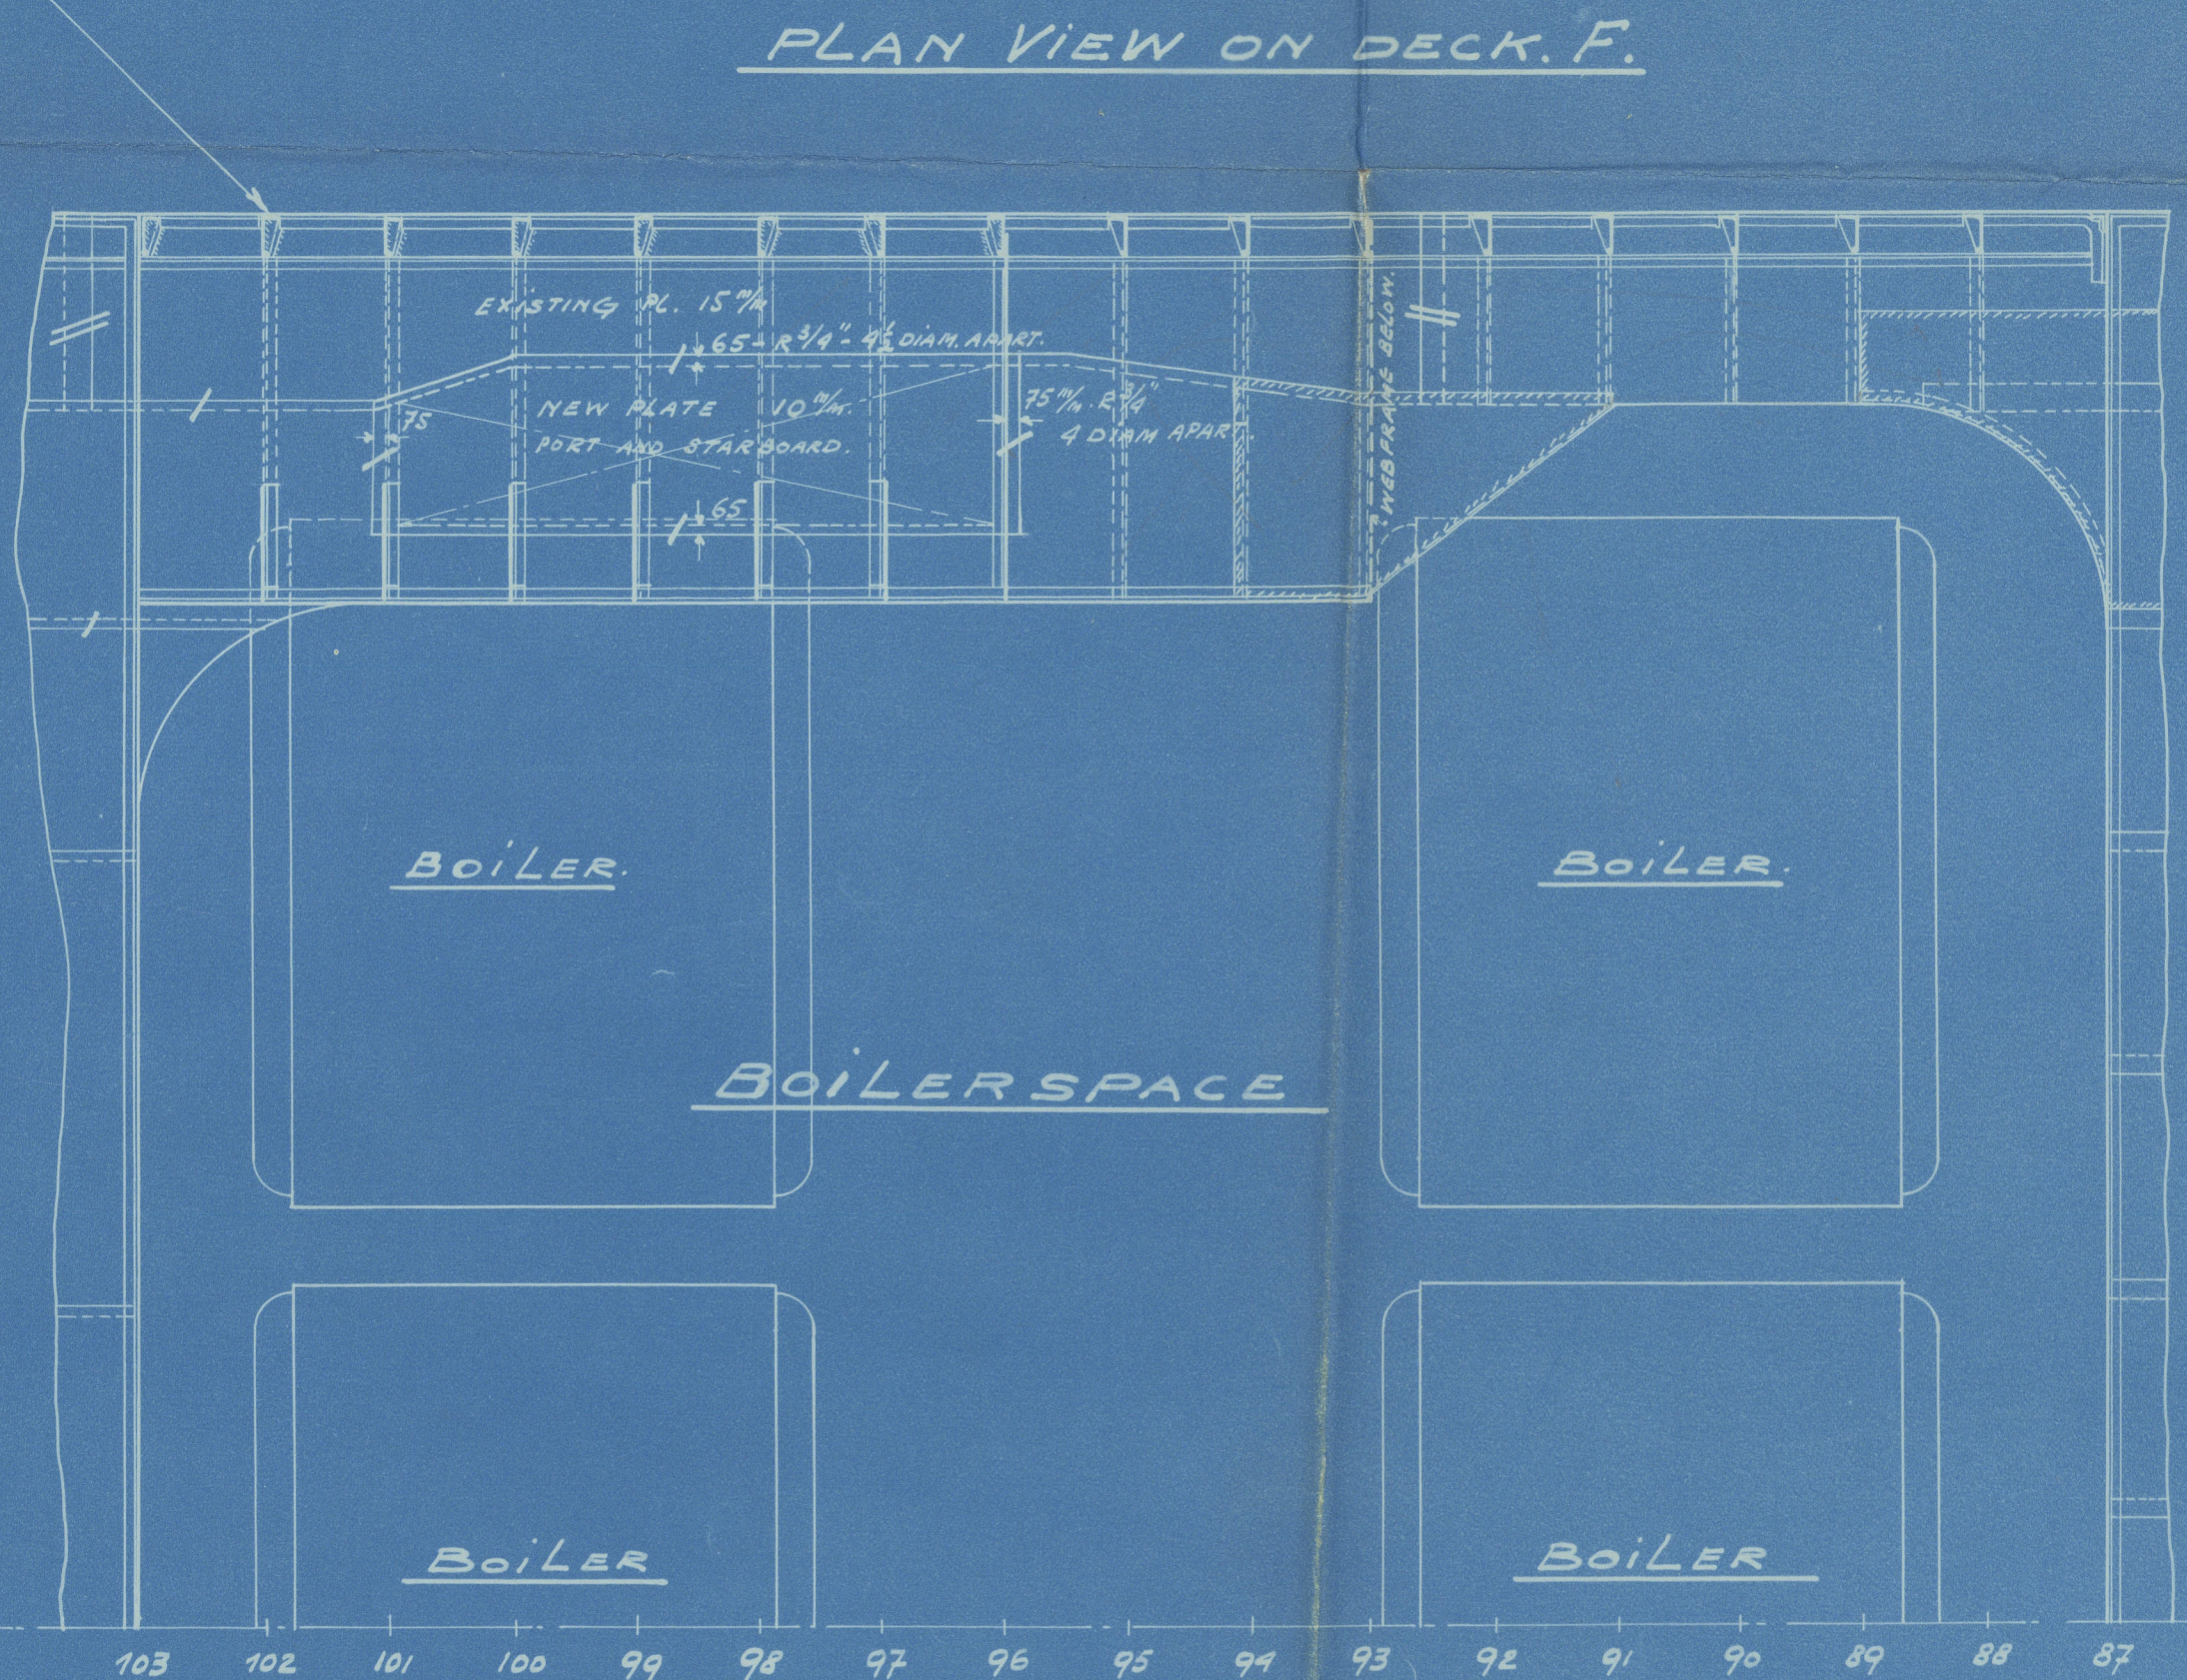
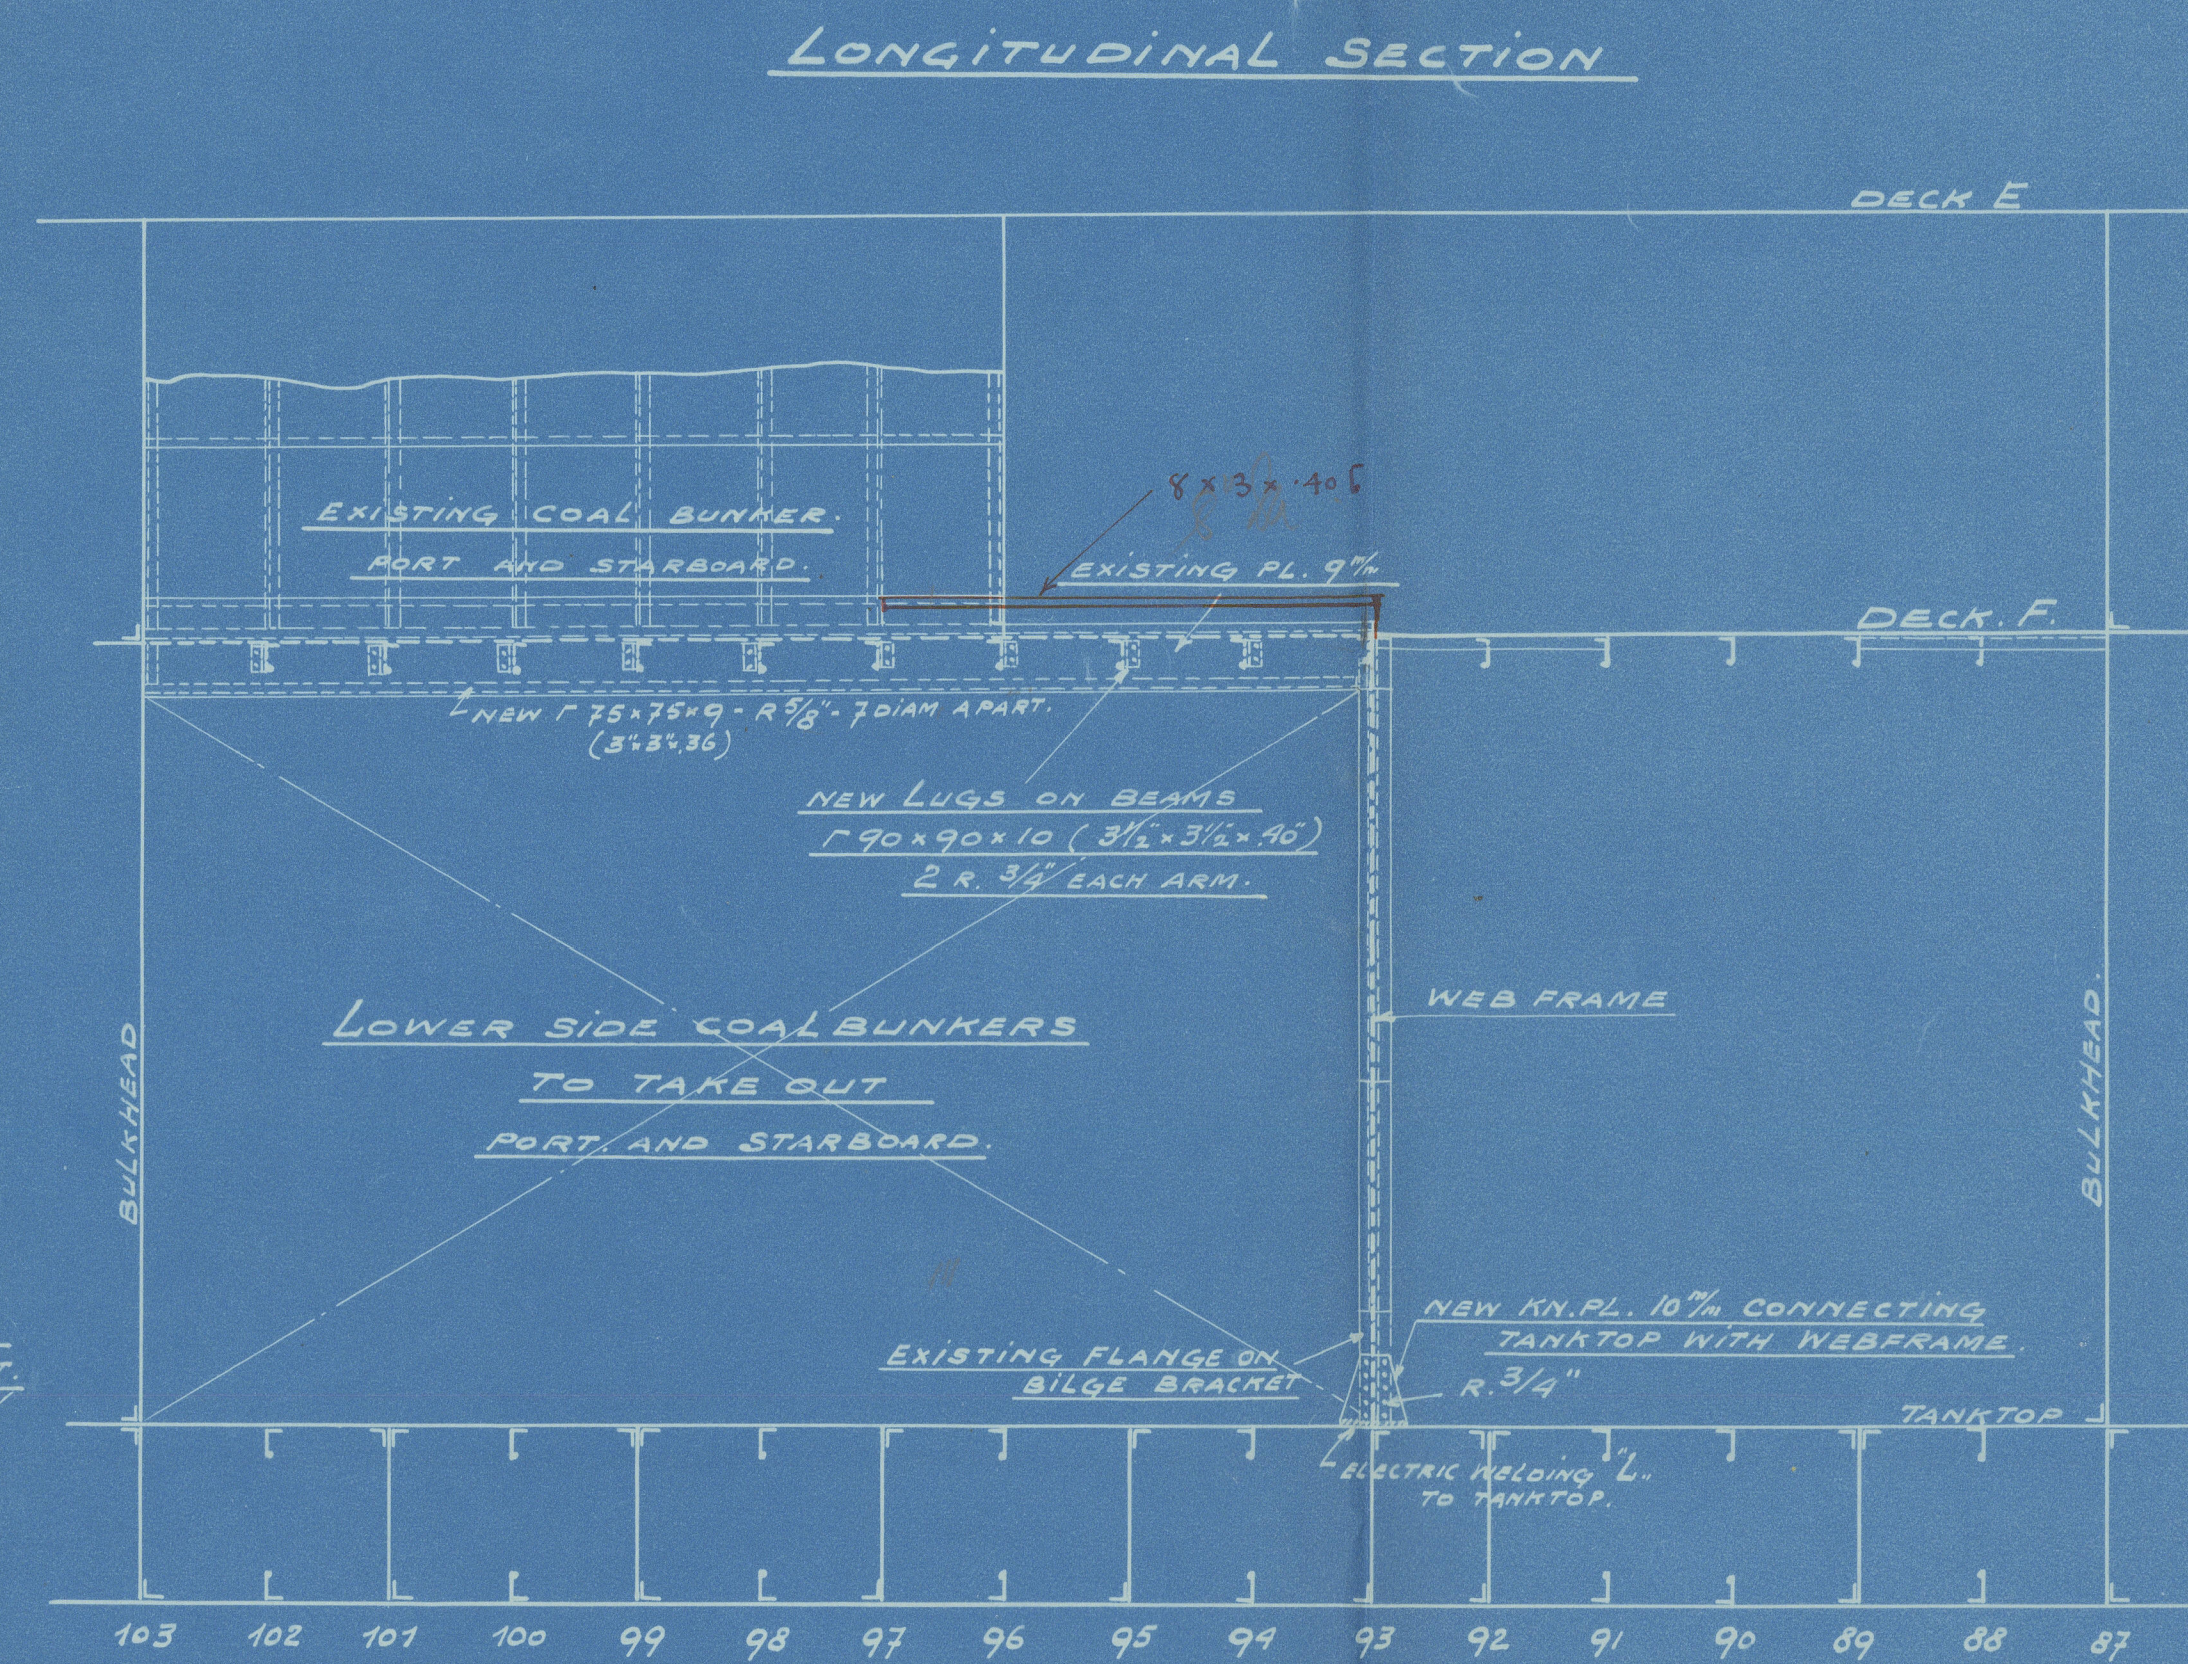


1/2 SECTION ON FRAME N°93

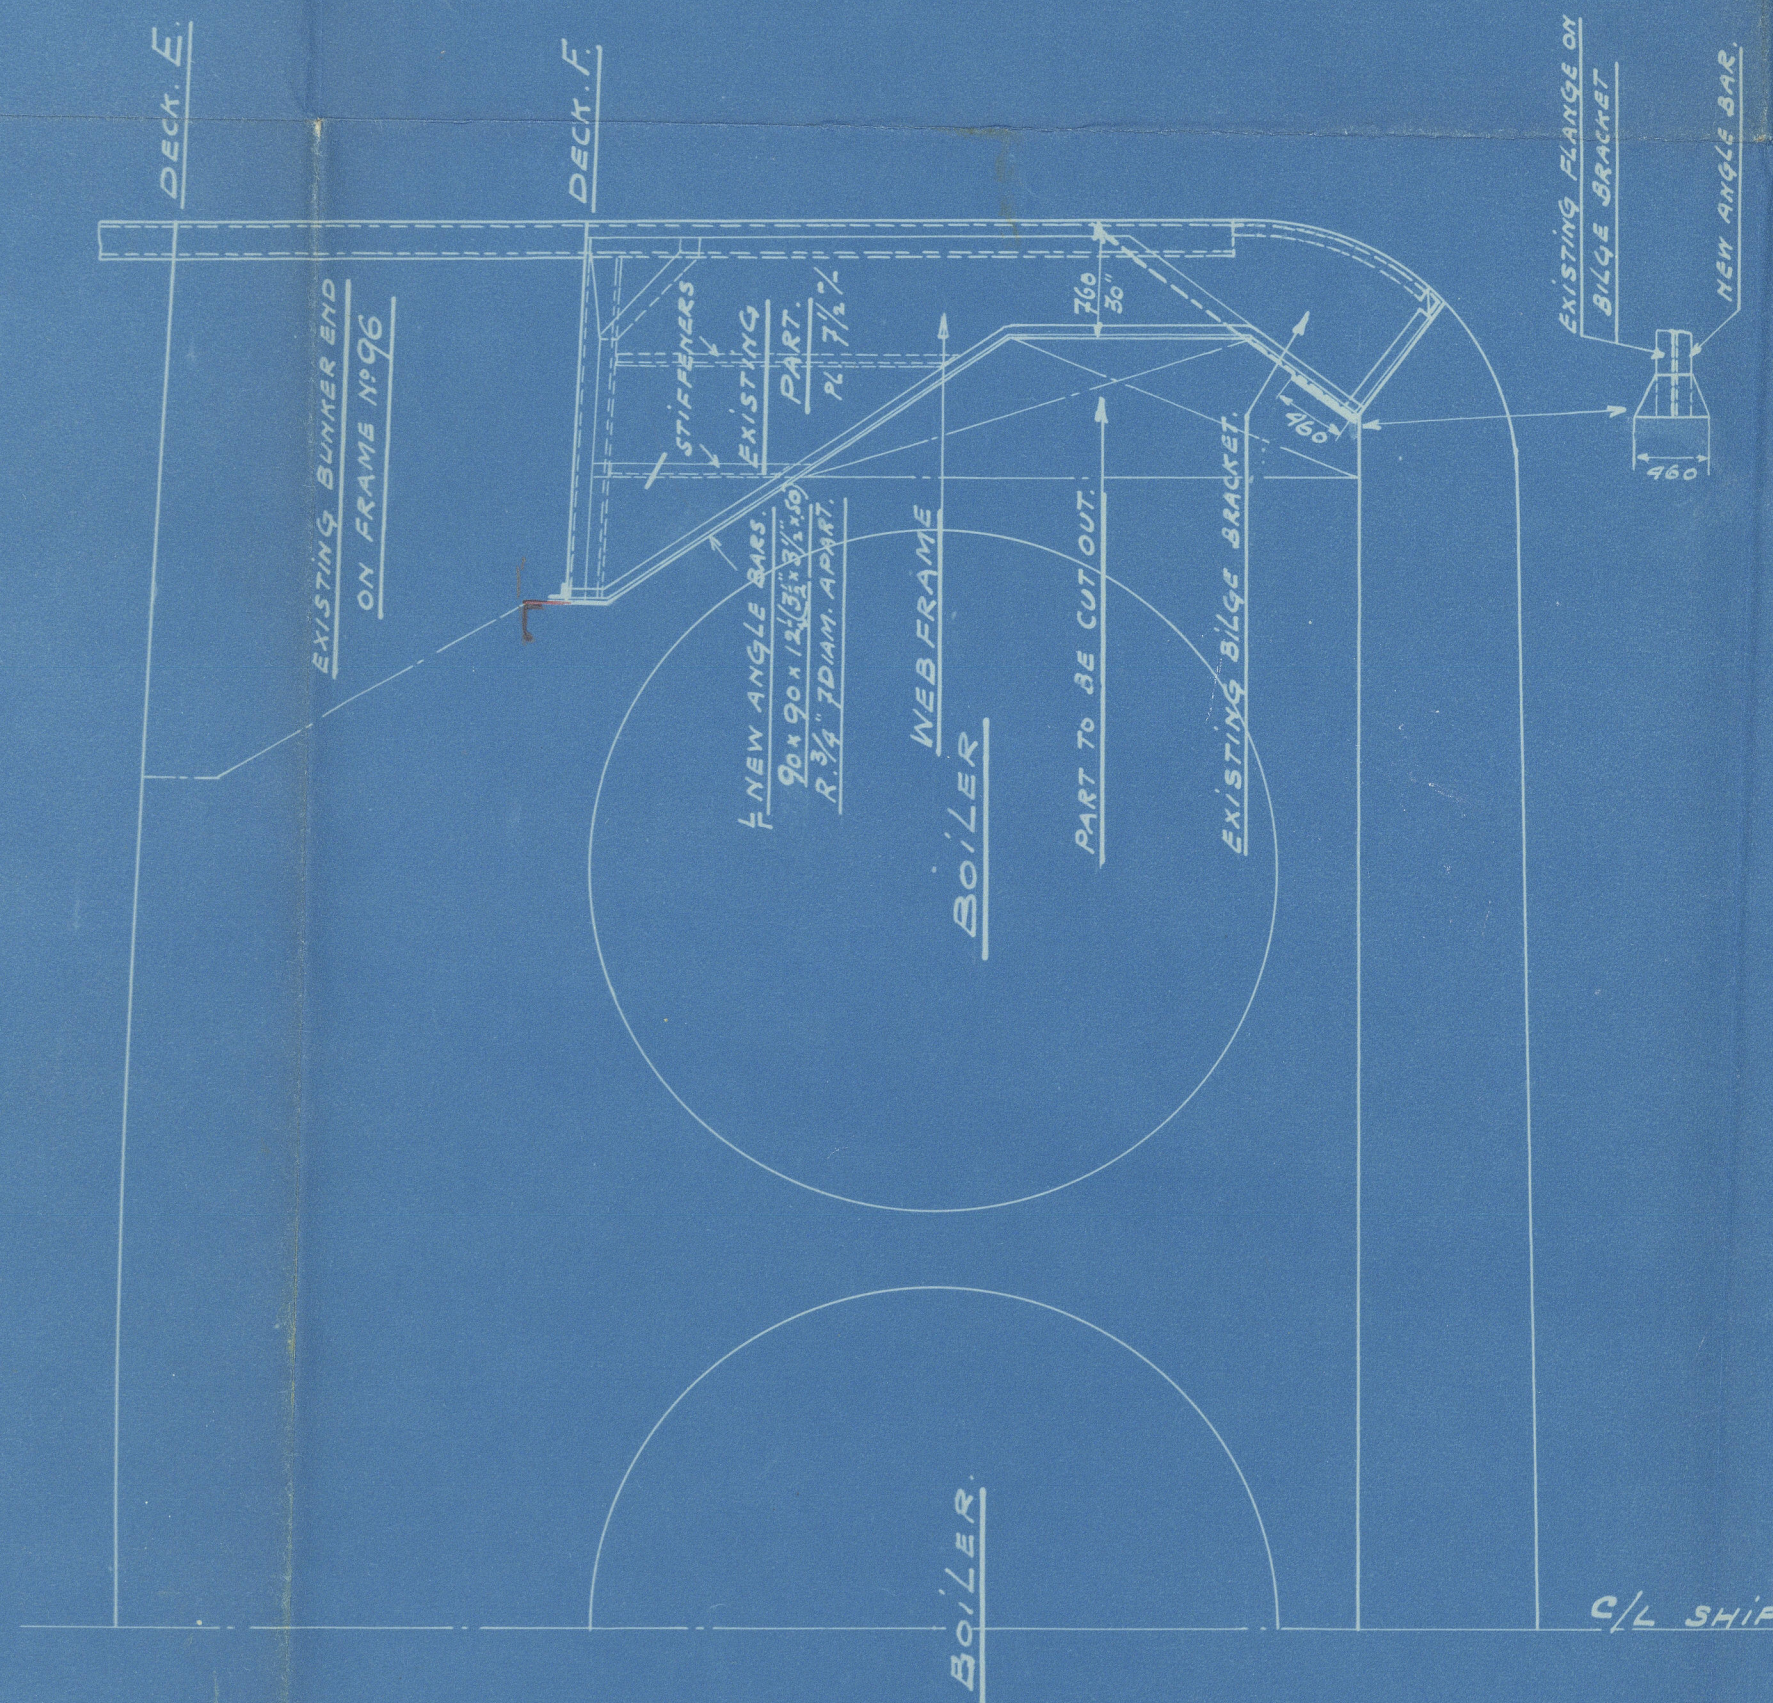

S/S. "LEOPOLDVILLE"  
MODIFICATION ON SIDE COAL BUNKERS  
AND BUNKER END BULKHEAD N°93. ALTERED IN WEBFRAME  
SCALE. 1/50.

14. 5. 36

PLAN N° 1908-152A19

W251-0068