


S. S. LEOPOLDVILLE.

ALTERATION ON DECK GIRDER OF DECK 'F' (APPROVED PLAN 1899-15-A-1)

1/50 SCALE.

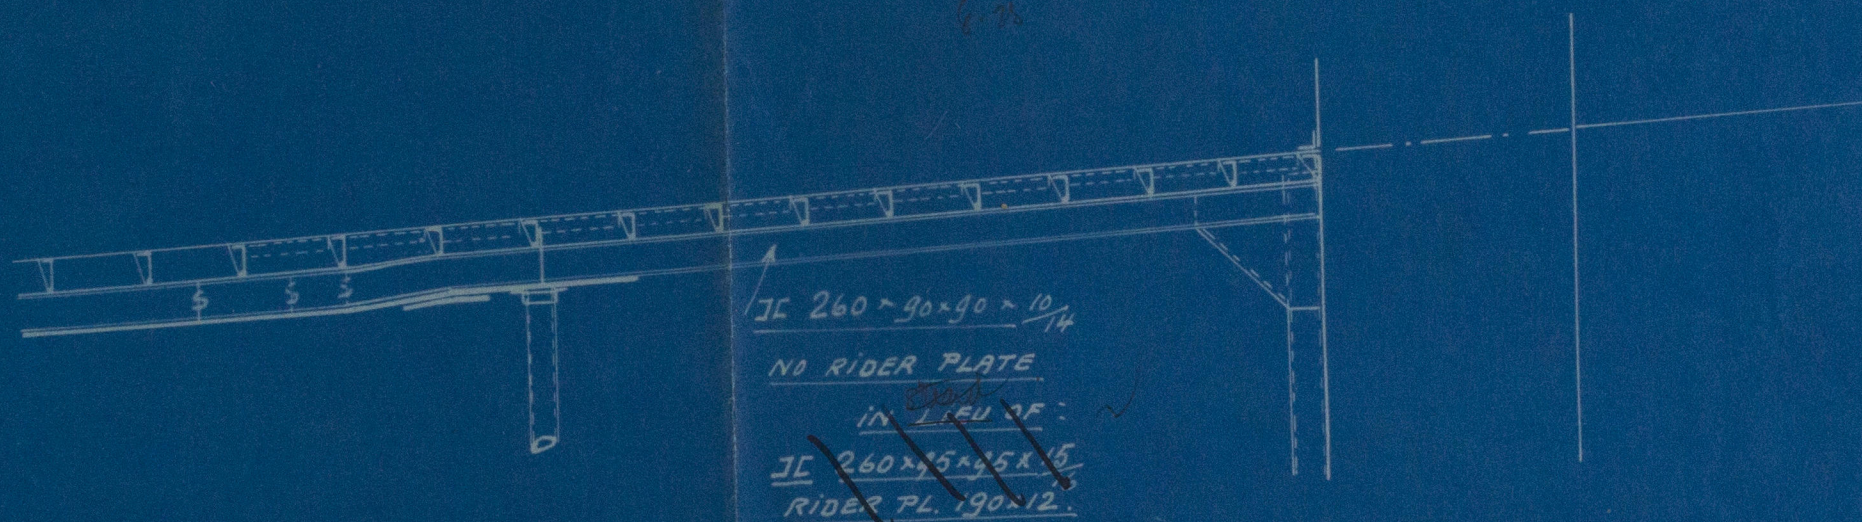


380

2.7.76

MERCANTILE MARINE ENGINEERING & GRAYING DOCKS CO.

PLAN N^o 1937 - 11-B-3

W251-0075