



NEW OPENING IN EXISTING W.T. BULKHEAD N°121

LOOKING FORWARD

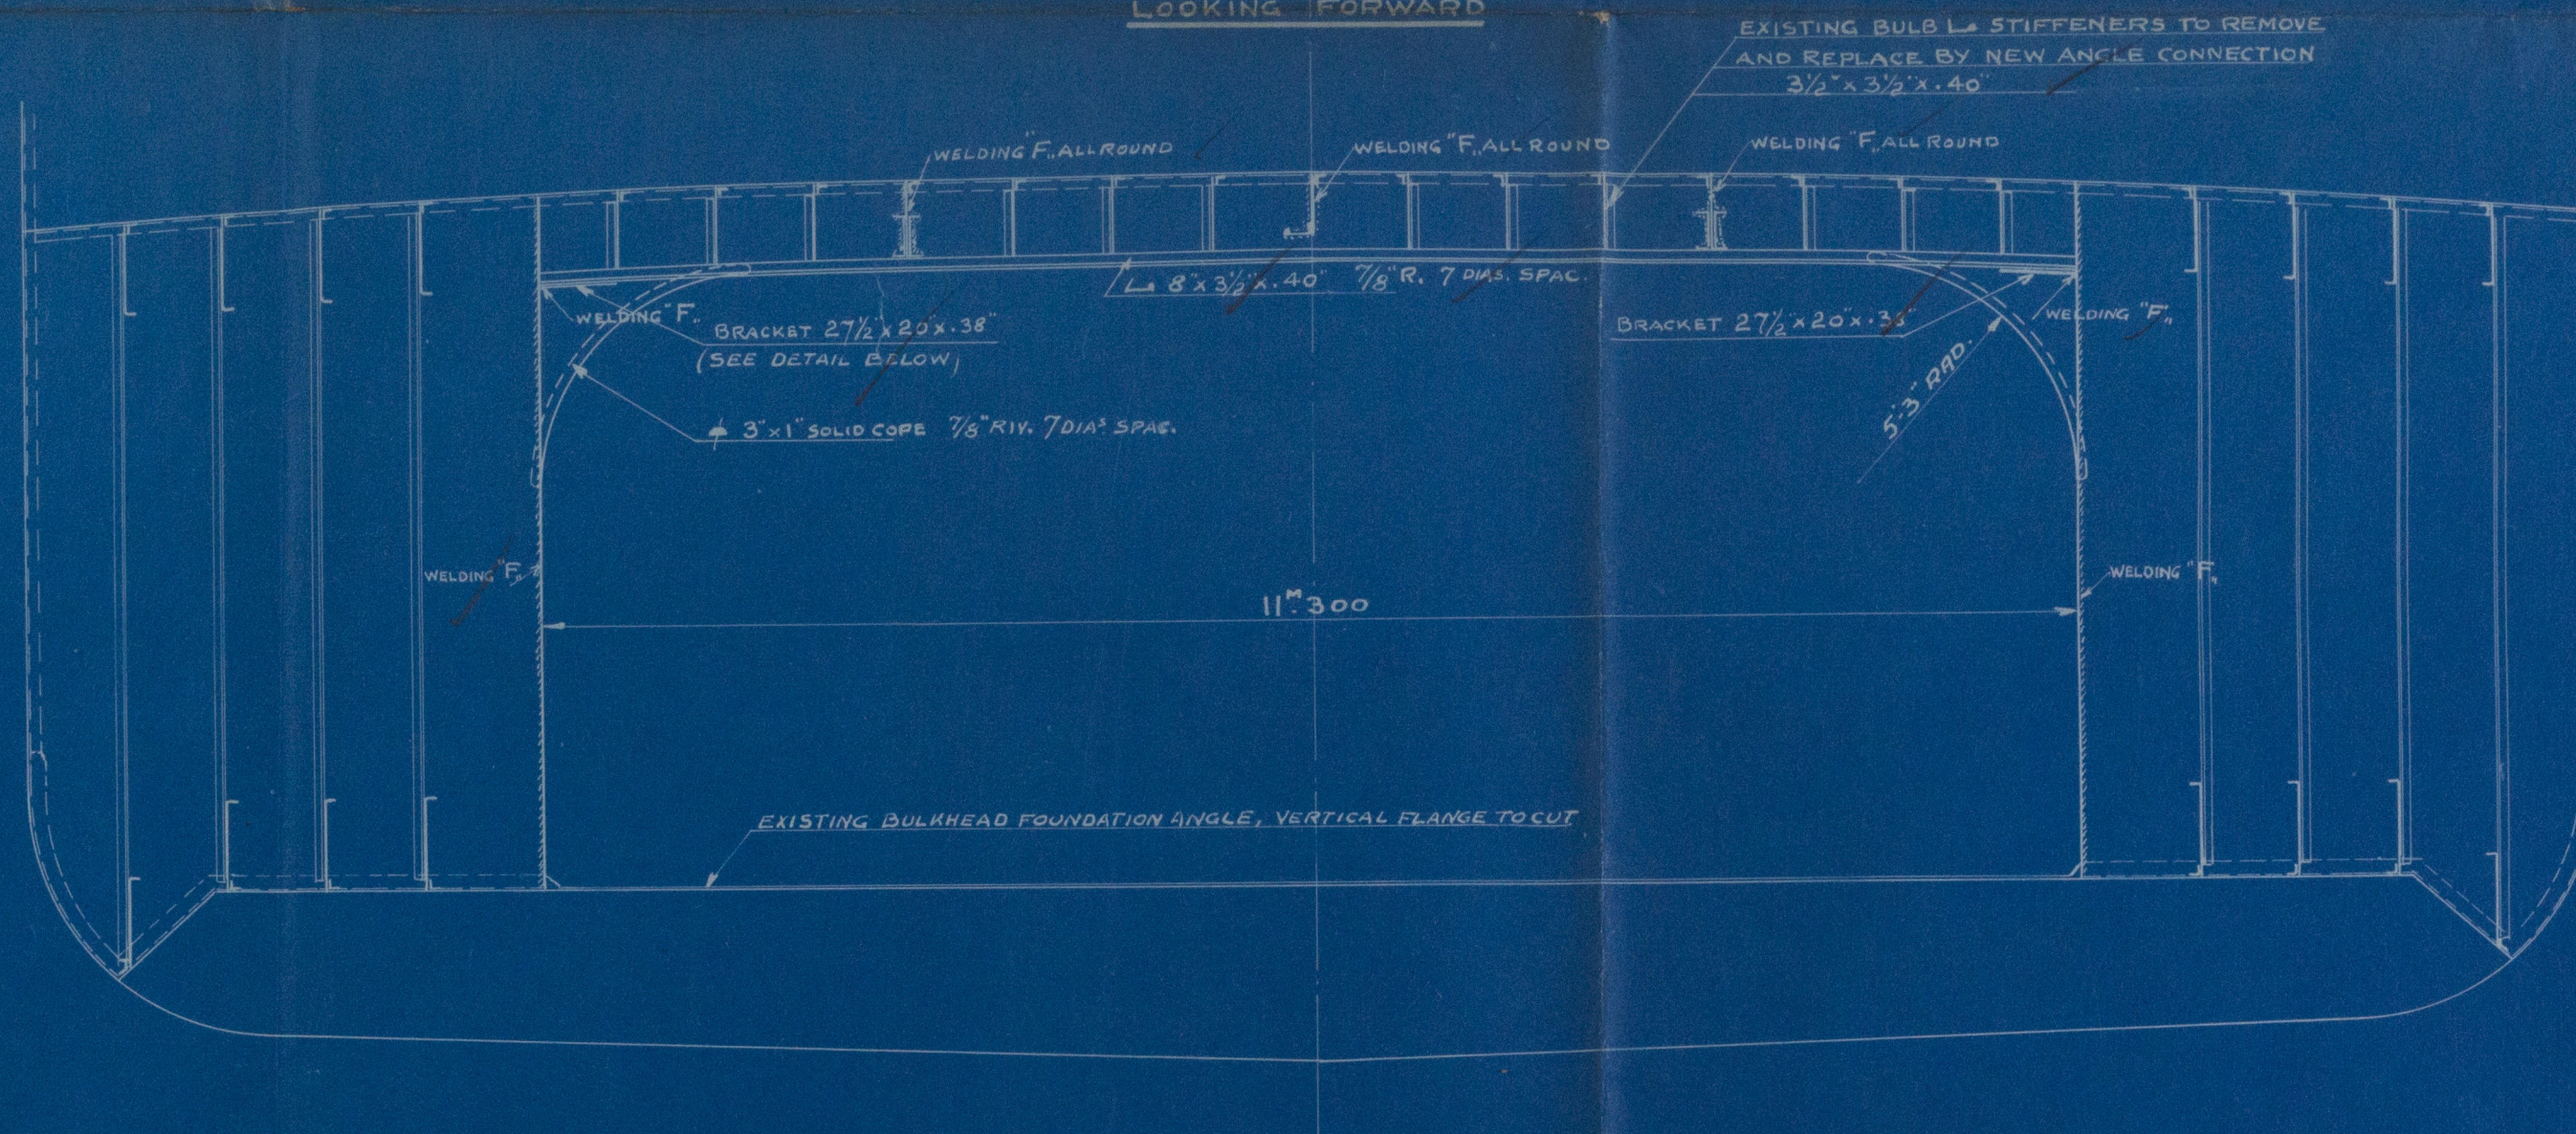

BRACKET ATTACHMENT

SCALE: $\frac{1}{20}$

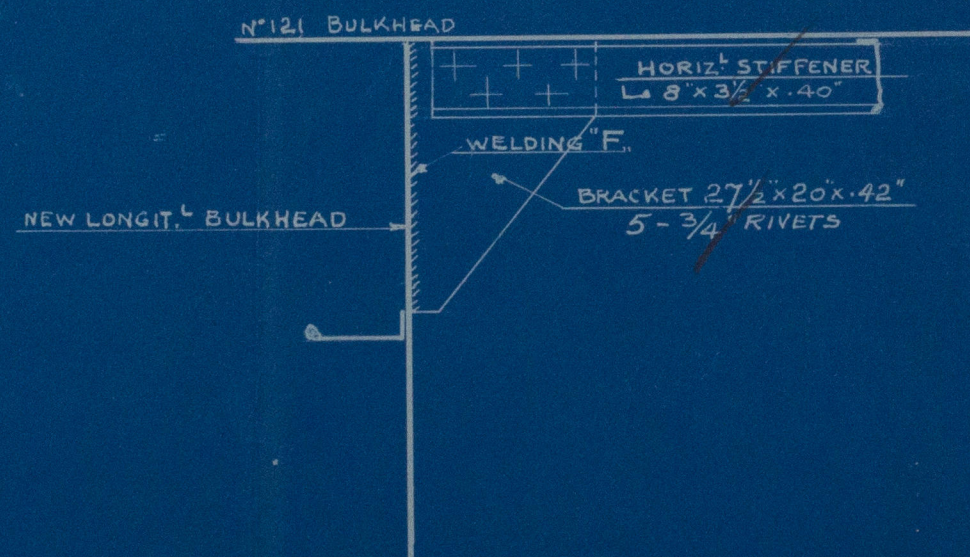

S/S LEOPOLDVILLE

ALTERATIONS ON N°121 W.T BULKHEAD

SCALE: $\frac{1}{50}$

PL. N°1890 15C.1.



© 2019

Leopoldville Foundation

W251-0077