


SECTION OF FRONT BHD.

SECTION OF CABINSIDE BHD.

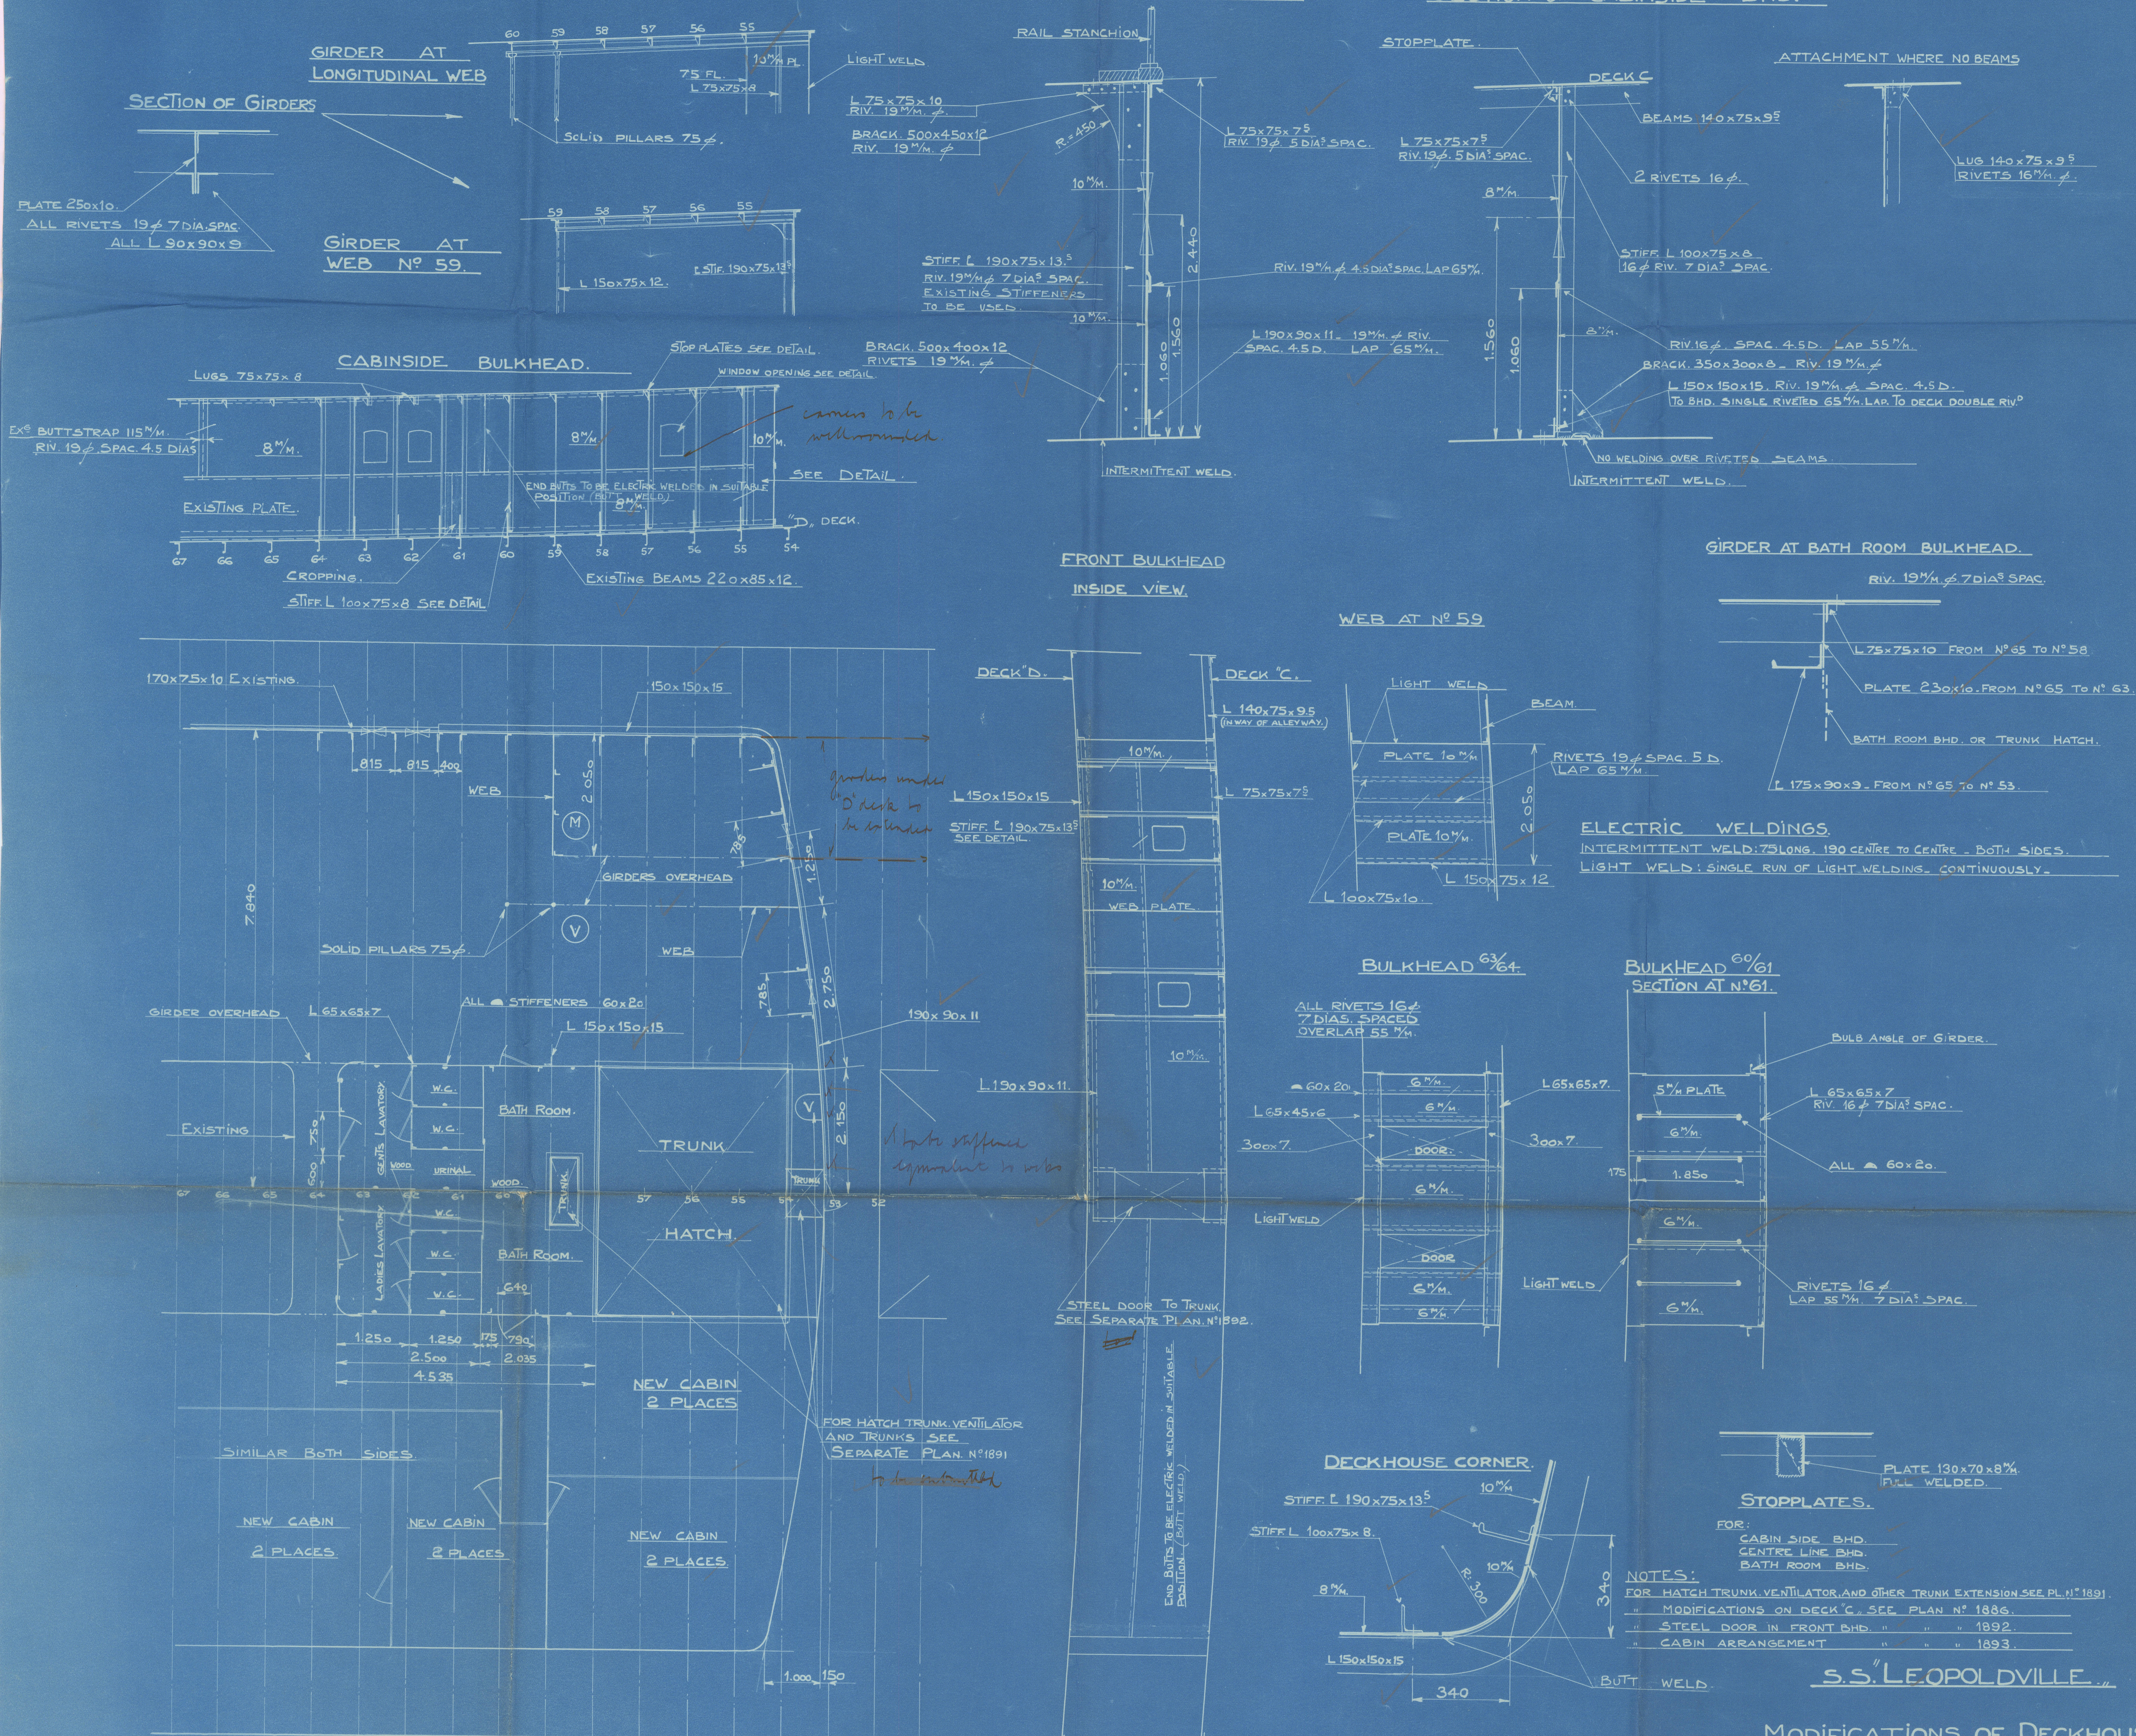

S.S. LEOPOLDVILLE

MODIFICATIONS OF DECKHOUSES
ON "D" DECK.

SCALE 1/50

DETAILS 1/20 - 1/10

CLASS. N° 1887.6.1.