

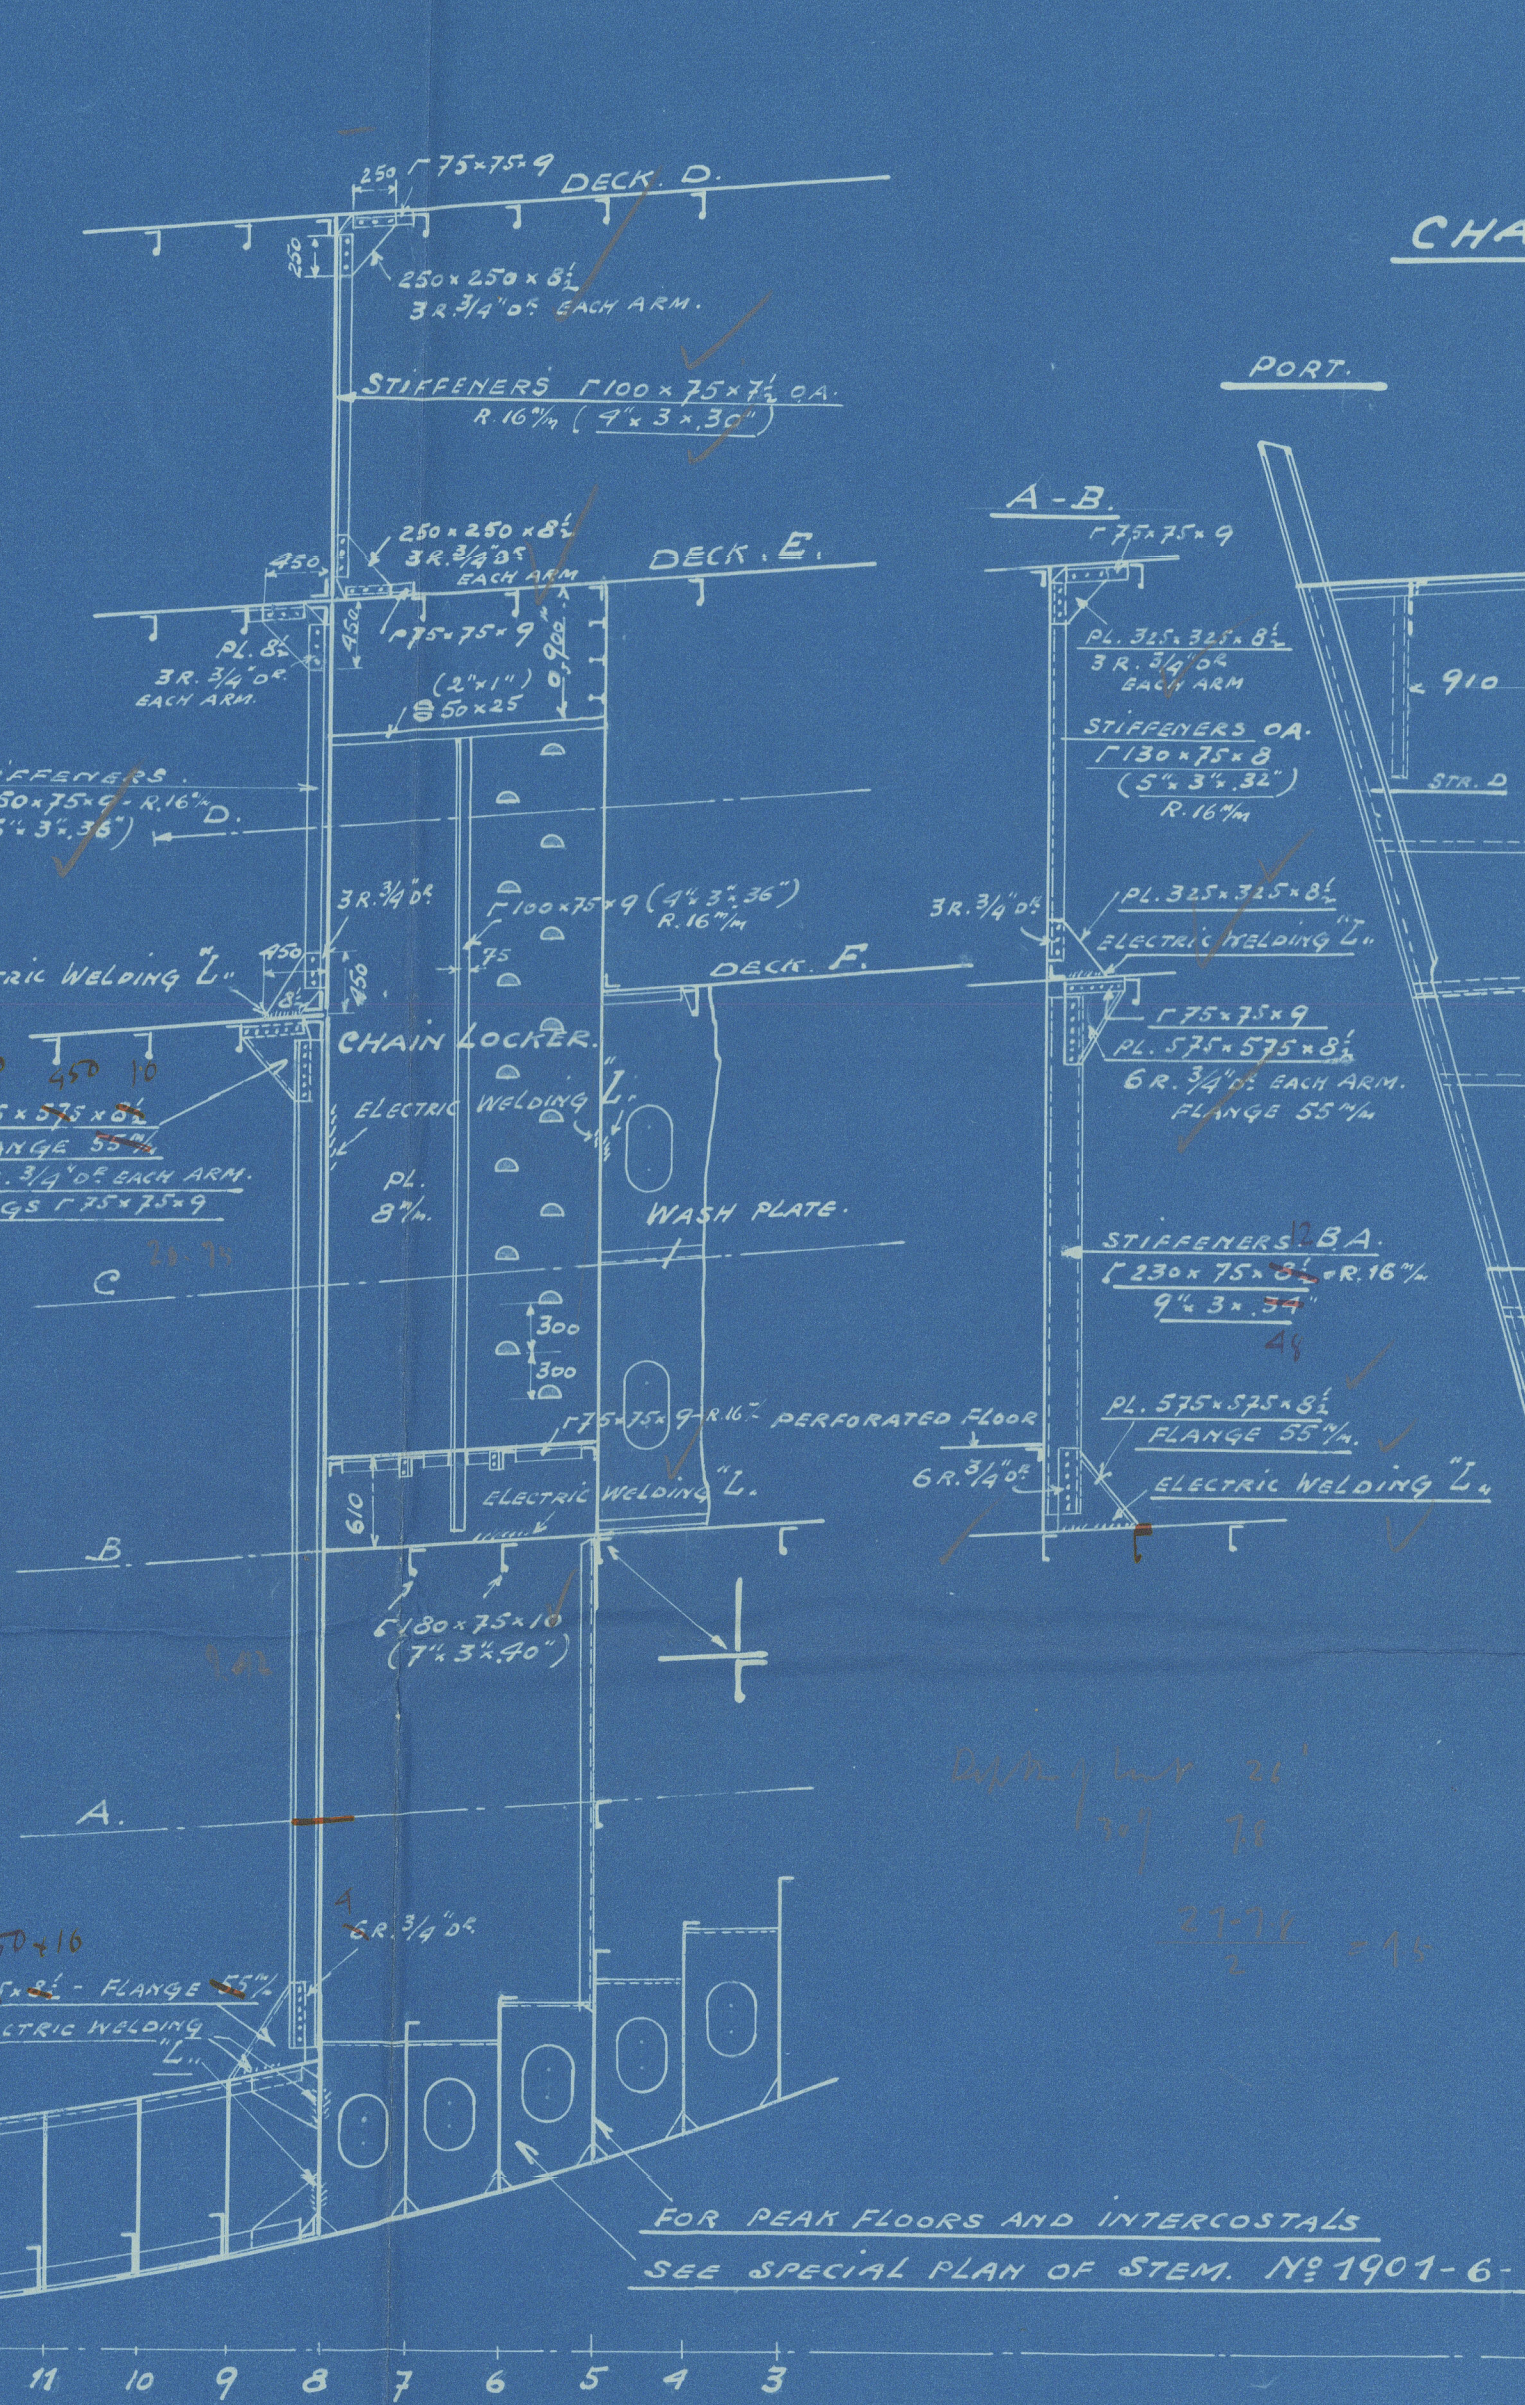


W.T. COLLISION BULKHEAD No 8

ELEVATION

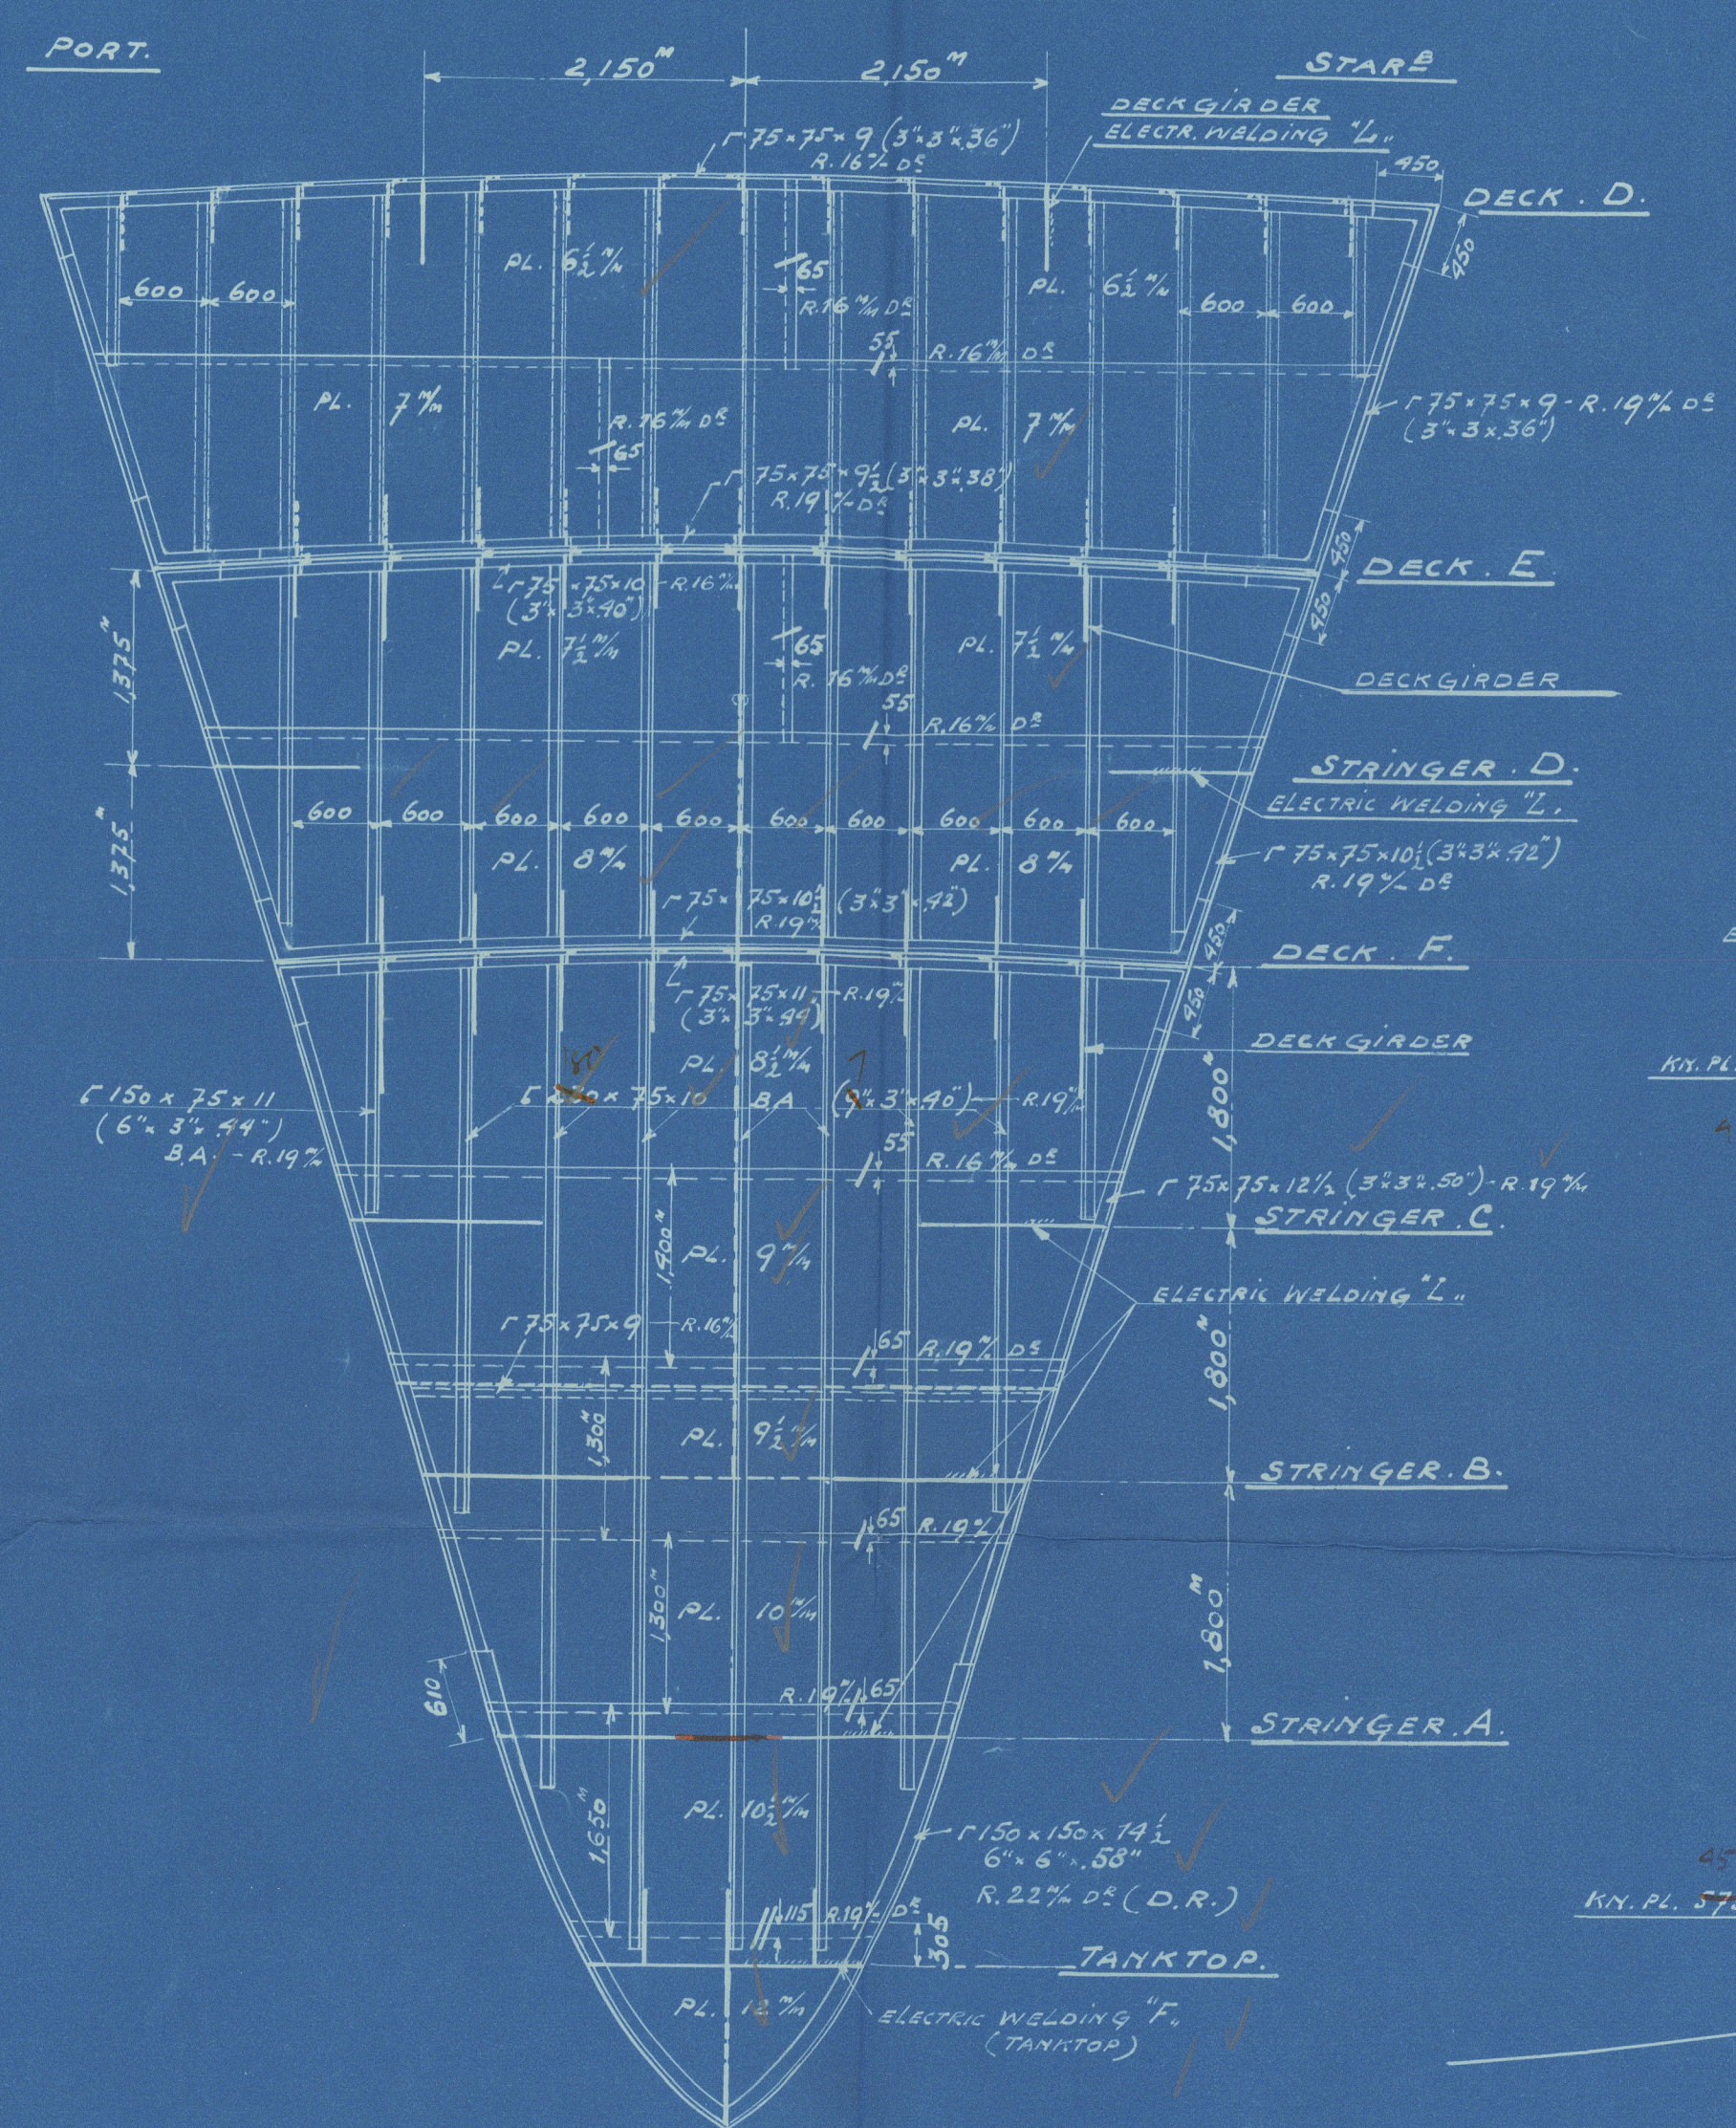

CHAIN LOCKER BULKHEAD No 5

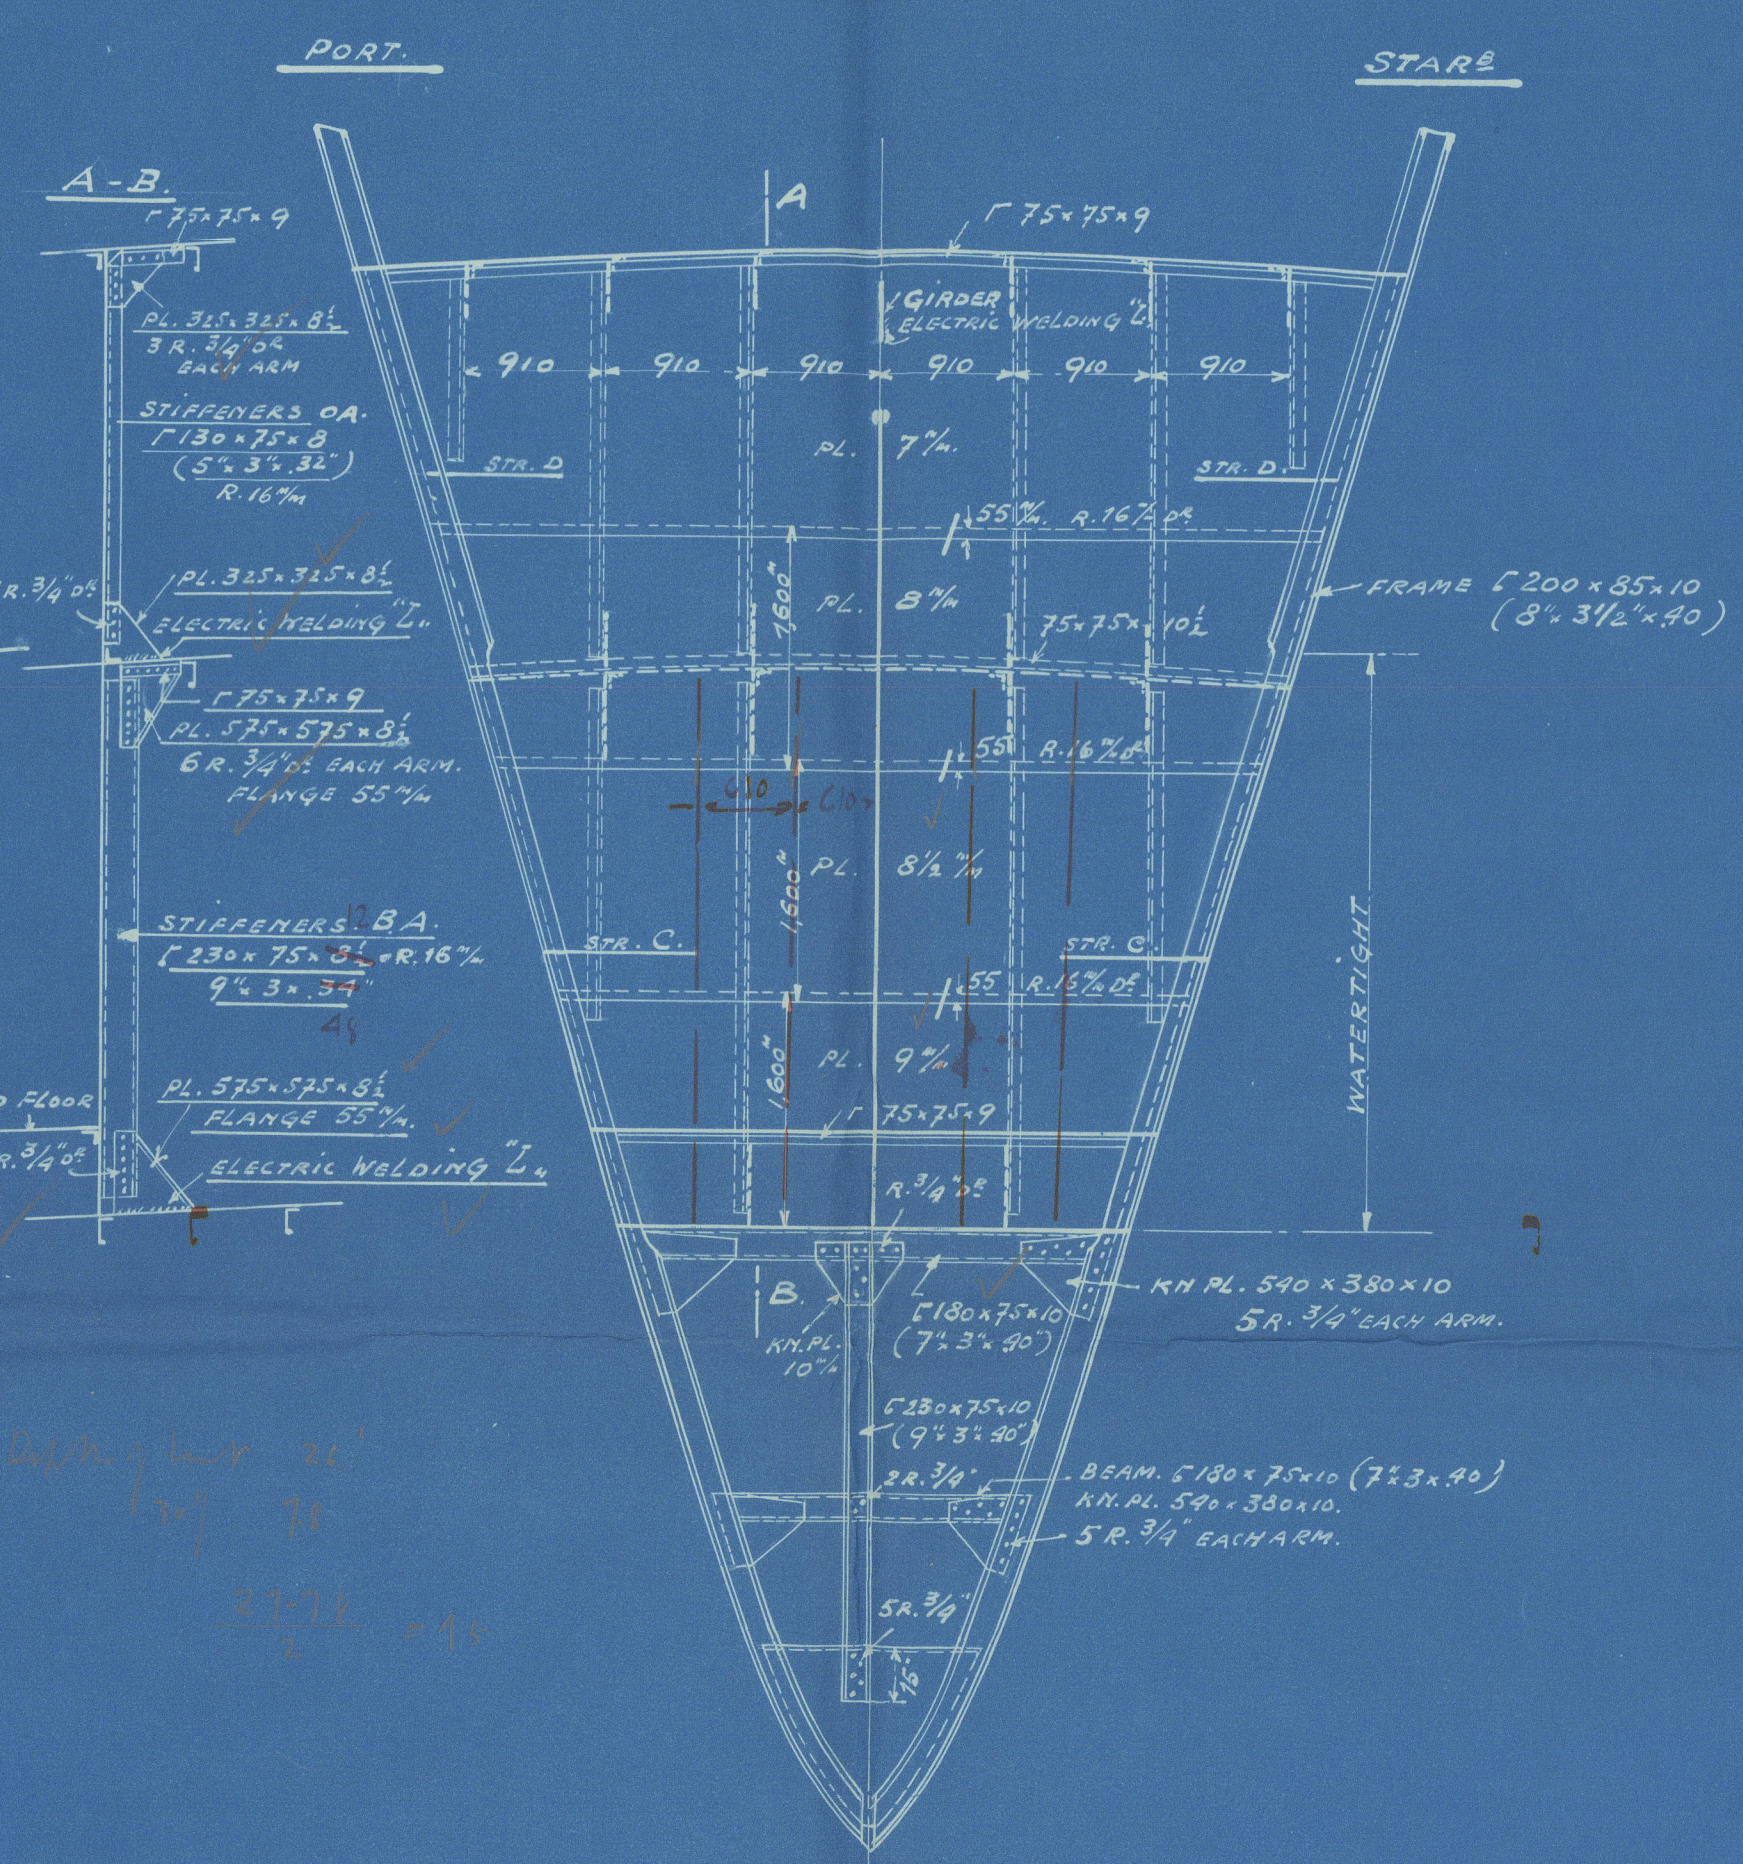

S/S "LEOPOLDVILLE"

NEW W.T. COLLISION BULKHEAD


AND CHAIN LOCKER.

SCALE 1/50


RIVETING.

- RIVETS IN SEAMS AND BUTTS. 4 1/2 DIAM. APART.
- RIVETS IN BOUNDARY ANGLES TO BULKHEAD 4 1/2 DIAM. APART.
- " " " " " DECK AND SHELL PL. 5 DIAM. APART.
- " " STIFFENERS TO BULKHEAD 7 DIAM. (IN WAY OF PEAK TANK 6 DIAM. APART.)
- " " " " " WHERE NO BRACKET ATTACHMENT
- " " " " " 4 DIAM. FOR 15% OF STIFFENERS LENGTH.


VIEW ON STRINGER C.

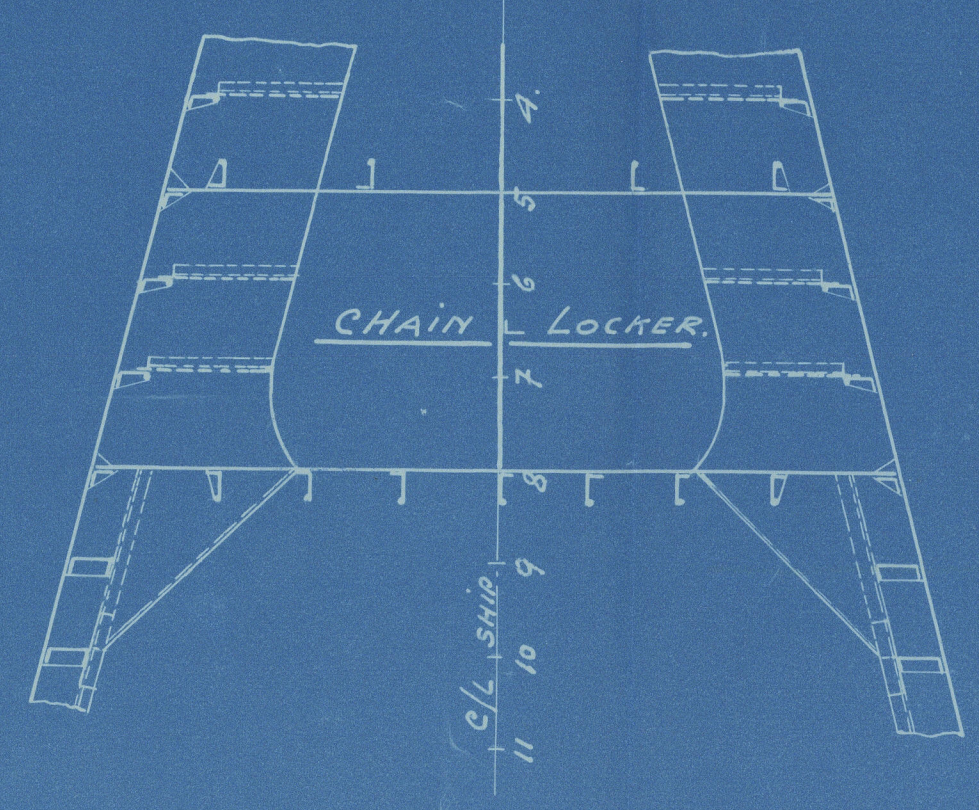

VIEW ON PERFORATED FLOOR

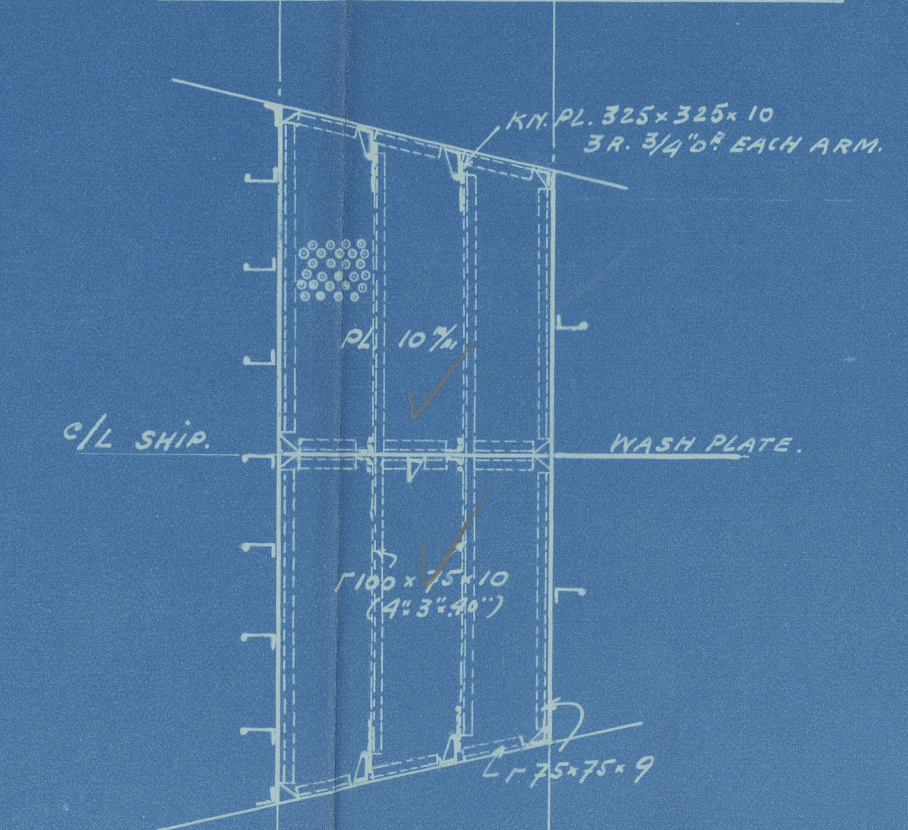

VIEW ON STRINGER B.

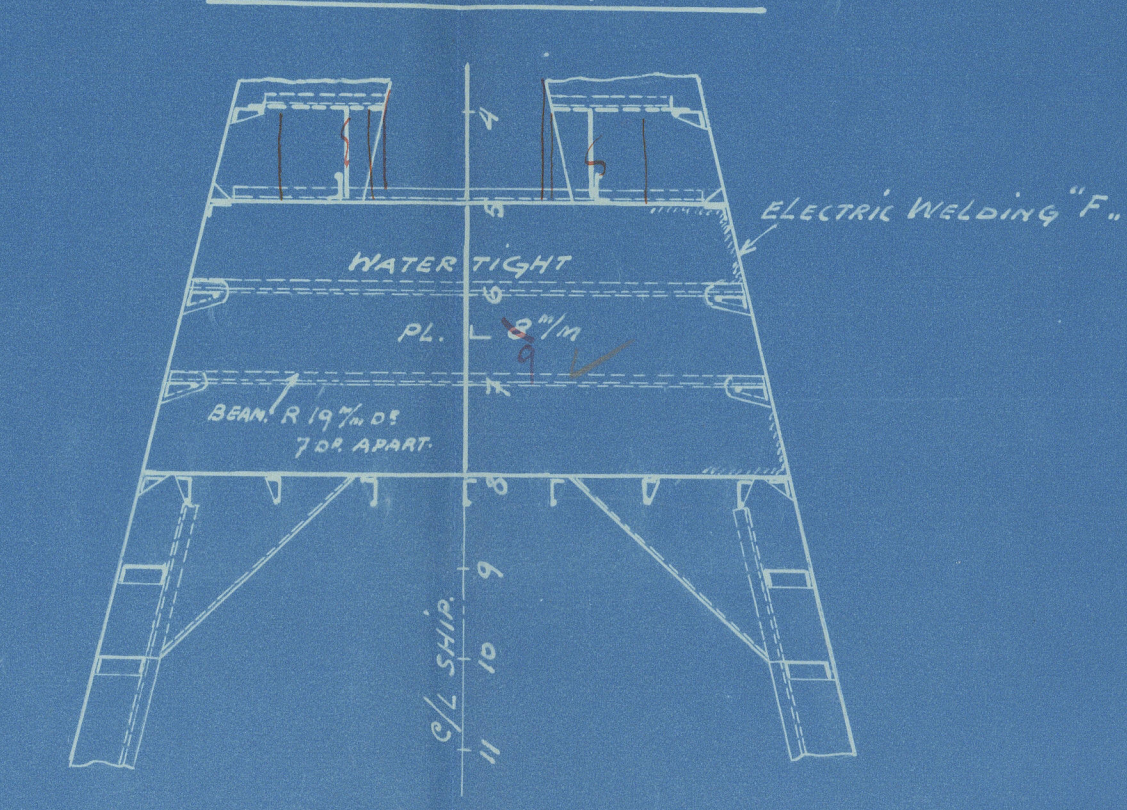

FOR PAINTING ARRANGEMENT
SEE PLAN No 1899-6-1.