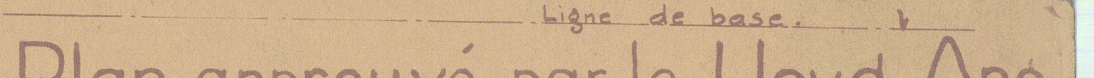


Equipment(Armement)

Rivetae

COUPE AU MAITRE  
Midship Sec  
ECHELLE  $\frac{1}{25}$  aut 16585

Dates	Name	VPOB
3-2-27	Wm. Ray	
10-2-27	C. Henry Hart	
	Wm. Ray	
	Jos. Hart	
	Sidney	

PLAN No 1  
Nº Arch.

Remplace :  
Remplace par :

Nº623  
© 2019  
GB.M.C.  
S.S. L'Espresso  
Mod's Regis  
Dillon

CHANTIER NAVAL  
JOHN COCKERILL  
HOBOKEN