



# NEWFOUNDLAND

NEW SELF CONTAINED FEED WATER TANK  
WITHIN FORMER DEEP TANK (FITTED APRIL 1942)

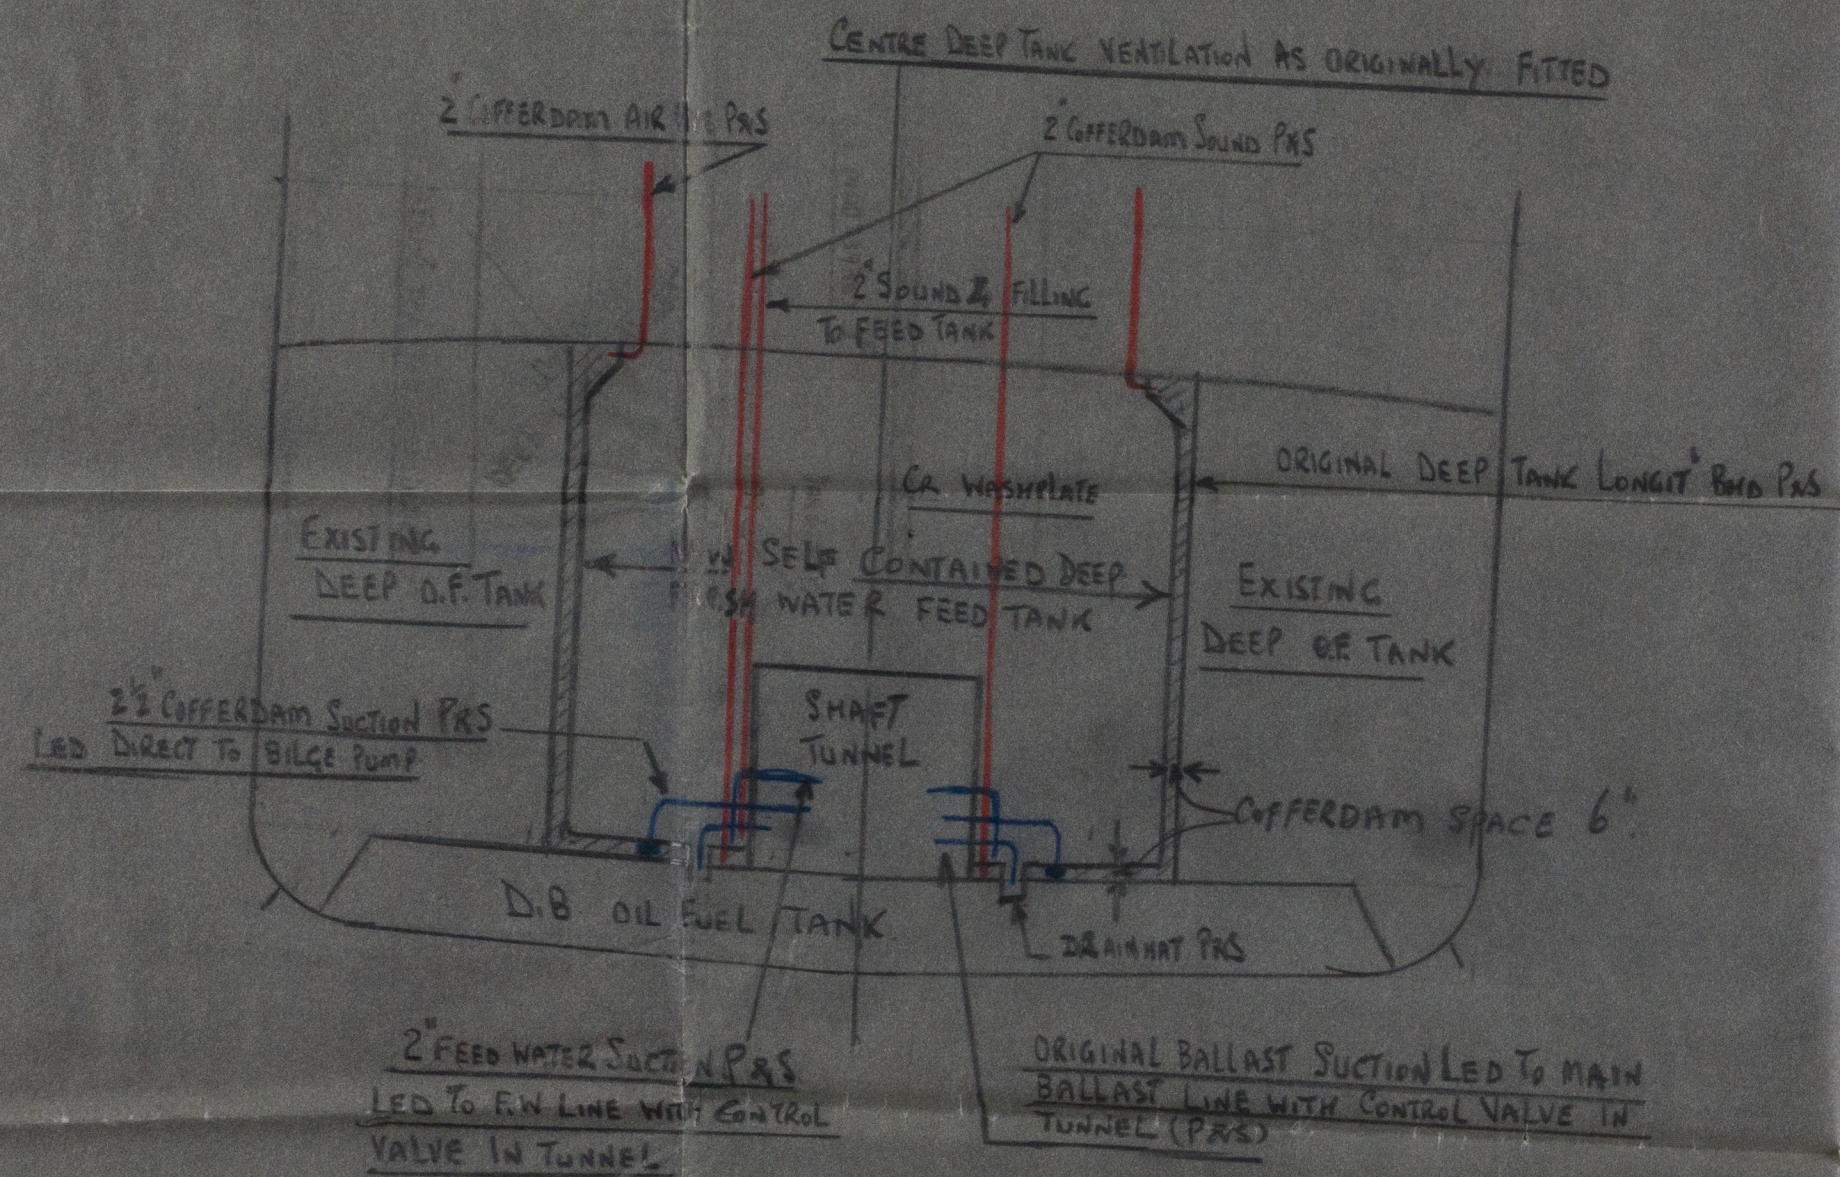

TRANSVERSE SECTION

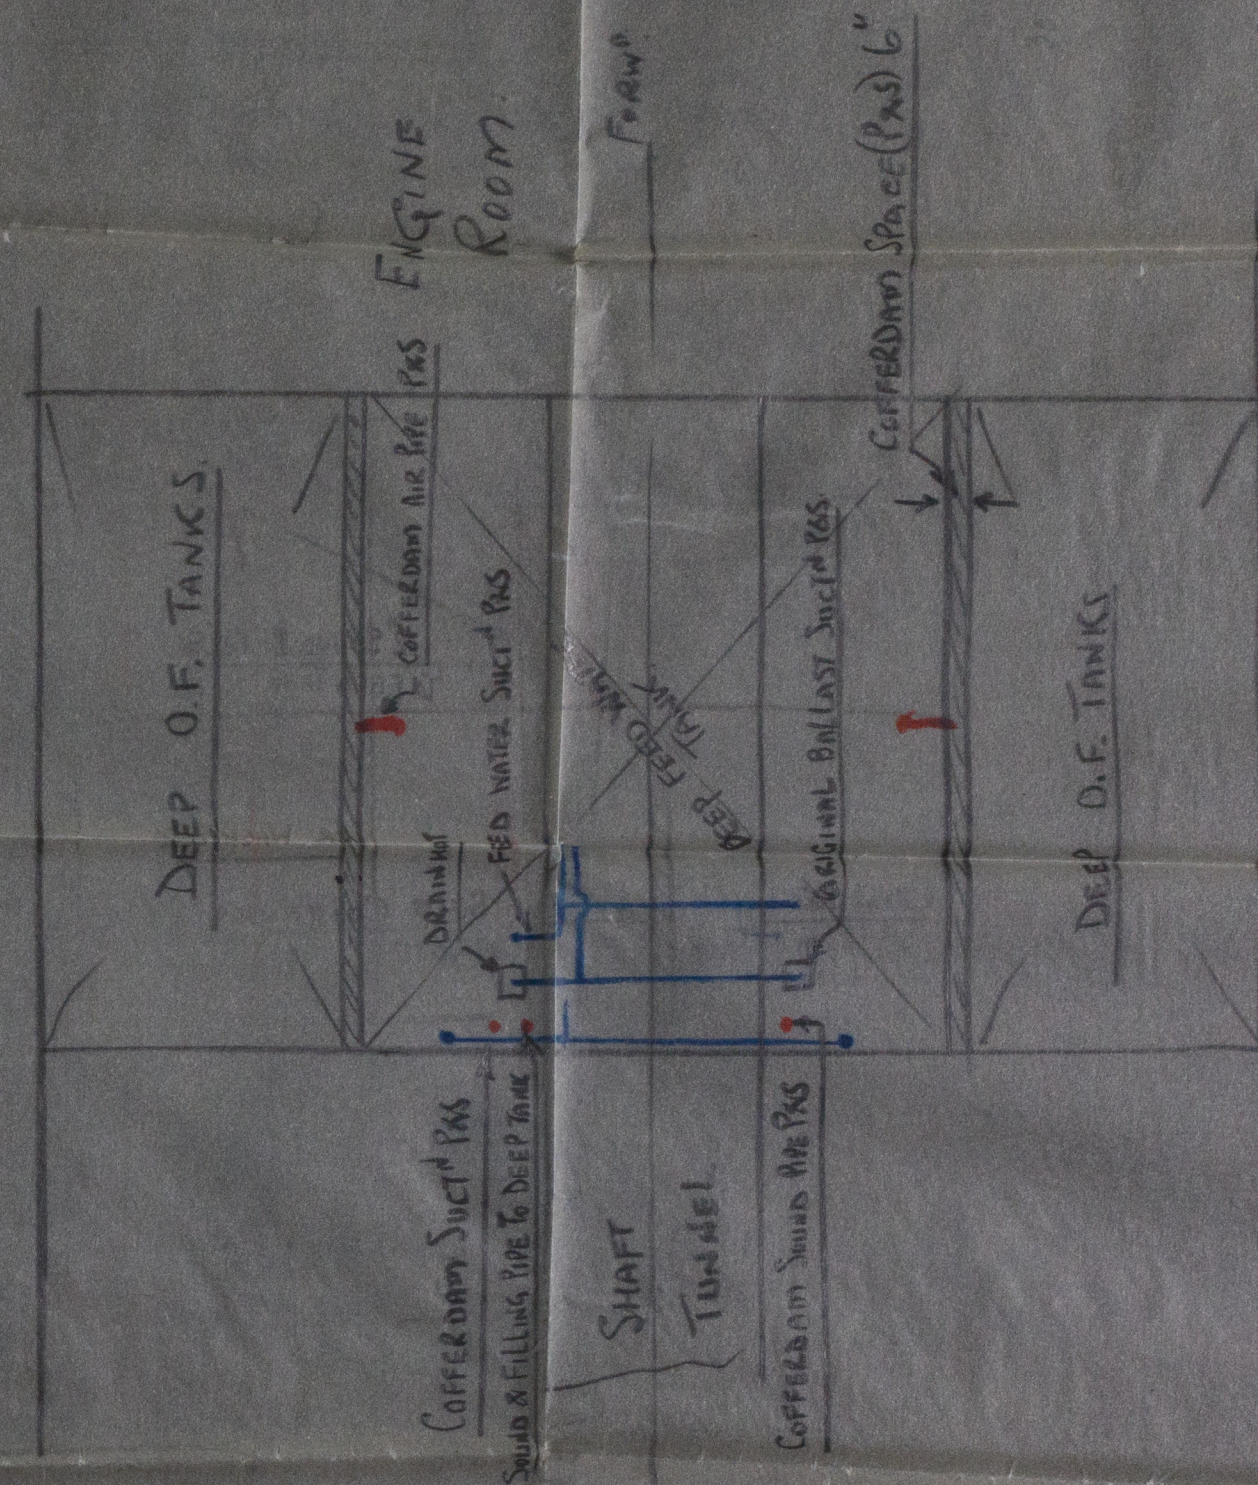

PLAN View