


TENSILE STRENGTH OF MATERIALS

| | |
|---------------------------------|-------------------|
| CYL. SHELL PLATES & BUTT STRAPS | = 30 TO 34 TONS/D |
| GIRDER PLATES | 28 - 32 |
| MANHOLE DOUBLING | 27 - 30 |
| ALL OTHER PLATES & FURNACES | 26 - 30 |
| LONG STEEL STAYS | 28 - 32 |
| SCREW STAY & RIVET BARS | 26 - 30 |

WORKING PRESSURE 200 LBS/D

TEST 350

ALL PLATES OF STEEL
ALL STAYS
ALL RIVETS
ALL TUBES OF IRON

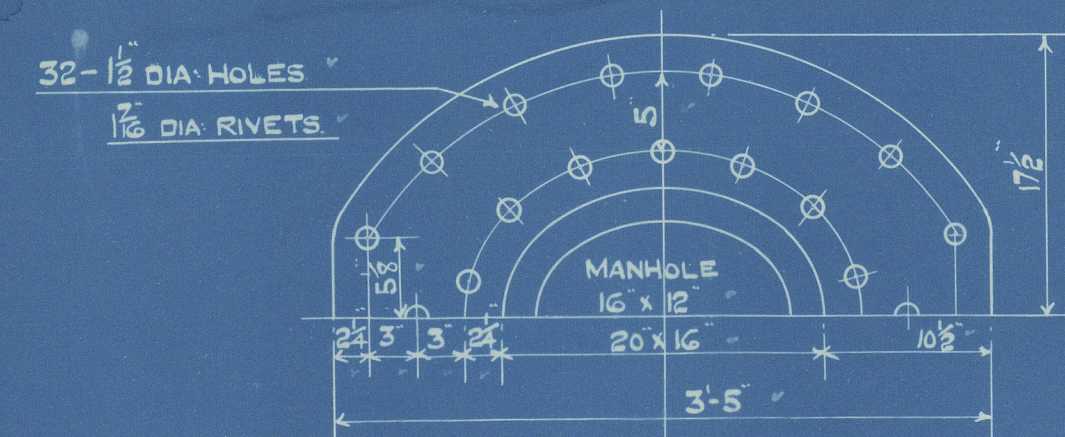

POSITION OF MANHOLE FIXED LATER

THESE TWO STAYS 3/4 DIA.
INSIDE NUTS 2 1/2 DEEP


DIA OVER THREADS
TO BE NOT LESS THAN
3/4

STEEL STAY 2 1/4 DIA.
SCREWED 6 TPI INSIDE
NUT 1/2 DEEP

STEEL STAY 2 3/4 DIA.
SCREWED 6 TPI INSIDE NUT 1 1/2 DEEP


FLANGE 3/2 DEEP

ALL CC BACK STAYS
NUTTED AT BOTH ENDS
WHERE NECESSARY WASHERS TO
BE FITTED UNDER NUTS IN CC'S
SCREW STAYS THRO' SHELL
TO BE CAULKED

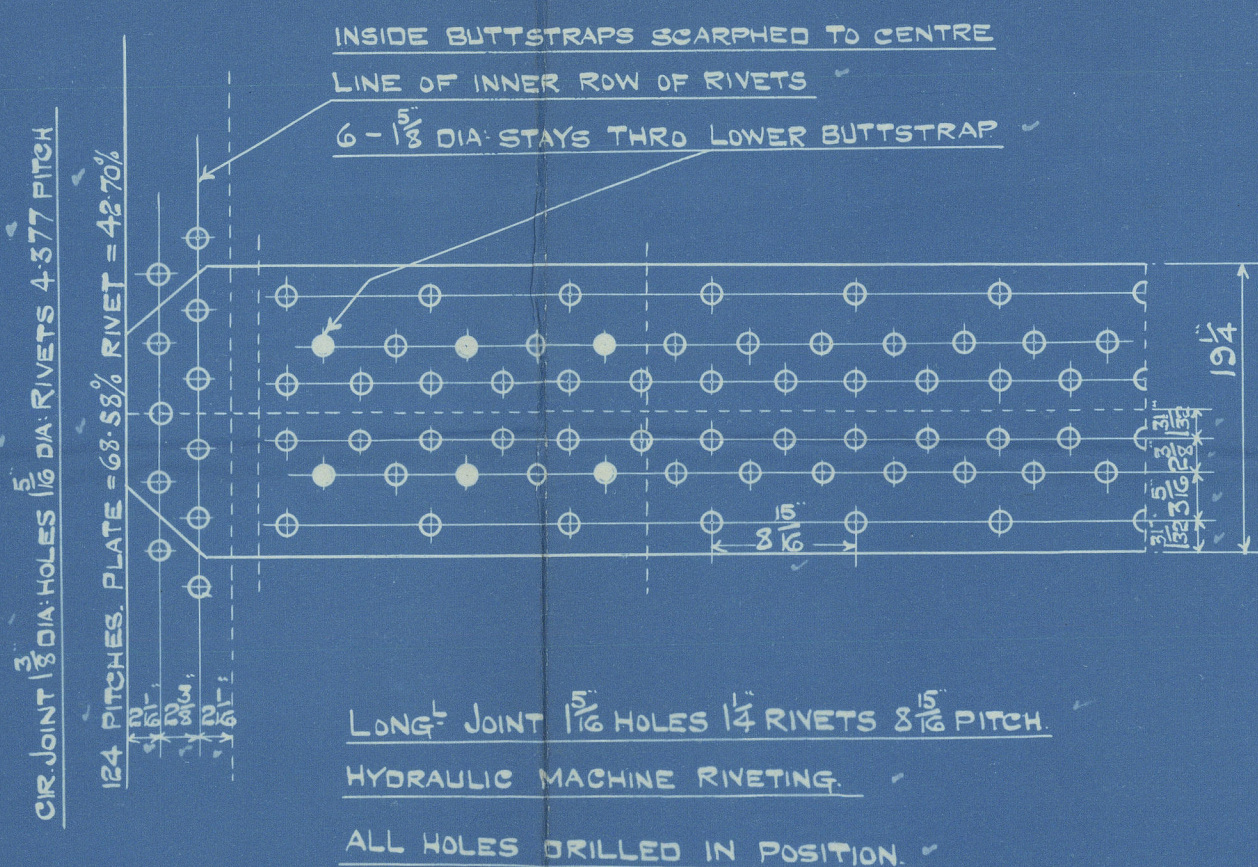

HYDRAULIC MACHINE RIVETING
ALL HOLES DRILLED IN POSITION

| | |
|------------------|-----------|
| OUTER BUTTSTRAPS | 1/2 THICK |
| INNER | 1/2 |
| PLATE | = 35.31% |
| RIVET | = 39.32% |
| COMBINED | = 38.43% |

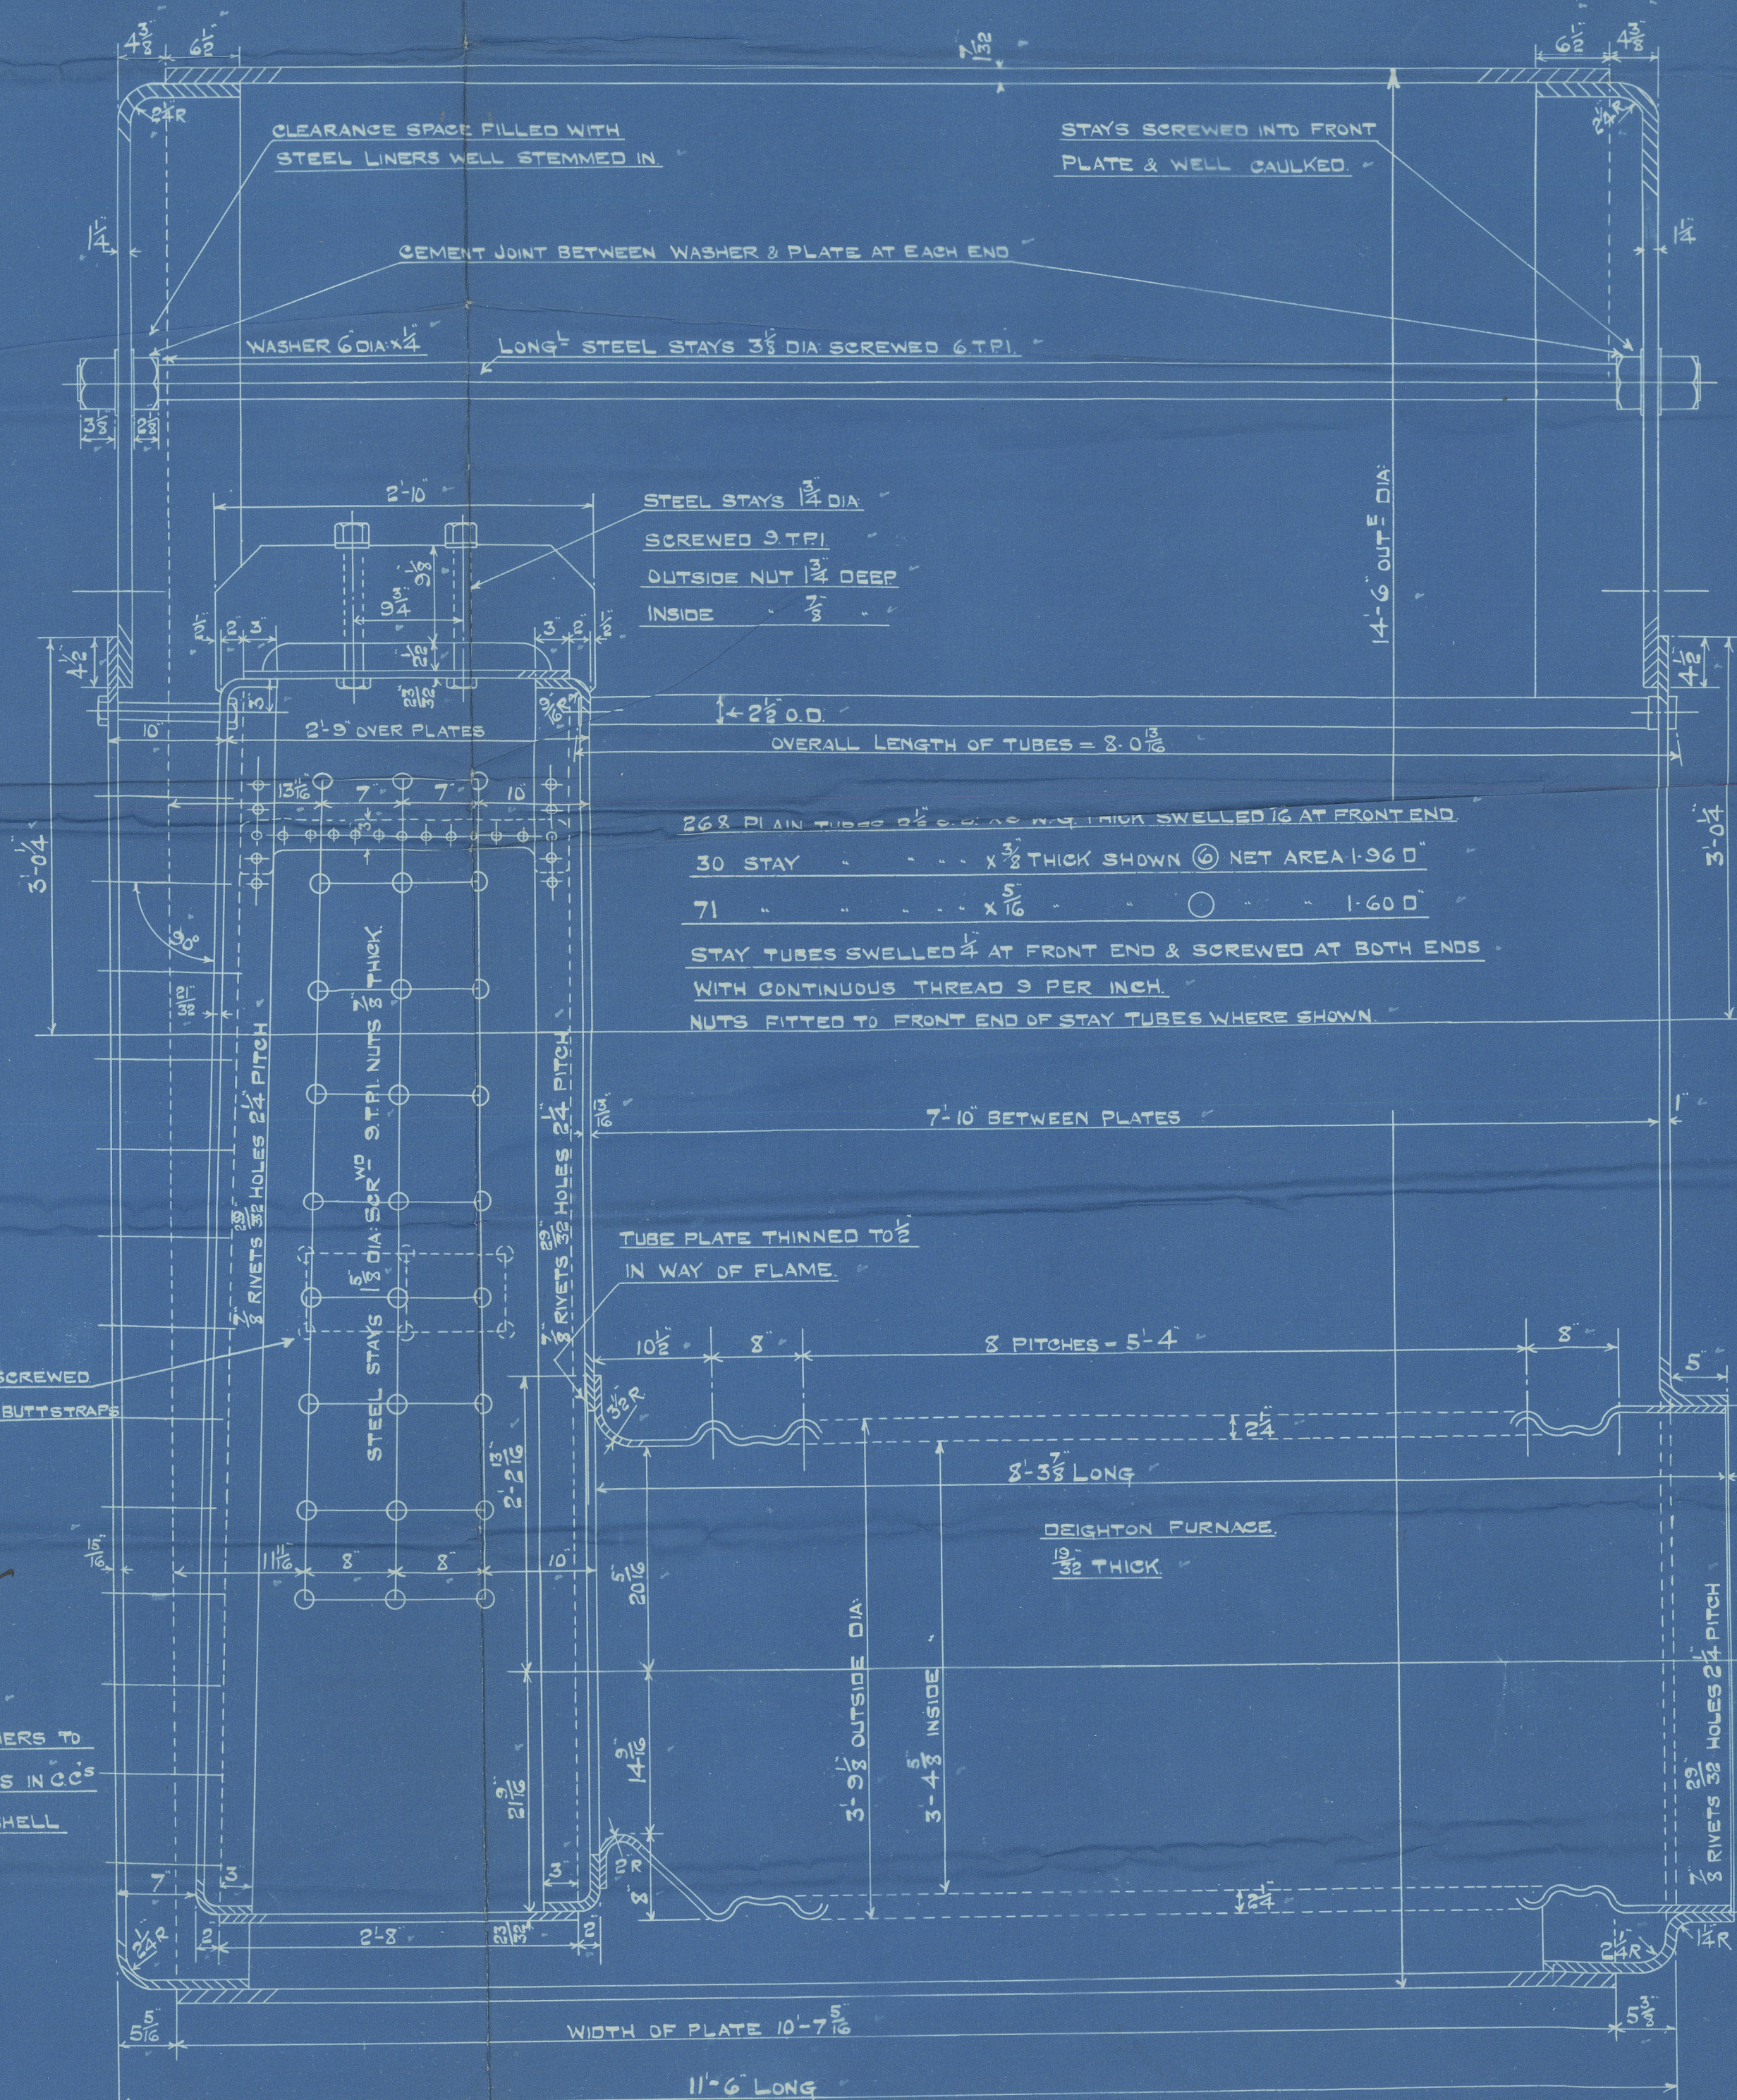

TOTAL HEATING SURFACE (2 BOILERS) = 4660 D FT

TO LLOYDS SURVEY
TO BOARD OF TRADE SURVEY UP TO POINT OF TEST

Modified & Returned
J. C. WIDHAM, RICHARDSON
ENGINEERING DEPARTMENT
21 AUBURN
NEPTUNE TOWER
WALKER
BATTLE-ON-THE

96/ C 11 X
25-7-23

MAIN BOILERS.

SCALE 1" = 1 FOOT

| | |
|---------------------|---------|
| N ^o 2019 | DATE |
| 1164 | 20/7/23 |
| 1166 | 20/7/23 |

B.374.

TENSILE STRENGTH OF MATERIALS



| | |
|---------------------------------|--------------------|
| CYL. SHELL PLATES & BUTT STRAPS | = 30 TO 34 TONS/0" |
| GIRDER PLATES | 23 - 32 |
| MANHOLE DOUBLING | 27 - 30 |
| ALL OTHER PLATES & FURNACES | 26 - 30 |
| LONG STEEL STAYS | 28 - 32 |
| SCREW STAY & RIVET BARS | 26 - 30 |

WORKING PRESSURE 200 LBS/0"


TEST 350

ALL PLATES OF STEEL
ALL STAYS
ALL RIVETS
ALL TUBES OF IRON


THESE TWO STAYS 3 1/2" DIA.
INSIDE NUTS 2 1/2" DEEP

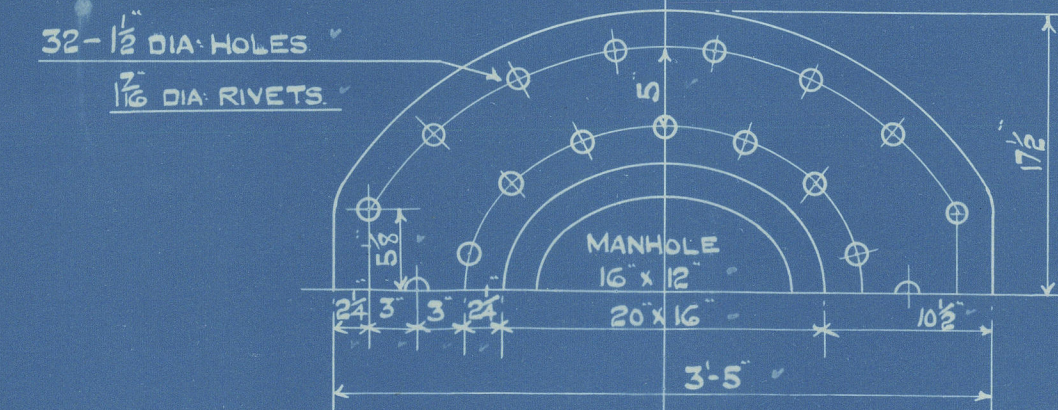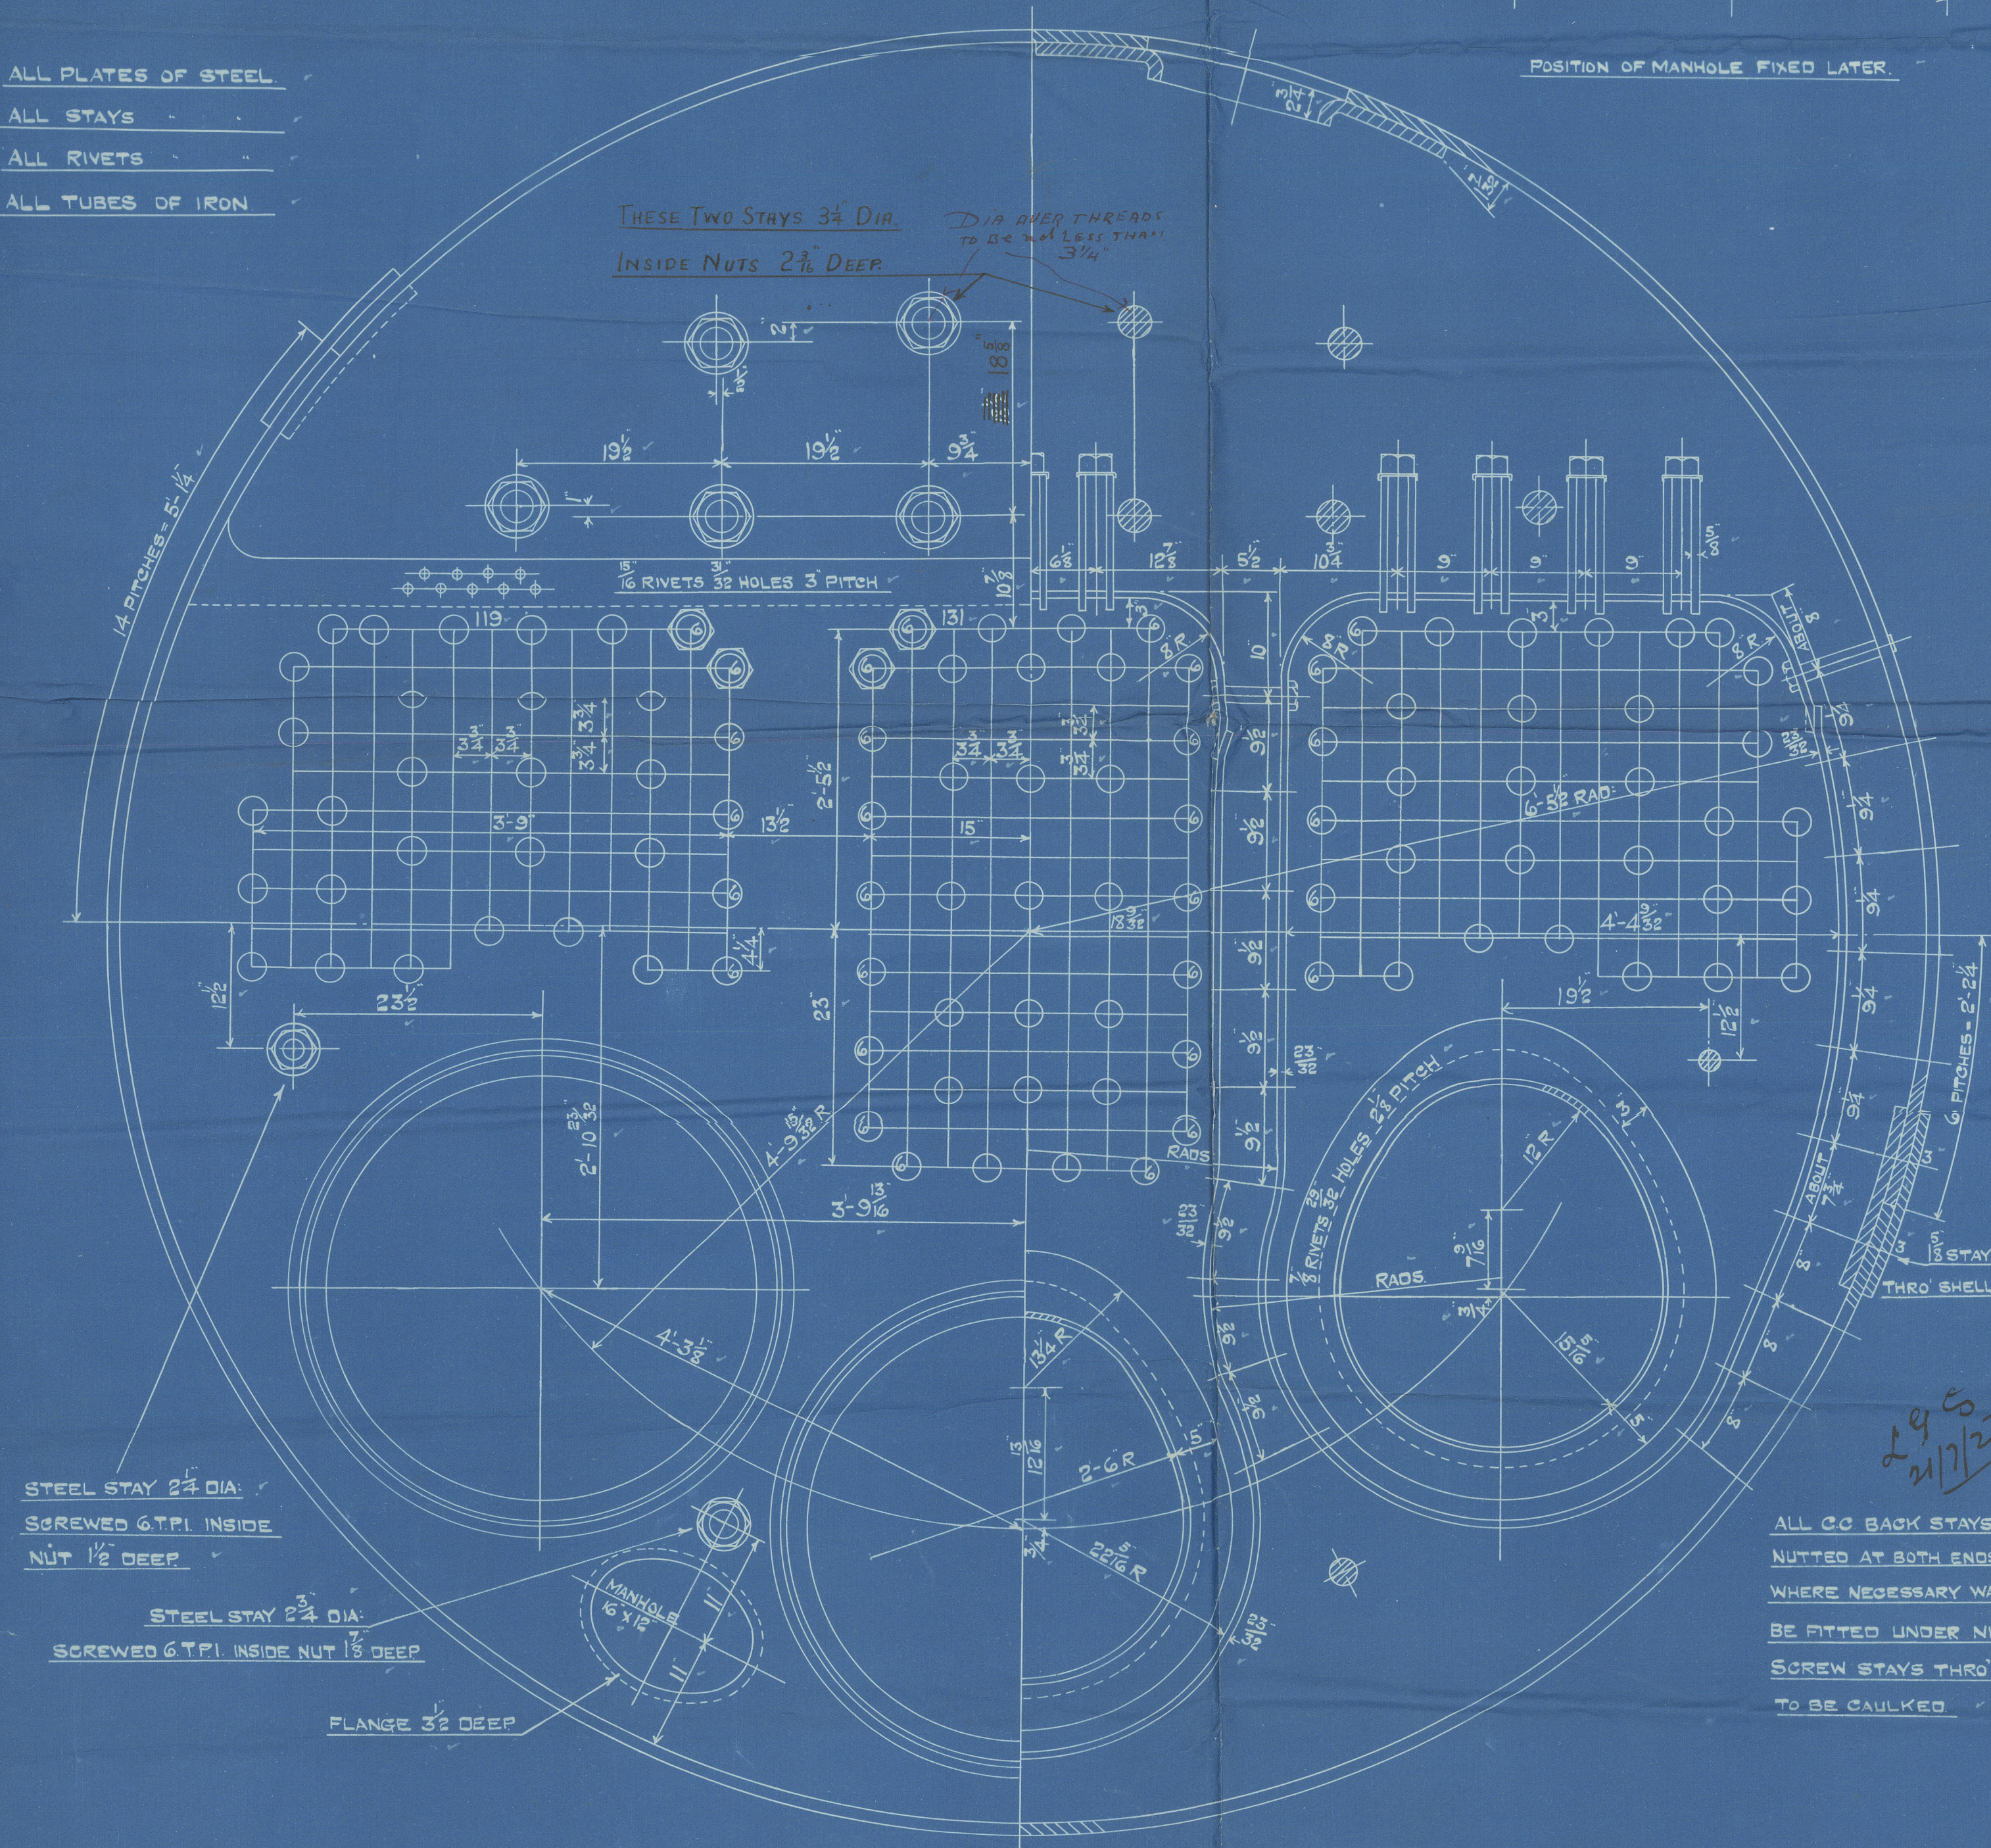

POSITION OF MANHOLE FIXED LATER

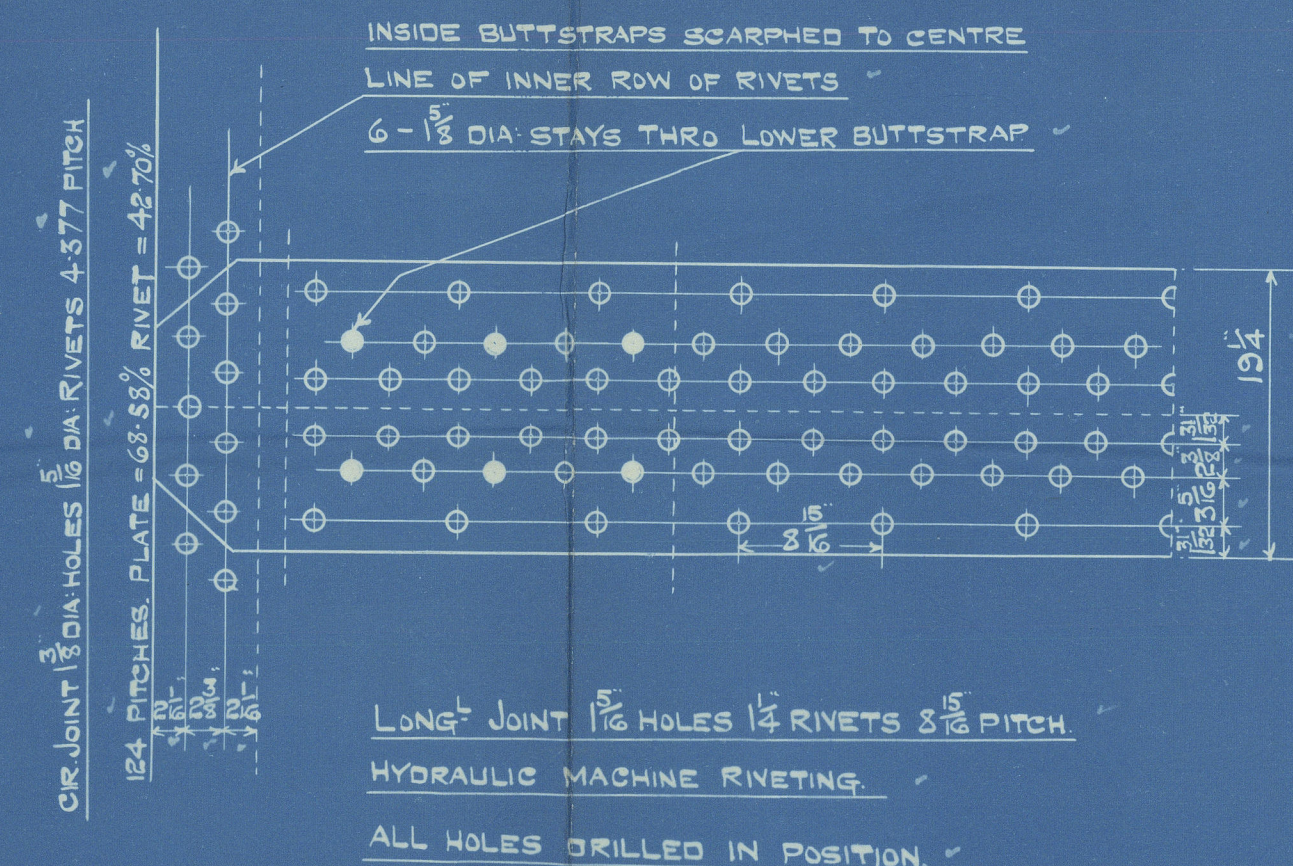

OUTER BUTTSTRAPS 1/8" THICK
INNER 1/16"
PLATE = 85.31%
RIVET = 89.32%
COMBINED = 88.48%

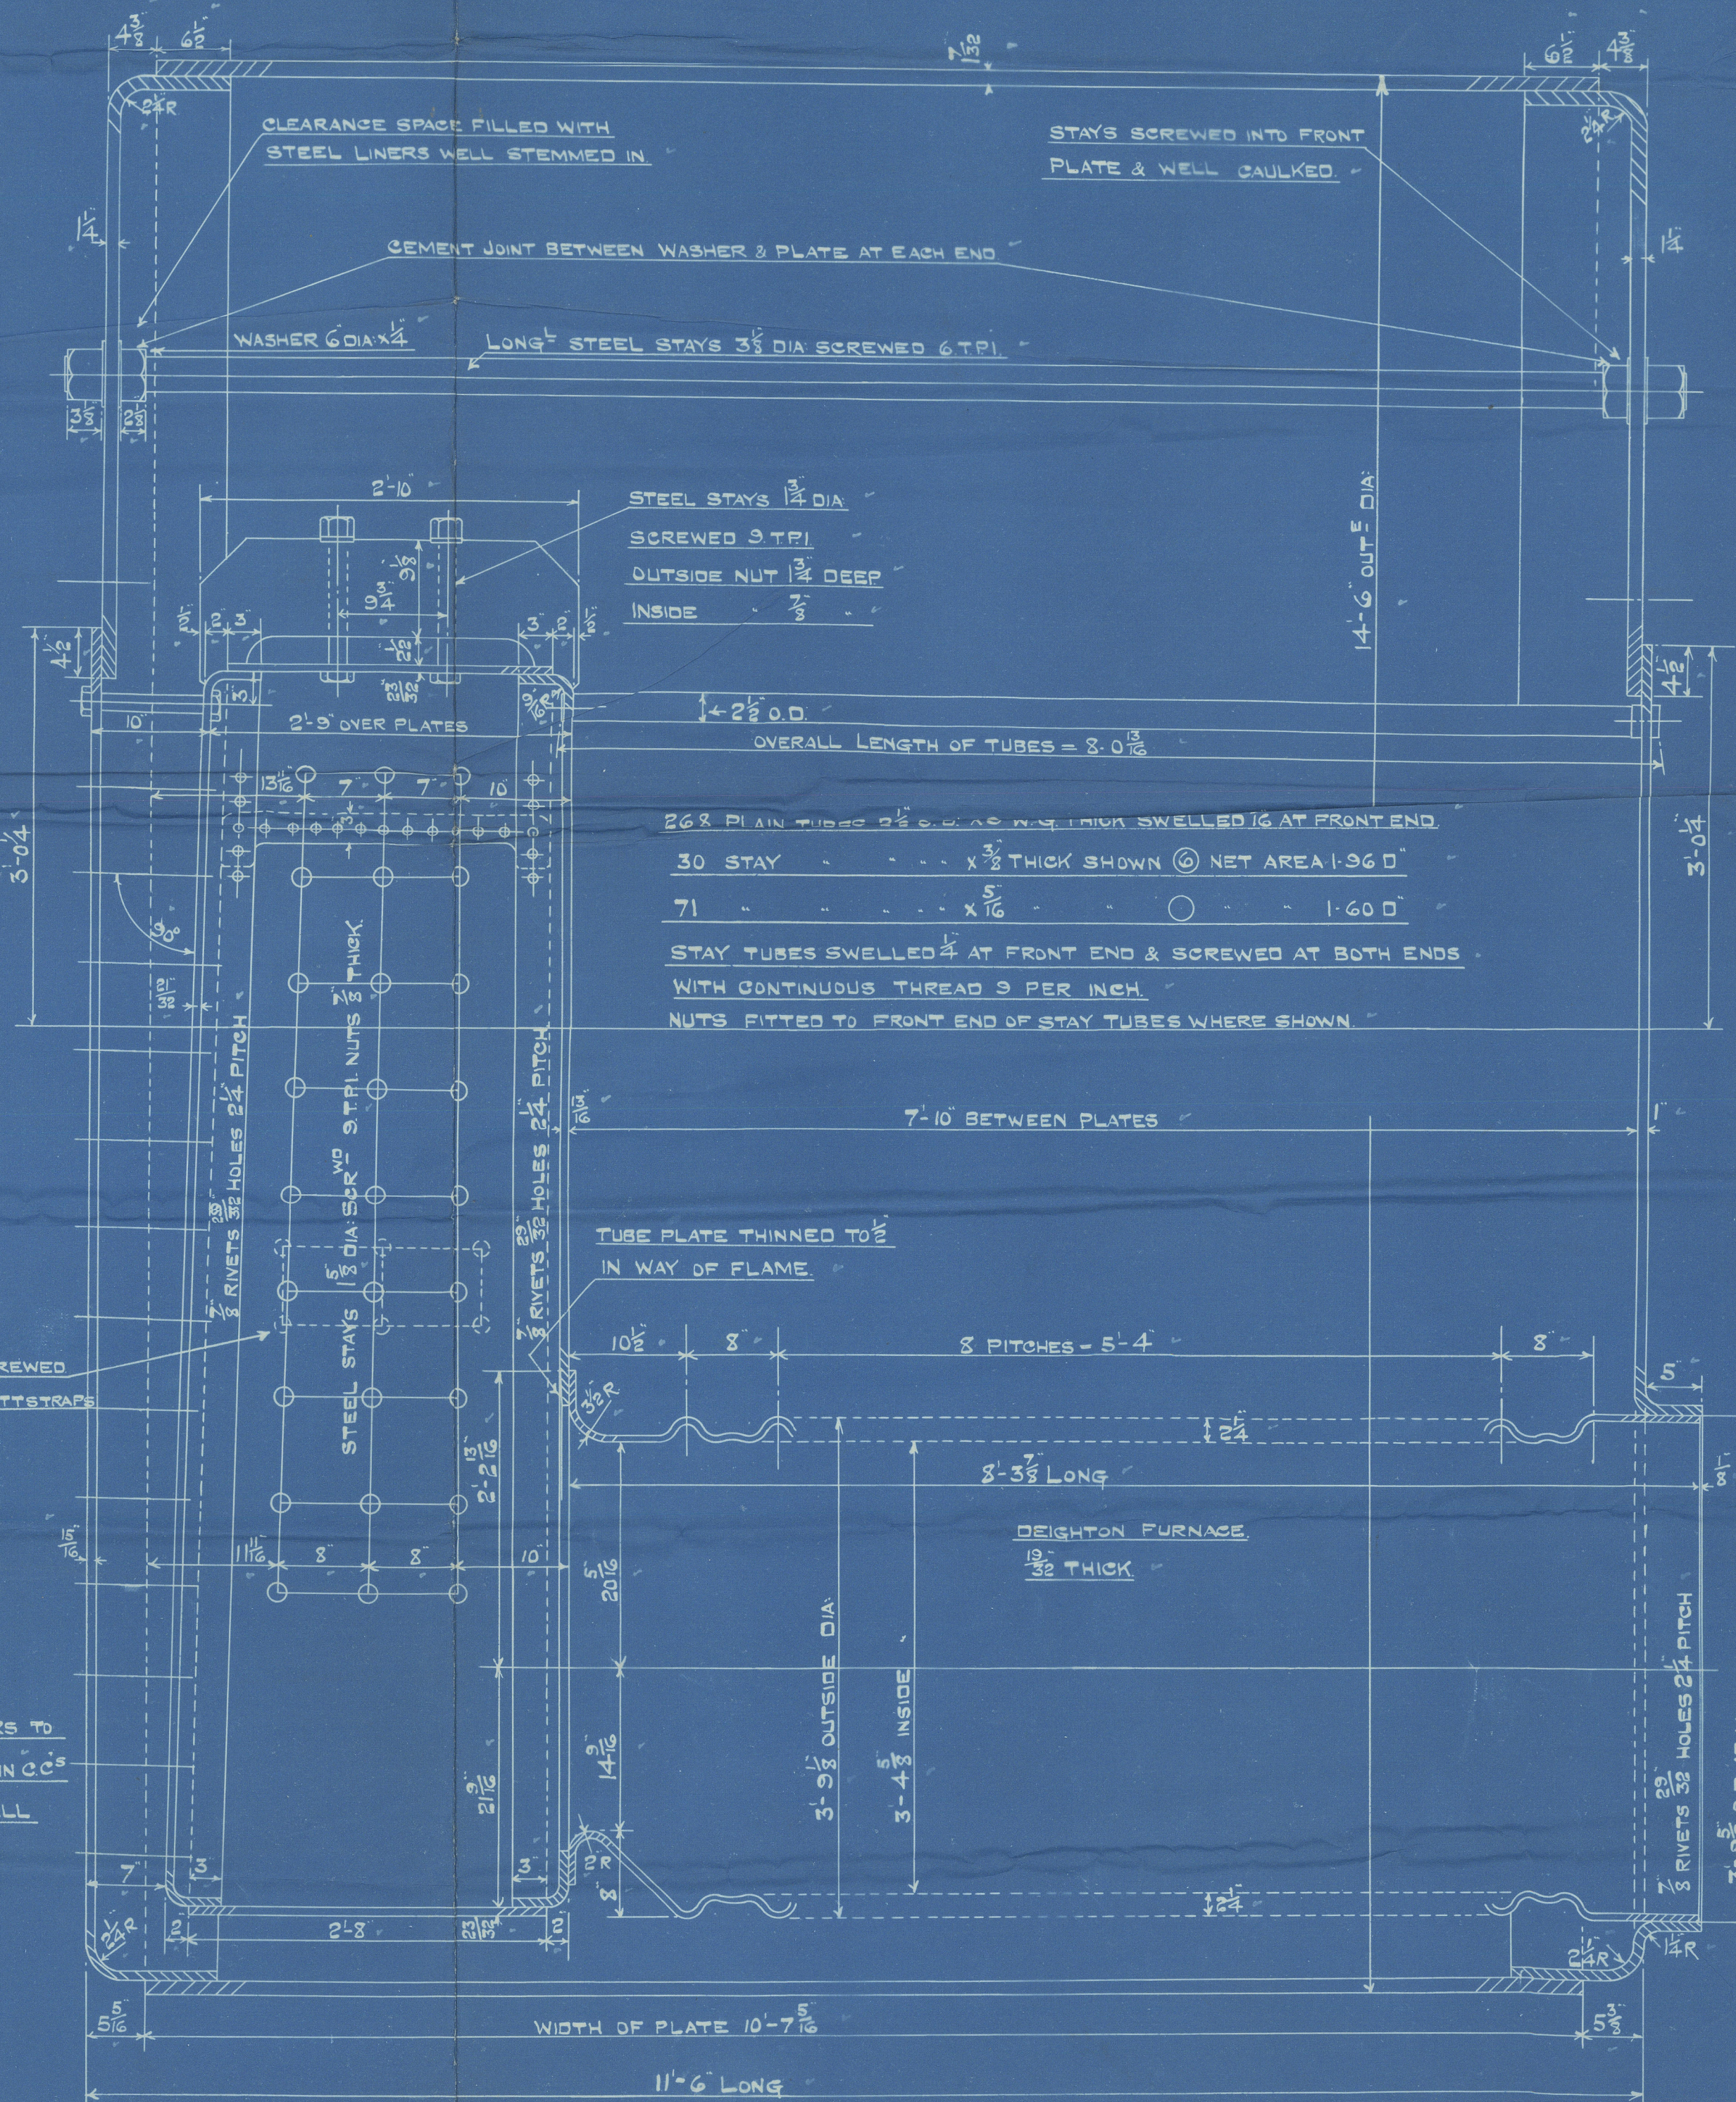

TOTAL HEATING SURFACE (2 BOILERS) = 4660 0 FT

26.7.23

TO LLOYD'S SURVEY
TO BOARD OF TRADE SURVEY UP TO POINT OF TEST

Modified & Returned
WALKER



20.7.23

WALKER

For enclosure to
Messrs Lloyd's Surveyor
From
SWAN, HUNTER, & WIGHAM RICHARDSON, LTD.,
NEPTUNE WORKS, WALKER.

2 OFF (EACH N°)

MAIN BOILERS.

SCALE 1" = 1 FOOT

13374

N° 2019
DATE
1164 20/7/23
1166 20/7/23

S H + W N


4/ - Boilers 1166 for Ship 1227.

up 200 lbs Test 350 lbs

Submitted to London 21/7/23

London approval 26/7/23

S H run advised 27/7/23

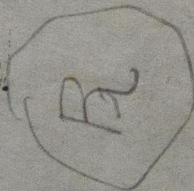

79633

"S.S. Oriskany"

NWC. 77633.

S.S. ORISKANY

NEWCASTLE ON TYNE.

Port No 77633.

W255-0295



© 2019

Lloyd's Register
Foundation

25000
- 07115

17885 A



© 2019

Lloyd's Register
Foundation