

S.S. Nos. 248 · 9


STANDARD "B" TYPE

MIDSHIP SECTION

Scale 1/2" = 1' foot
 Length between perpendiculars 400'-0"
 Breadth moulded 58'-0"
 Depth moulded 31'-0"
 To class 10041 Lloyd's Register

NUMERALS	
BREADTH MOULDED	58'-00"
DEPTH MOULDED	31'-00"
TRANSVERSE NUMBER	200
LENGTH	400' x 89' LONGITUDINAL NUMBER 33200
5 TO BRIDGE DECK	10'-00"
3 UPPER DECK	12'-00"
3	18'-00"
EQUIPMENT NUMBER	
HULL	400 x 89 x 31
POOP BRIDGE FORECASTLE	200 x 8 x 15
DECKHOUSE	31'5 x 8 x 15
	34589

EQUIPMENT	
2 BOWER ANCHORS	60 CWT'S STOCKLESS
1 BOWER ANCHOR	50'
1 STREAM ANCHOR	16'4" EX STOCK
1 KEDGE ANCHOR	7'
12 7/8 FATHOMS	2 1/2" STUD LINK CHAIN CABLE
30	1 1/4" STREAM CHAIN OR 3/4" STEEL WIRE ROPE
120	14" HEMP HAWSELS OR 3/4"
2 LENGTHS	30 FATHOMS 2" HEMP HAWSELS OR 2 1/2" S.W. ROPE
2	30
	7' WARPS OR 2 1/2" S.W. ROPE

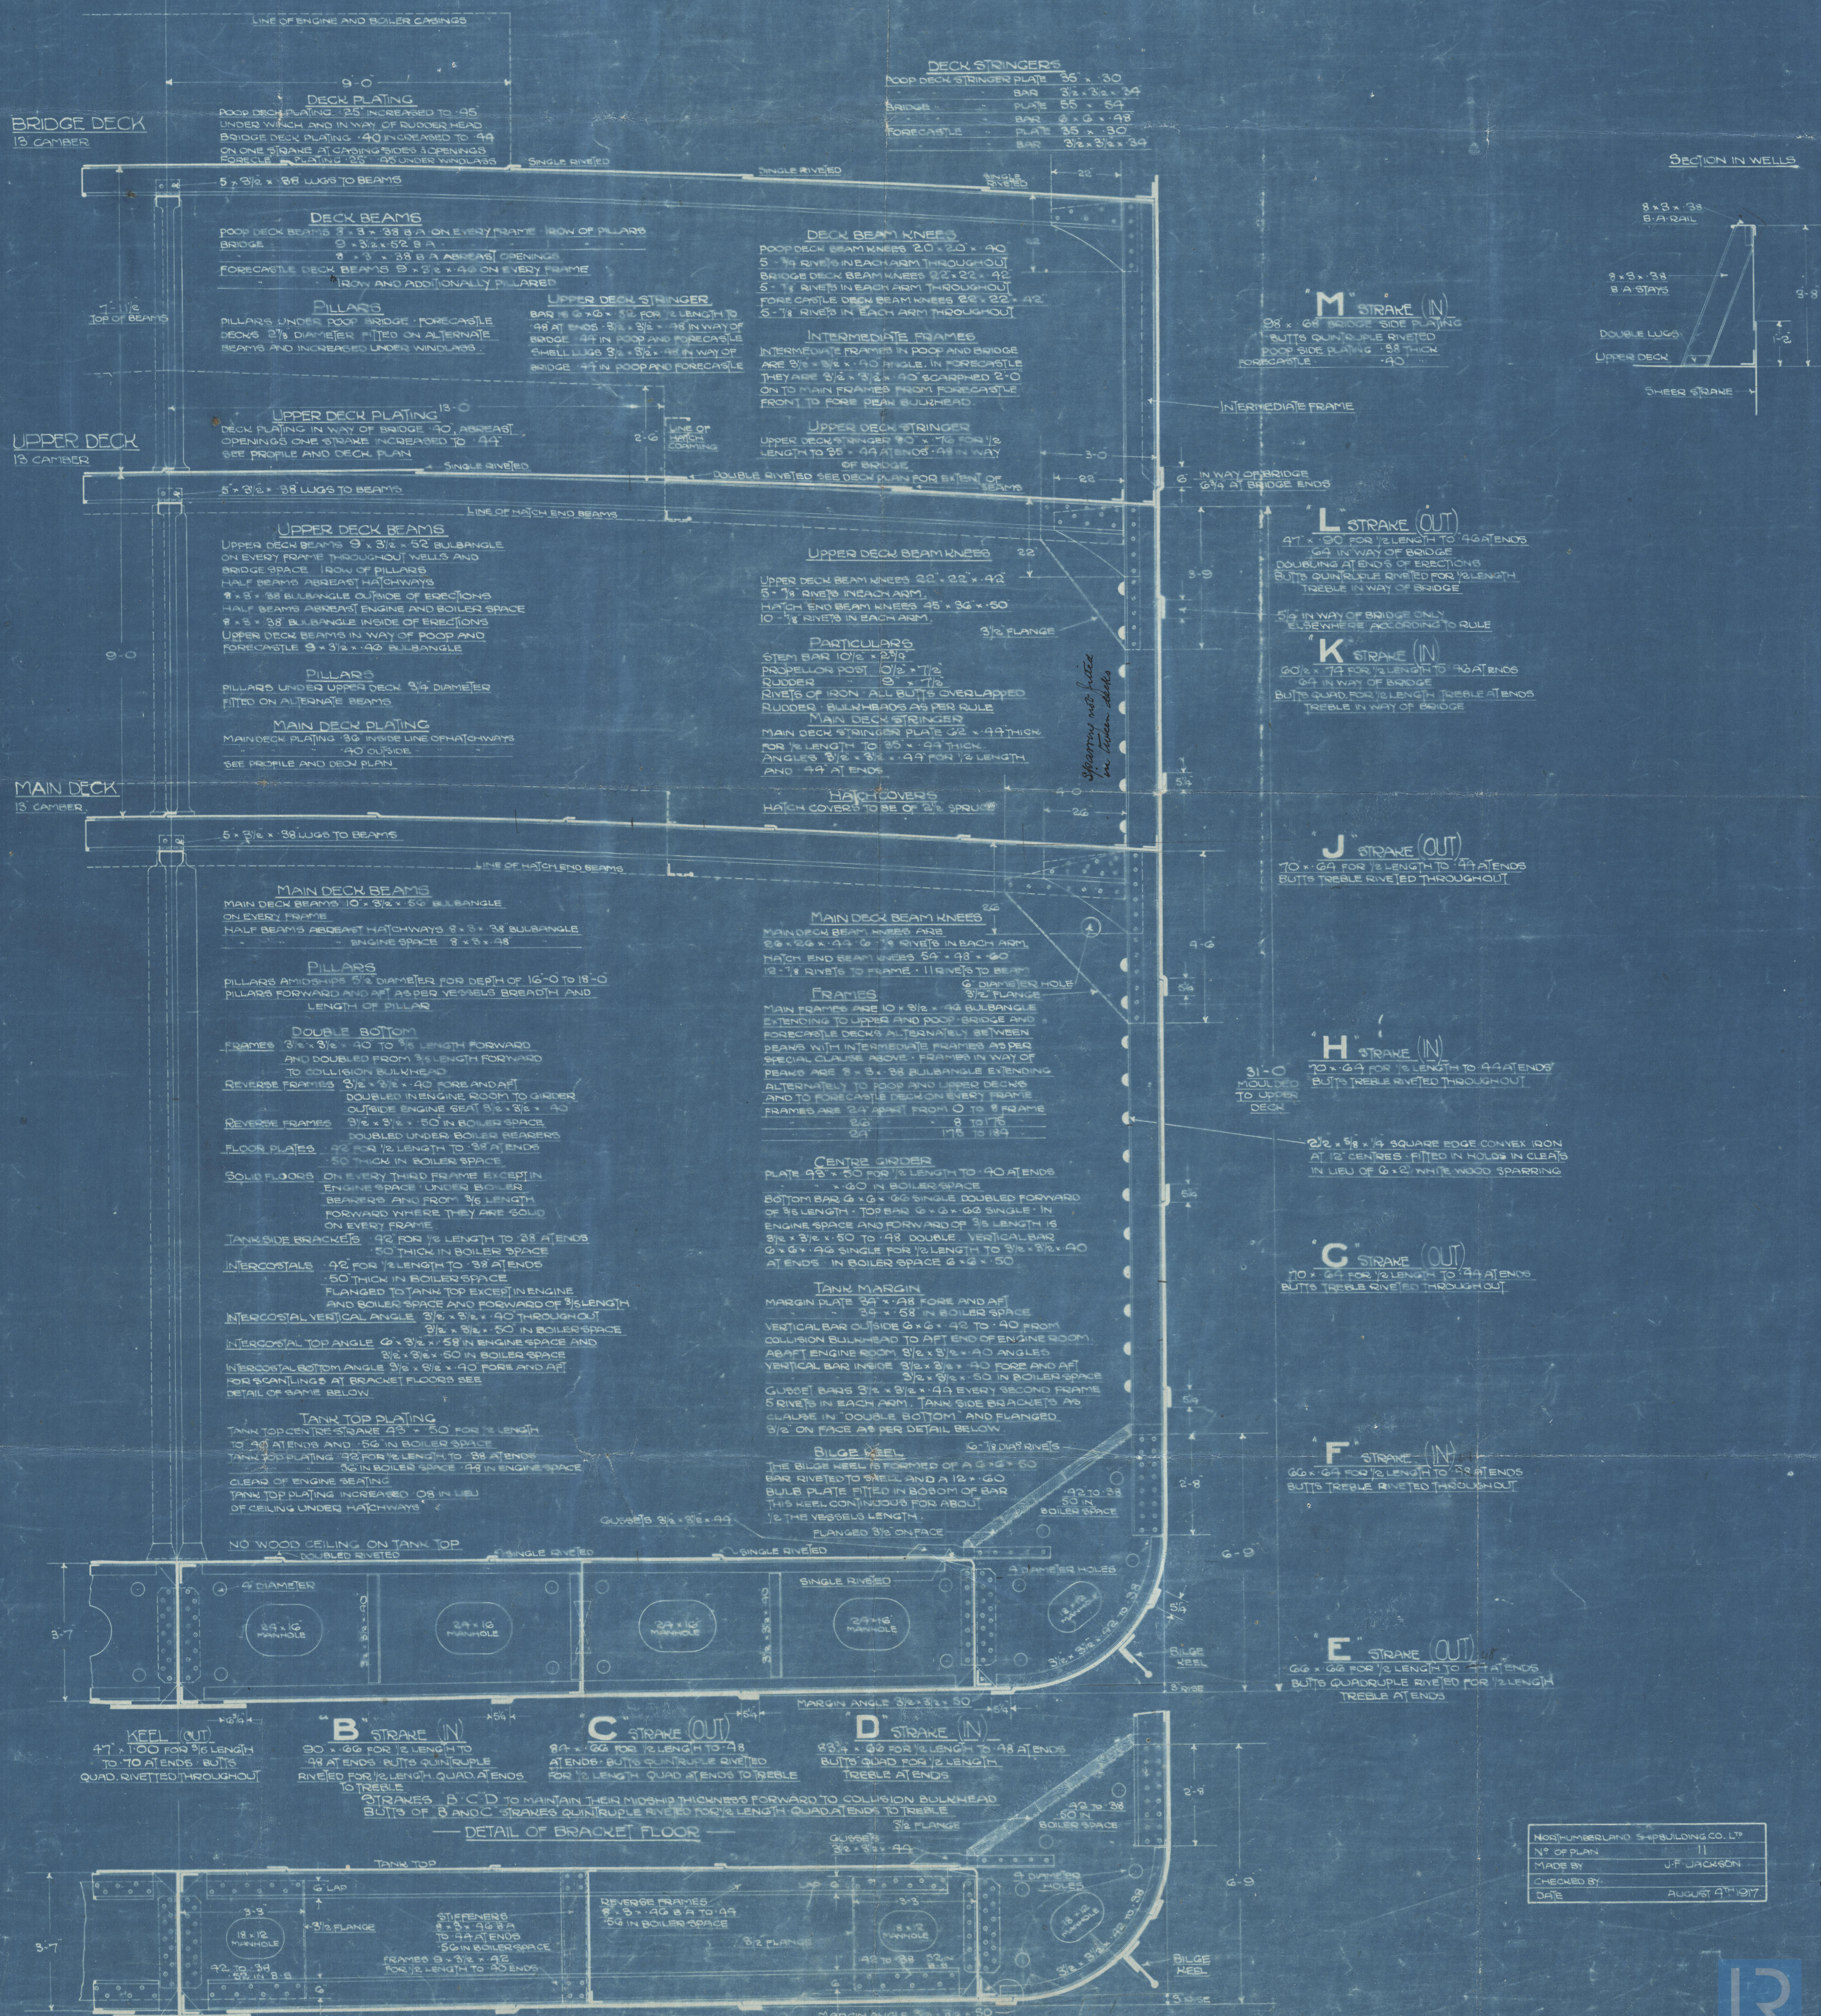

 N° OF PLAN 11
 MADE BY J.F. JACKSON
 CHECKED BY
 DATE AUGUST 4th 1917



W256-0033

Northumberland S. Co.
SS 248
Standard B Type
Guidship Section

Persier
EX

SS WAR BUFFALO
NEWCASTLE ON TYNE.

Report No. 71020

W256-0033



© 2020

Lloyd's Register
Foundation