



SCALE $\frac{1}{2}'' = \text{ONE FOOT.}$

22.12.11
18-3-12

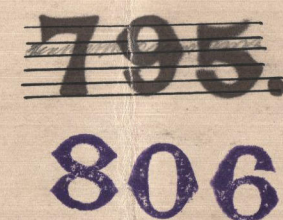

Midship Section
W. Brass 260
00. N. 806.

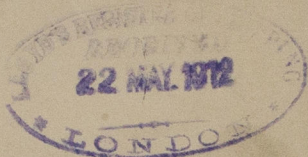

S.S. Penolven



Sept. Rpt. 14442.

W256-0063



© 2020

Lloyd's Register
Foundation