

22.12.11  
18.3.12

Beams marked A. Plate 15" x 50" two angles 5" x 5" knees = 42" x 50"  
B. Beams 9" x 4" x 2" = 25" x 54" x 9 1/2" x 3 1/2" x 56" Built angles.

# PROFILE.

SCALE 1/4" IN = ONE FOOT.

Plan of Deck approved by Lloyd's

Upper Deck Beams


Beams under P. B. Deck	8 1/2" x 3 1/2" x 50" Built Angs. Knees 27" x 50"
2	7" x 3" x 42" "
3	9" x 3 1/2" x 54" "
4	8 1/2" x 3" x 50" "
Beams in Deck	6" x 3" x 40" "
5	21" x 42" "

Note: No Hatch fore & afters fitted wood covers fitted fore & aft.

Upper Deck Beams 10" x 54" Built 2 Angs 3 1/2" x 3 1/2" x 40" Knees 25" x 54"  
End Beams 2 1/2" 9" x 44" 2. 3 1/2" x 3 1/2" x 34" "

Deck Beams 6 1/2" x 3" x 40" Built Angs. Knees 17" x 40"

Bridge Deck Beams 8 1/2" x 3" x 46" Built Angs. Knees 20" x 46"  
2 = 7" x 3" x 40

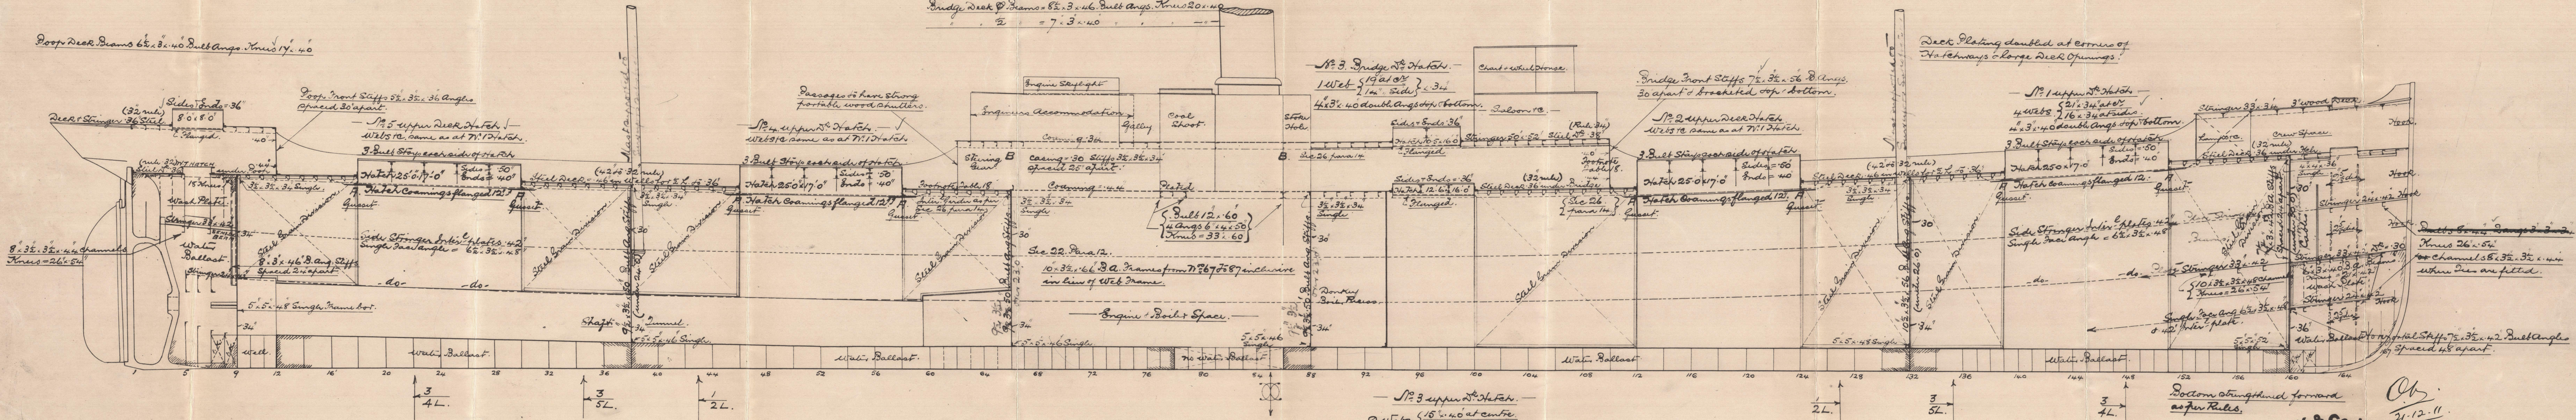

No. 3 upper Deck Hatch.  
2 Webs 15" x 40" at centre.  
3" x 3" x 40" double Angles top & bottom.

Bottom strengthened forward as per Rules.

W. GRAY & Co. LIMITED  
WEST HARTLEPOOL

Ob.  
21.12.11

C.F.  
22.12.11

795.  
806

© 2020  
795.  
806  
Lloyd's Register  
Foundation

W256-0064



Profile  
W. Gray. 26<sup>th</sup>  
so. v. 806



S.S. Penalver



Sept. Rpt. 14442.



W256-0064



© 2020

Lloyd's Register  
Foundation