

SHIP No 218.

PROFILE & DECKS. See separate plan for "Arrangement of Brackets Floors"


DIMENSIONS - LENGTH L.W.L. 260'0"; BREADTH M.O. 40'1"; DEPTH M.O. 18'3"

CLASS LLOYDS \* 100.A.I. - FULL SCANTLING.

SHELL AT BREAKS.

ALL BULB ANGLES ARE N.B.S.

MASTS, DERRICK POSTS, WINCHES, HOUSES, STEERING GEAR SUPPORTED TO SURVIVORS SATISFACTION.

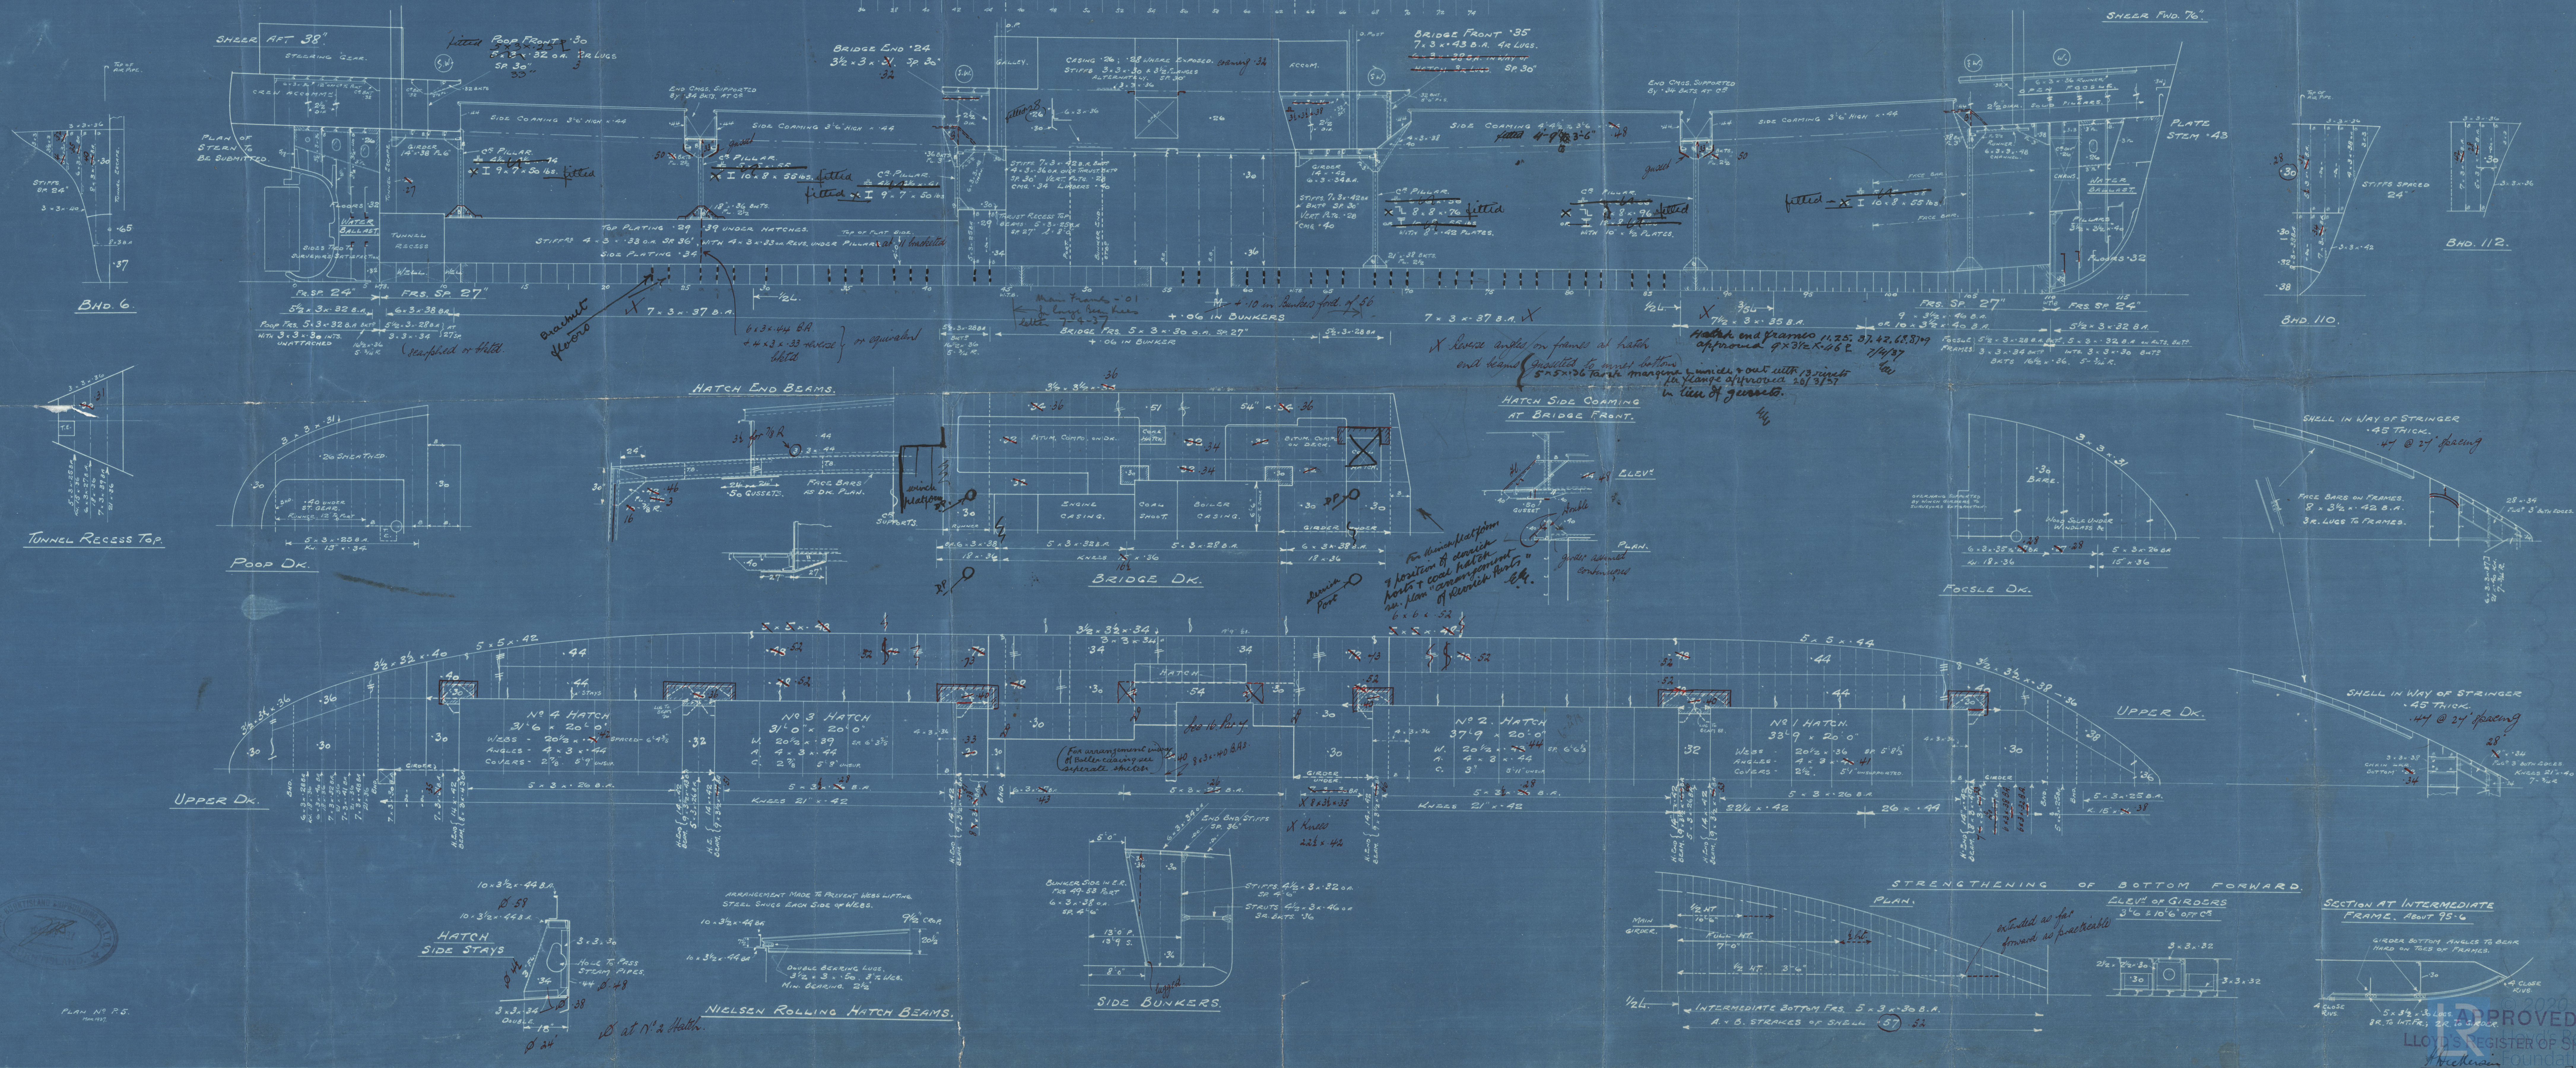



Burntisland S.B. CO. LTD  
N-218

---

Profile & Sections

---

S.S. "Portsea"

Lth. Rpt. No. 19554

W256-0087



© 2020

Lloyd's Register  
Foundation