

W256-0122C(12)

25. 3. 34.

Burntisland L.S. Co. N° 218

100 A1 Full Leantling Single Peaks P.B. & S.
 260' x 40.08' x 10.25' to Upper, 26.25' to Bridge.
 4745 15166
 14.25 Upper 9.90 Bridge

Brextions +1.25'. All B.A's N.B.S. Yes

	4	4
	23 1/8	27, 24 in Peaks
Peaks	52 x 3 x .32 B.A.	52 x 3 x .32 B.A.
Holds. shaft 2L	7 x 3 x .36 B.A.	7 x 3 x .37 B.A.
- 2L to Panting	72 x 3 x .33 B.A. O.B.S.	72 x 3 x .35 B.A.
Panting	9 x 32 x .46 B.A.	9 x 32 x .46 B.A.
Bridge L.S.	5 x 3 x .30 O.A. every frame	5 x 3 x .30 O.A. every frame.

.0288 .0129 B.S. 4745 x .3473 522 x .347 46 B.S.

Increase for 27" spacing B.S. B.S.

.0206 .0103 B.S.	33.33 x .4068 - .36	.5068	532 x .41 - .36	.50
.0258 .0139 B.S.	.30 32 E.S.	.42	.30 for 2L 32 E.S. B.A. clawless.	
	22.49 x .3665	.4665	29 x .38 .39	.47
	.32	.42	.32 stiffened	.42
	43.33 x .38 - .34	.48	34 x .38 .39 E.S.	.49
.0206 .0129 E.S. .0103 B.S.	.3265 - .3068 .38 E.S.	.48	.34 - .32 .39 E.S.	.49

3/4 R {

Holds	5.8	8.8	8.7	Holds	6
G	.4	.6	.8	G	
Frame	6.0	6.1	9.1	Frame	

at 27" spacing


© 2020 Lloyd's Register Foundation

(2/2) 2210-252m

Bridge 1.2nd 6x3=.38 B.A.
 2nd (11.9') 5x3=.26 B.A.
 Upper 1st - Walls 5x3=.28 B.A.
 in Bridge 1R 8x3=.38 B.A.

6x3=.38 B.A.
 3x3=.28 B.A.
 5x3=.28 B.A.
 8x3=.38 B.A.
 7x3=.30 B.A.

42.78 x .5386 = .4936 53 1/4 x .52 = .49
 .4386 = .38 } +.0388 @ 27" f. .43 = .38 +.05 @ 27" f. +.01 @ 24" f.
 .4386 = .38 } +.0088 @ 24" f. .47 = .39

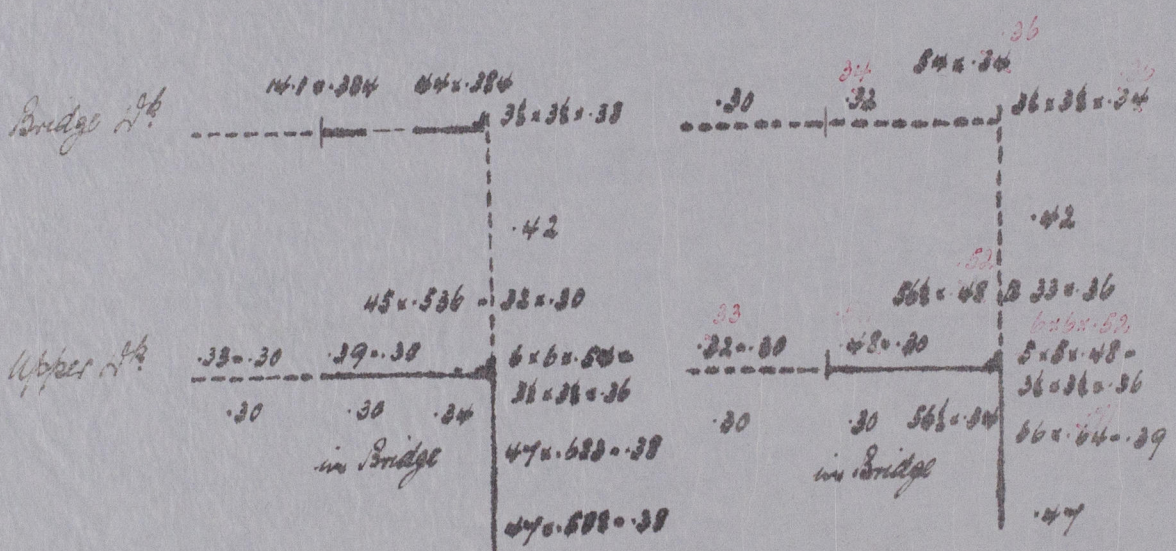

Rule Opening = L.H.