


S/S "ELLIN"

MAIN DECK

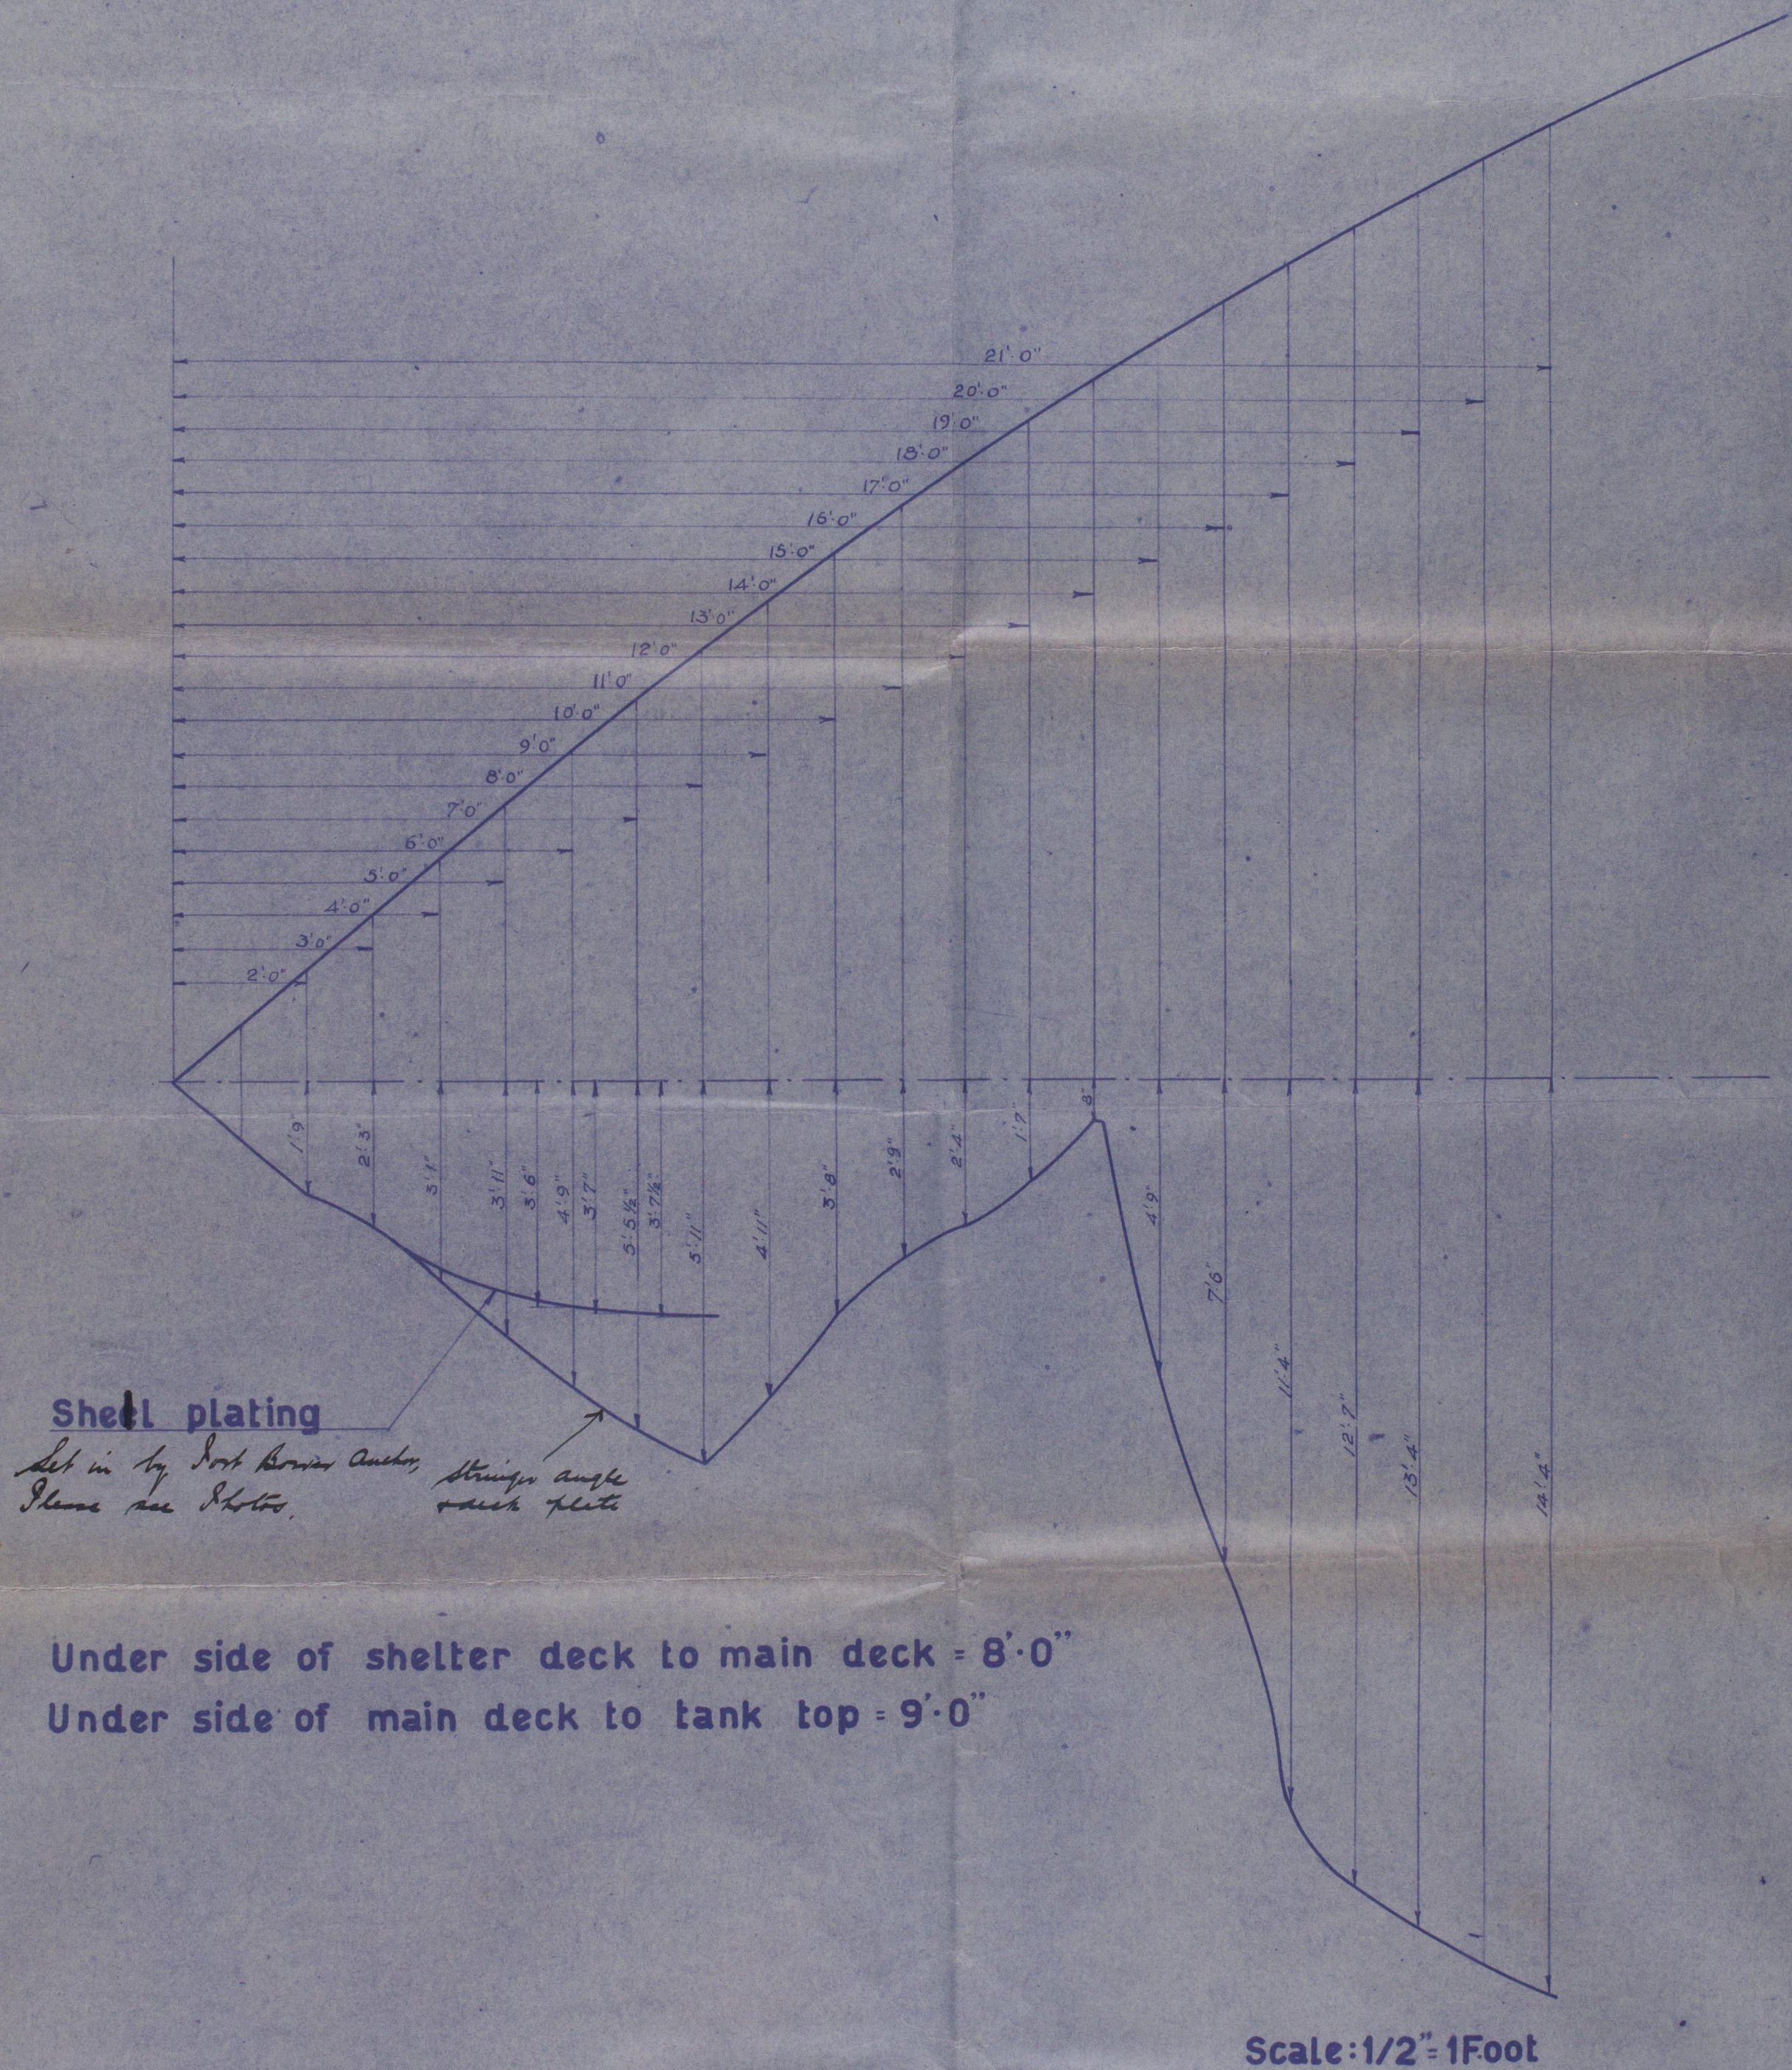

J. S. Ellin dis. rept. No 2528.
Sketch showing damage.

W256-0191



© 2020

Lloyd's Register
Foundation