


# S/S "ELLIN"

## SHELTER DECK

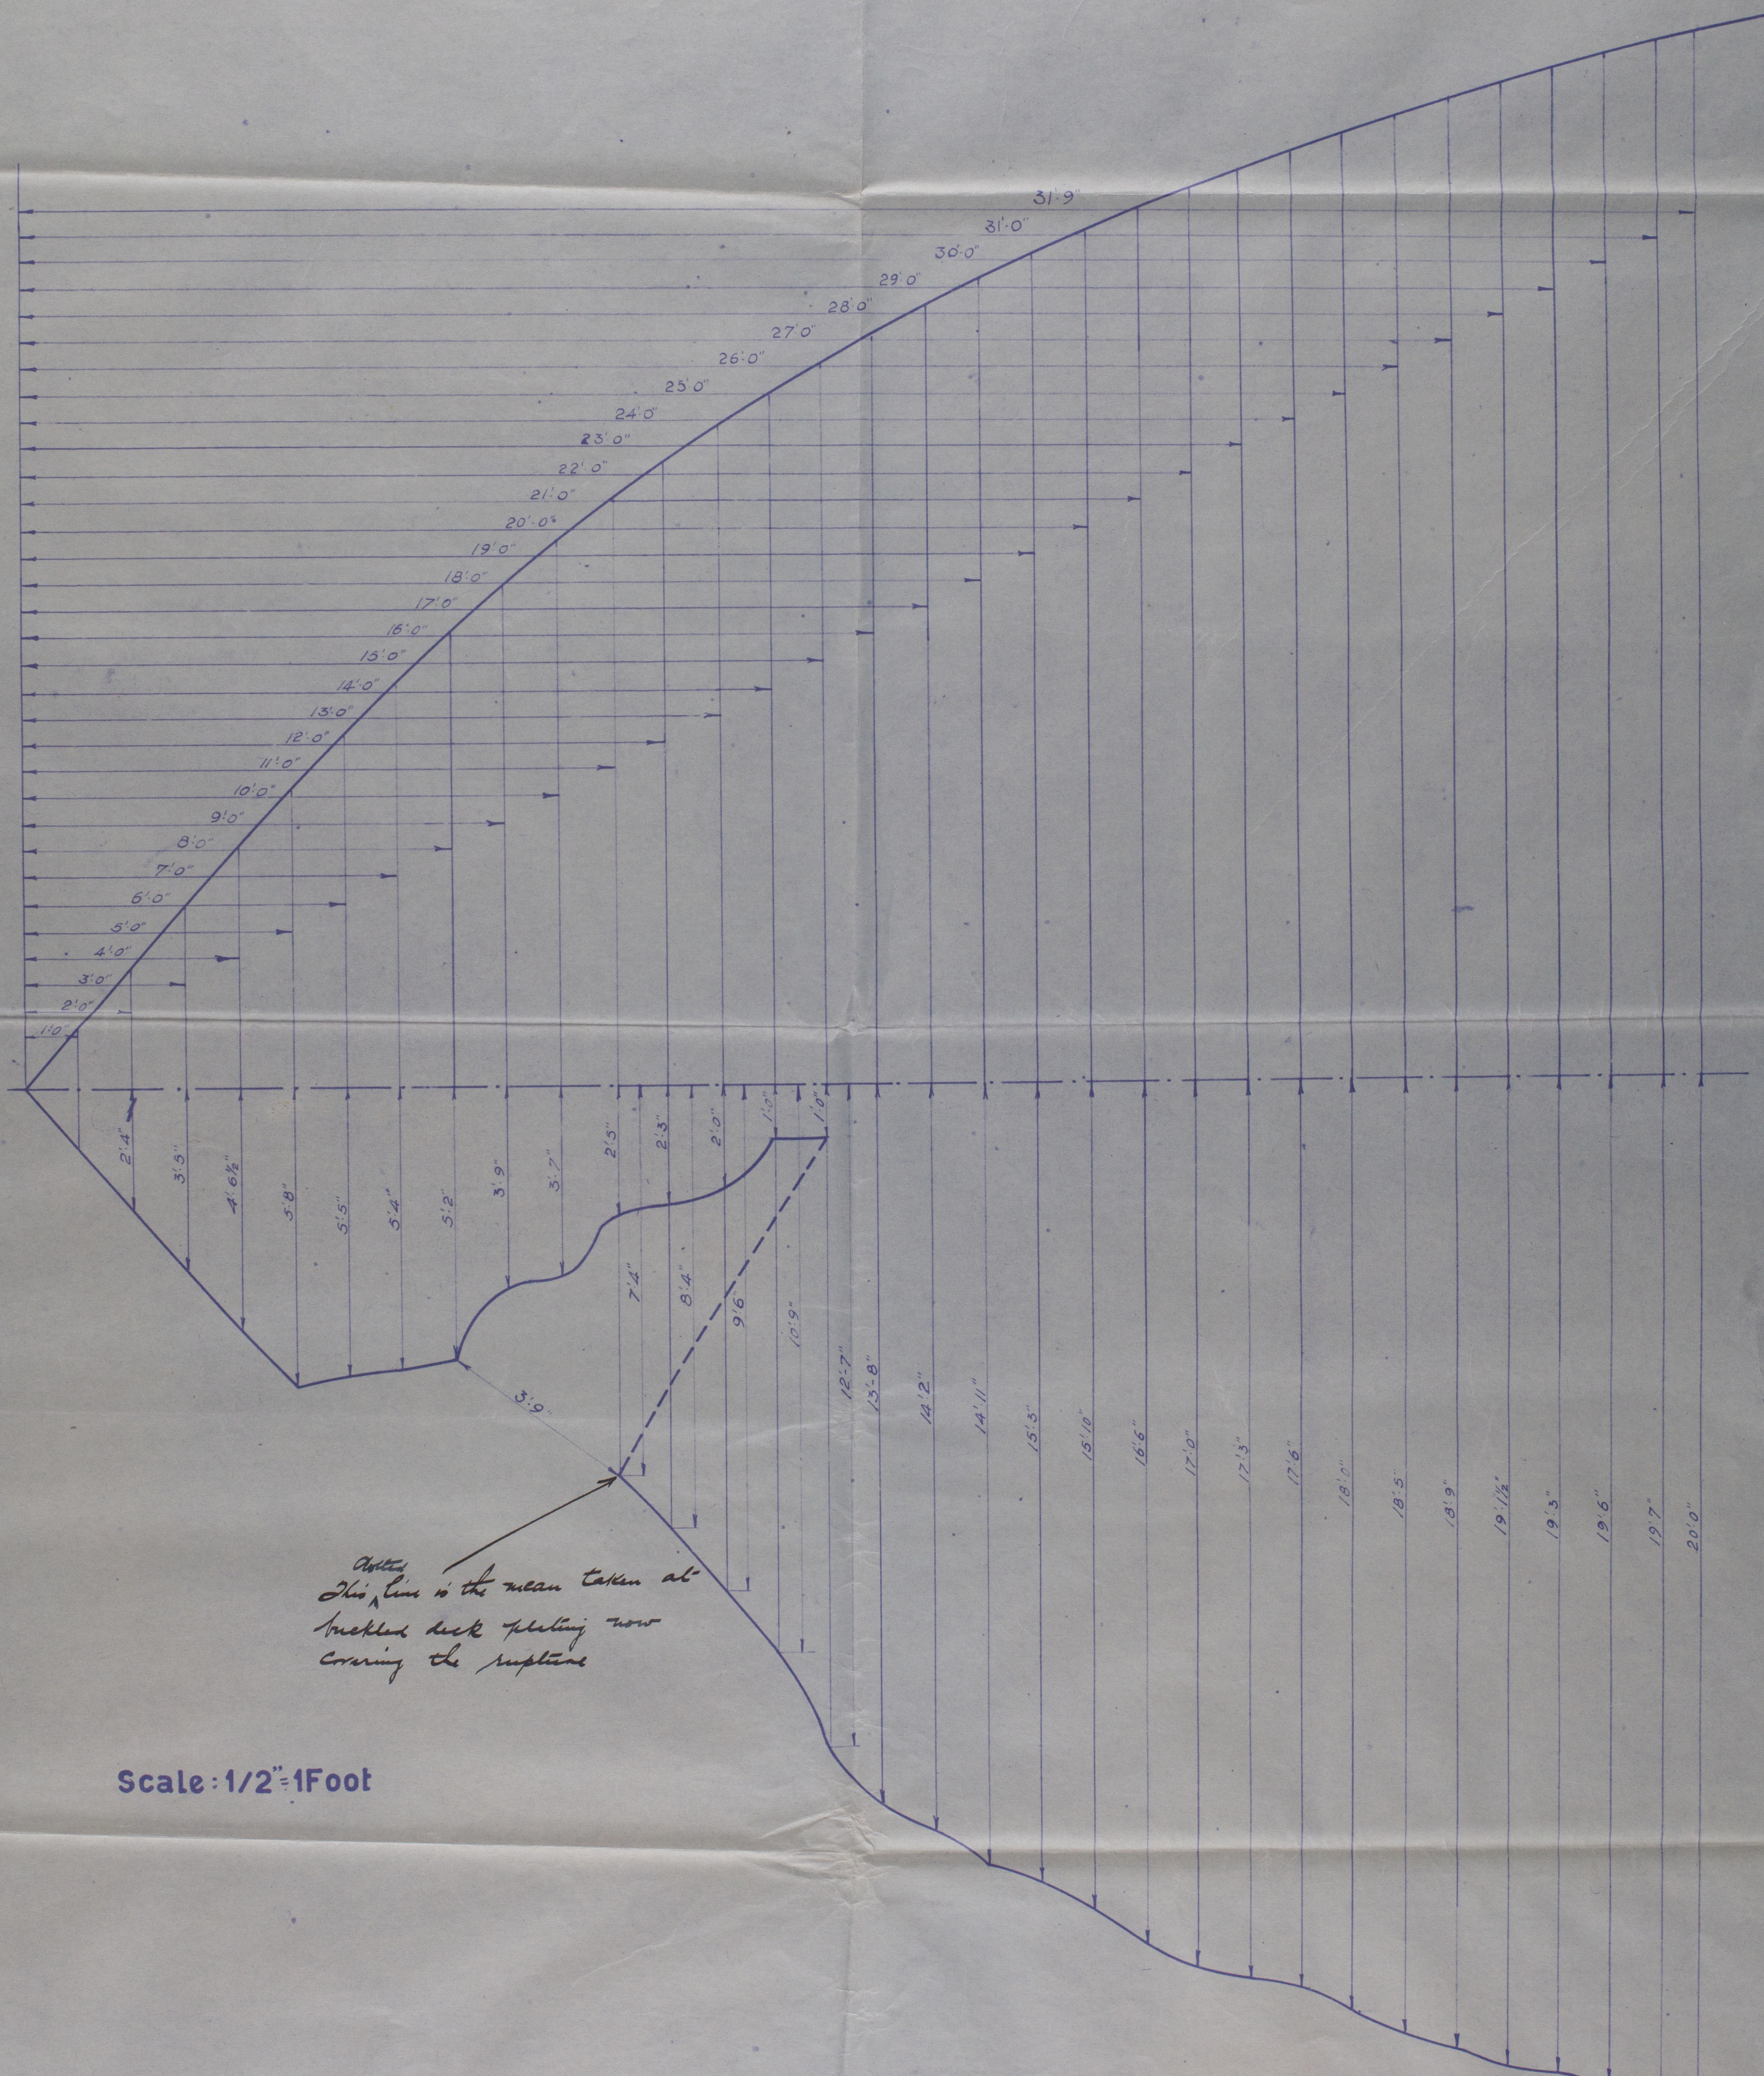

Scale: 1/2"=1Foot



© 2020

Lloyd's Register Foundation

W256-0192



S.P. Allen list rept. No 25-28.

Sketch showing damage.

W256-0192



© 2020

Lloyd's Register  
Foundation