


## CONVERSION OF STERN POST + RUDPER.



SCALE 6"=1

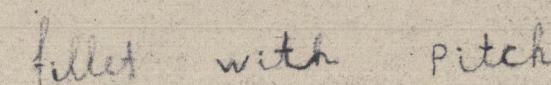

SECTION E-F

SECTION C-D

SCALE 6"=1

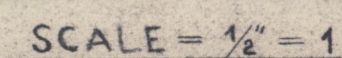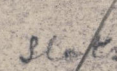

## FIN AND SIDE PLATES

DATE 25-2-1938

No 136

## CHECK

TRACED



S.S. *Odysseus*. Pir. ref. No. 4652.  
Shun frame & rudder alterations.

W256-0200



© 2020

Lloyd's Register  
Foundation