


SCALE $\frac{1}{8}'' = 1'-0''$.

14.3.12
8.7.12
11.10.12

ELIN
1907 No. 20541.


 

J. W. ISHERWOOD
Per G. S.
7/3/12

MESSRS SHORT BROS.
SUNDERLAND. Nº 378.

C.B.
13.3.12.

$$B = \frac{2554 \times 12 \times 40}{100 \times 10} + \frac{50.6}{11 \times 50} = \frac{39.74}{12 \times 54}$$

LLOYD'S REGISTER OF SHIPPING
 RECEIVED
 8-MAR-1912
 LONDON

LLOYD'S REGISTER OF SHIPPING
 RECEIVED
 7-OCT-1911
 LONDON

PLAT LONG 25.3.34 B.V.
 SPACED 30 APRIL

8.35.00 B.A.
 32.33.50 ANGLE

O-E SHOOT TRAINS

2 BUCKLE
 21 DEER



© 2020

Lloyd's Register
 Foundation


MESS^{rs} SHORT Bros
PROFILE & DECK PLANS

No. 378

"ELLIN"



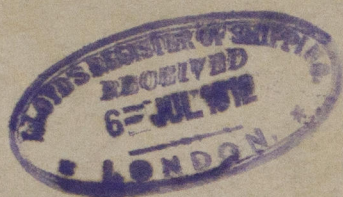

W256-0210