
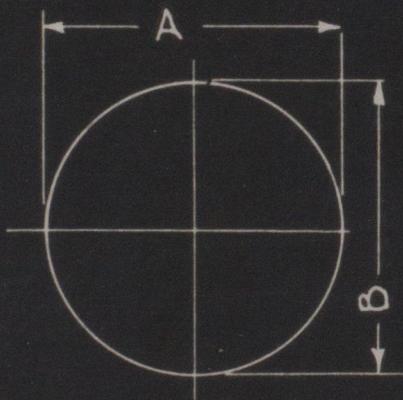



GO 77723

SCOTCH MARINE BOILER
FURNACE DIAMETERS


BOILER NO. 7

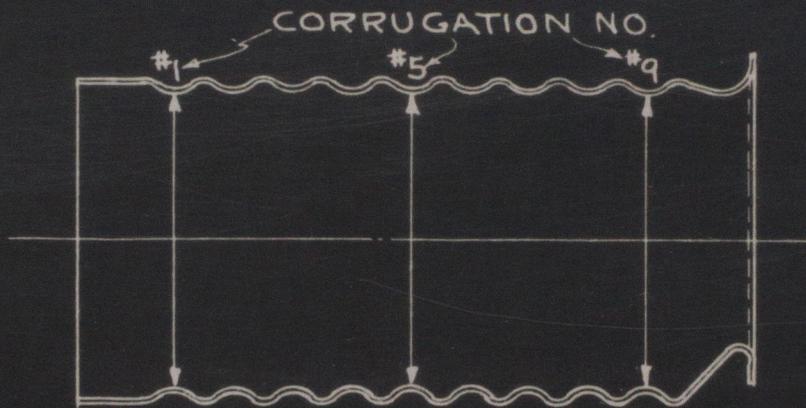

LEFT
FURNACE

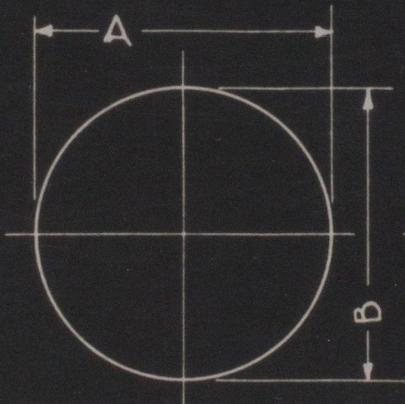

CENTER
FURNACE

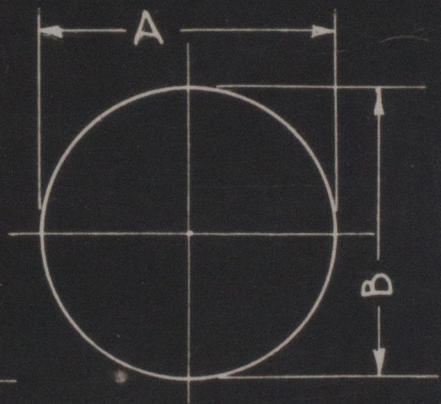

RIGHT
FURNACE

| CORR. NO. | A | B |
|-----------|--------------------|--------------------|
| 1 | $39\frac{3}{8}$ " | $39\frac{5}{16}$ " |
| 5 | $39\frac{5}{8}$ " | $39\frac{3}{16}$ " |
| 9 | $40\frac{3}{16}$ " | $40\frac{5}{16}$ " |

| CORR. NO. | A | B |
|-----------|--------------------|--------------------|
| 1 | $39\frac{5}{16}$ " | $39\frac{3}{8}$ " |
| 5 | $39\frac{9}{16}$ " | $39\frac{9}{16}$ " |
| 9 | $39\frac{3}{16}$ " | $39\frac{3}{16}$ " |

| CORR. NO. | A | B |
|-----------|---------------------|---------------------|
| 1 | $39\frac{5}{8}$ " | $39\frac{11}{16}$ " |
| 5 | $39\frac{13}{16}$ " | $39\frac{13}{16}$ " |
| 9 | $39\frac{3}{16}$ " | $39\frac{3}{16}$ " |

AMERICAN LOCOMOTIVE COMPANY
SCHENECTADY, NEW YORK.



© 2020

Lloyd's Register
FOUNDED 1822
5-141