SCHAAL 1:25

L. SMIT & ZOON
KINDERDIJK
HOLLAND

DOORSNEDE OP 18.

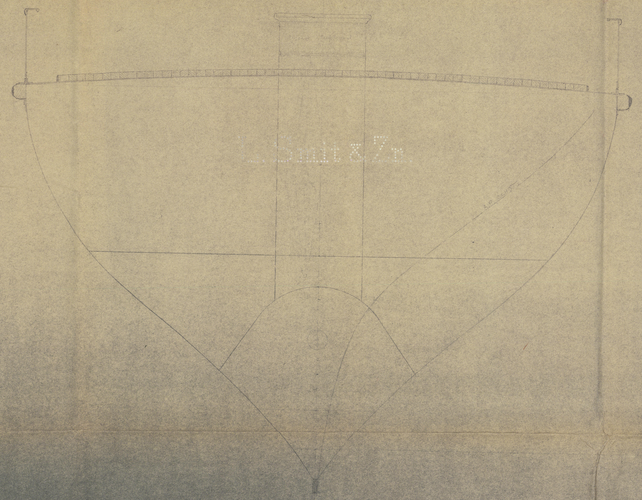

DOORSNEDE OP 27

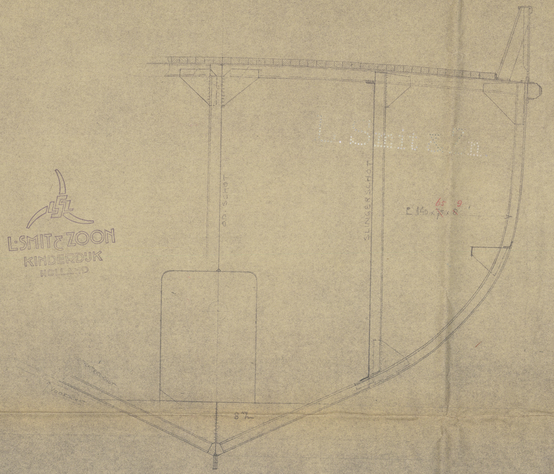

DOORSNEDE OP 39

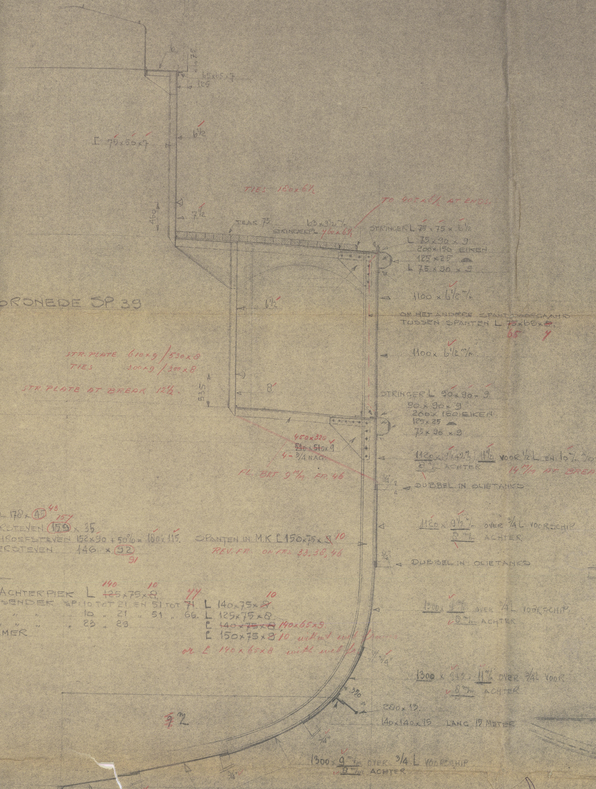

DOORSNEDE OP 56

© 2019
Lloyd's Register
Foundation

762

"Roode Zee"

M.S.

Rot. 27152.

L. Smit & Zoon's Yard

No 889.

Plan provisionally dealt with to enable Builders to specify materials

For guidance in dealing with plans now sent.

(1)

W258-0145

© 2019 Lloyd's Register Foundation