


SECTION THROUGH HOLD.

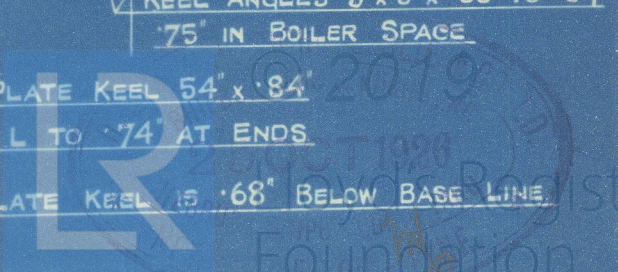

ENCLOSURE TO

LLOYDS

31/02832.

FROM R. & W. HAWTHORN, LESLIE & CO. LTD.,
HEBBURN-ON-TYNE.

W258-0219

2/2

T.S. 'ROHNA' No. 80689.
Hawthorn Leekes

Nº 542

MID-SECTION OF VESSEL AS BUILT.



© 2019

Lloyd's Register
Foundation

W258-0219 1/3