

S. S. N^o 548.

DIMENSIONS

LENGTH BETWEEN PERPENDICULARS	165'0"	d IN WAY OF MAIN DECK	9'34"
BREADTH MOULDED	28'0"	d " " QUARTER DECK	12'84"
DEPTH MOULDED	12'0"	d " " BOILER ROOM	14'25"
1 ST NO	37'0"	40 " " MAIN DECK	18'75"
2 ND NO	61'05"	40 " " QUARTER DECK	10'64"

CLASS 100 A.I.

SCALE $\frac{1}{2}$ INCH = 1 FOOT

EQUIPMENT N^o

2 ND NO		6105.00
QUARTER DECK	(94.86 × 3.5)	332.86
BRIDGE	(10.75 × 7.00 × 3/4)	56.43
FOXLE	(27.00 × 6.50 × 3/4)	131.62
E + B CASING	(20.16 × 6.50 × 2)	163.02
		6788.43

EQUIPMENT


2	BOWLE ANCHORS	12 1/2	WGRS	STOCKLESS
1	STREAM	10 1/2	^	
1	KEDGE	4	^	EX STOCK
105	FATHOMS	1 1/2	^	
.60		2 1/2	STUD CHAIN	GABLE
.75		2 1/2	STEEL WIRE	ROPE
.80		2 1/2		or 8" MANILLA
		6	WARD	

RIVETING

Butte Or No 1 STRAKE OVERLAPPED & TR. FOR $\frac{1}{2}$ L DR AT ENDS ? *preferred*
 2, 3 & 4 DR THROUGHOUT
 5, 6, 7, 8, 9, 10 WAY OF M.D. S.R. FOR $\frac{1}{2}$ L DR AT ENDS ✓
 11, 12, 13,8

SHELL RIVETS THRO' FRAMES INSIDE TANK
✓ FOR? ON MIDSHIP \pm L. SPACED $4\frac{1}{8}$ " APART ✓

ALL SHELL RNETS $\frac{3}{4}$ " DIA. except ⁱⁿ main deck sheen stroke

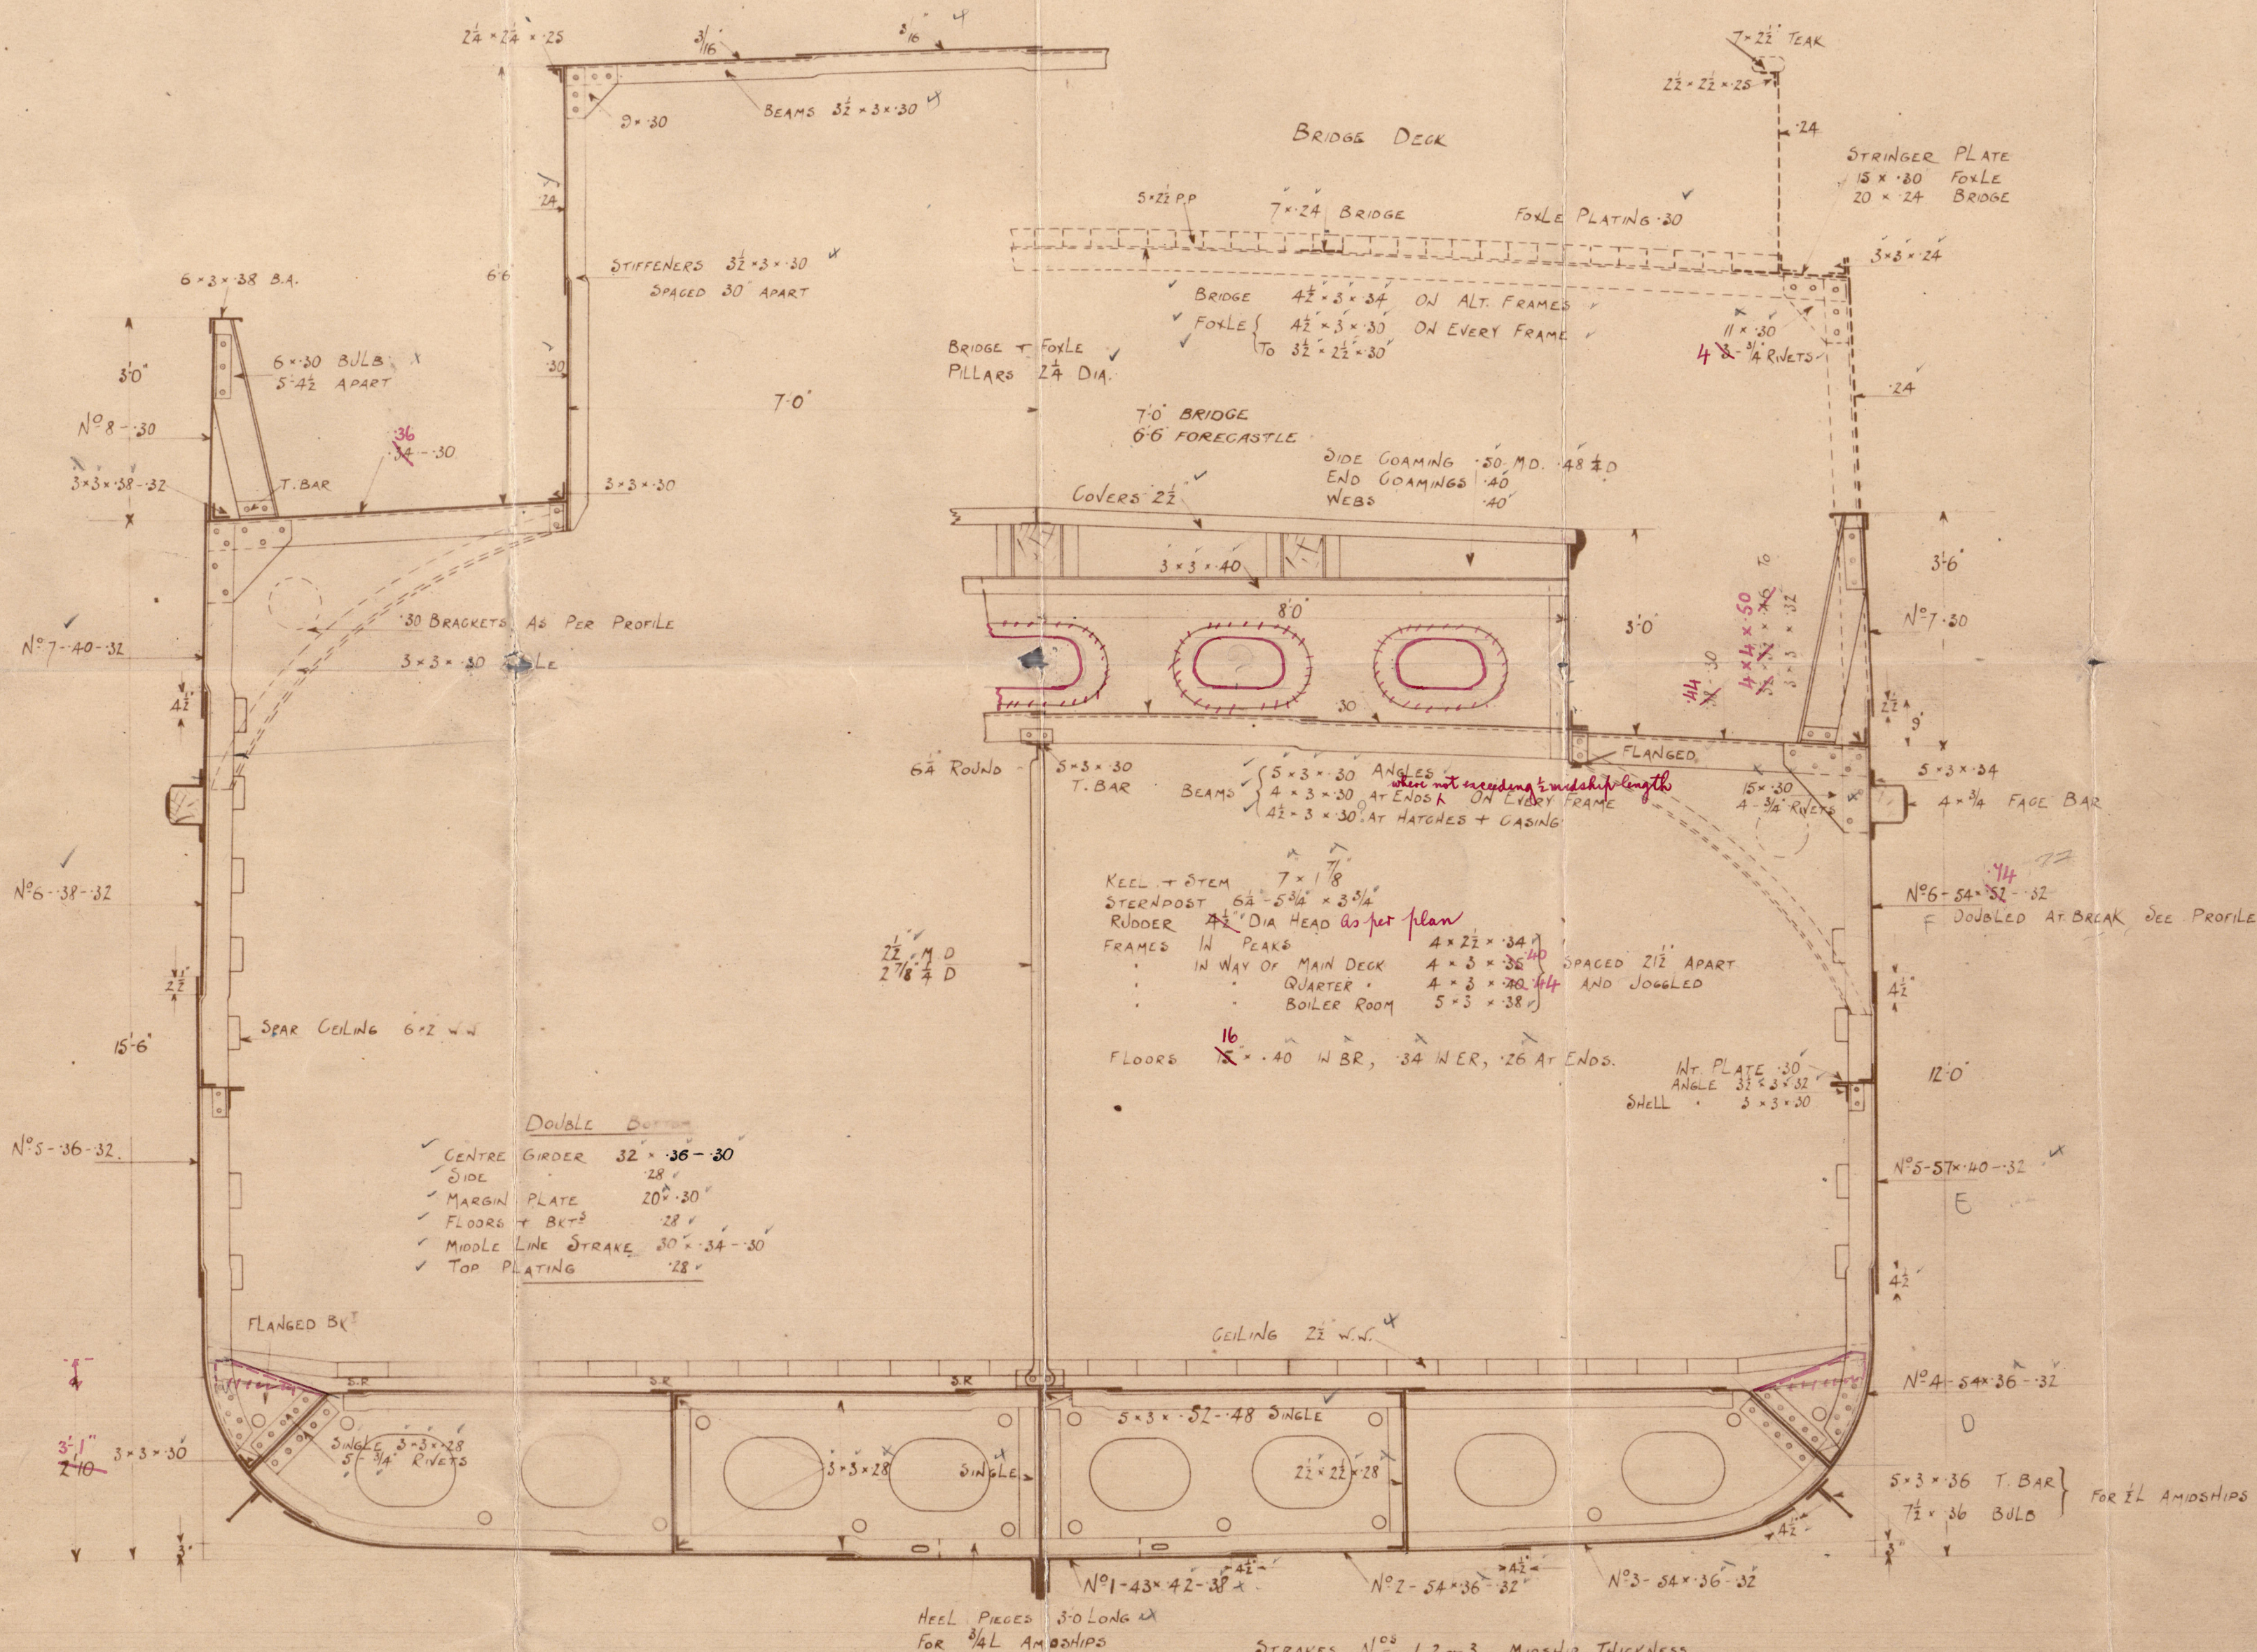

STRAKES Nos 1, 2 + 3 MIDSHIP THICKNESS
MAINTAINED TO RULE POSITION X
OF COLLISION BULKHEAD

SECTION THRU BOILER ROOM

SECTION AT MIDSHIP $\frac{1}{2}L$ SHOWING

ADDITIONAL	INTERCOSTALS	FORWARD
Intercostals to be extended as far forward as practicable		

