

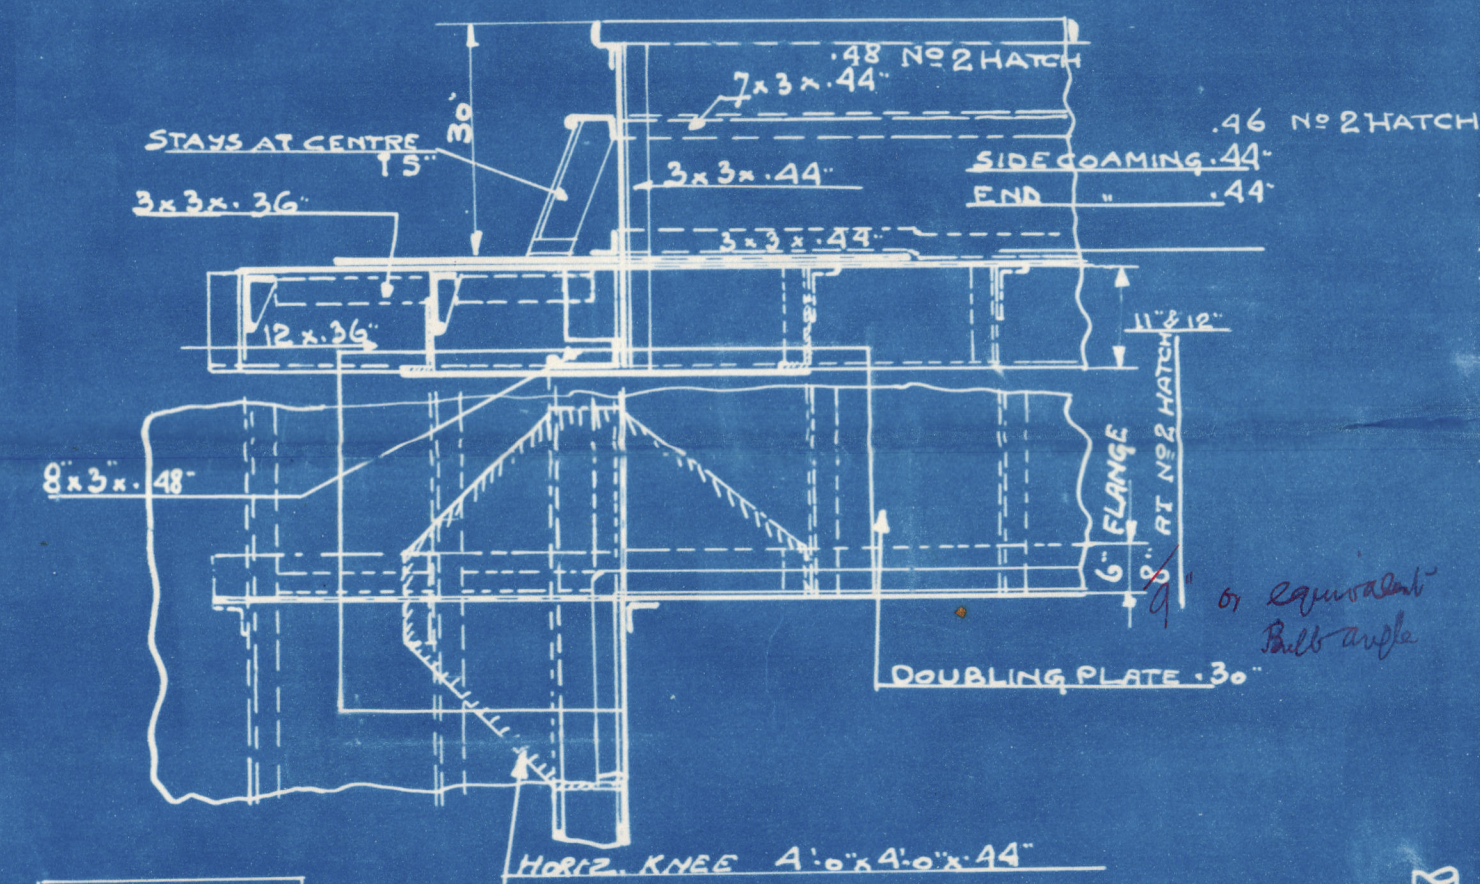


SCALE $\frac{1}{8}"=1'-0"$

TO CLASS AT LLOYDS REGISTER + 100A.1.

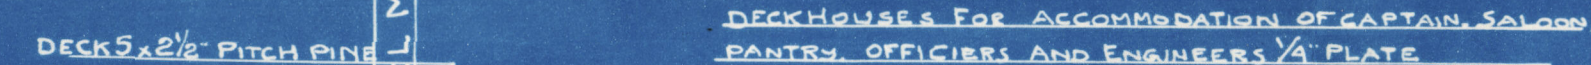

MASTS, WINDLASS, WINCHES, STEERING GEAR ETC
SUPPORTED TO SURVEYORS SATISFACTION;

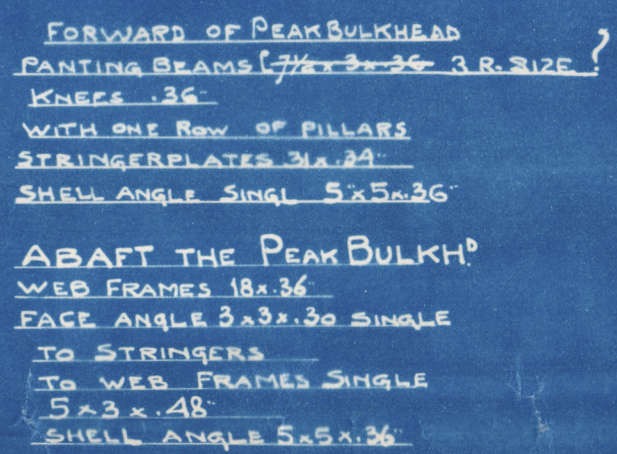


14/5/74

The New Waterway J. B. Co.
Jard no 934
Amended Plan of Profile
& Secks.

~~Gen. Box 229.~~

"Domino"

Rob. 14112

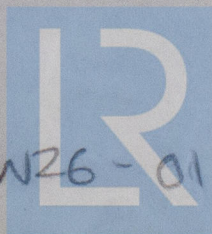

© 2021

W26 - 0134

Lloyd's Register
Foundation