



# PROFILE & DECK PLANS.

SCALE 3" = ONE FOOT.

Notes: 1. Hatch Ends.

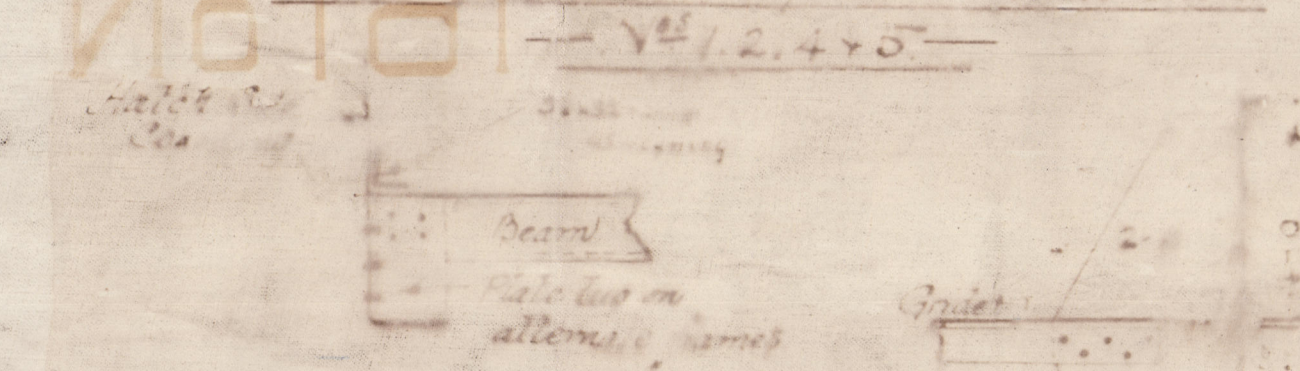




Notes: 2. Hatch Ends.

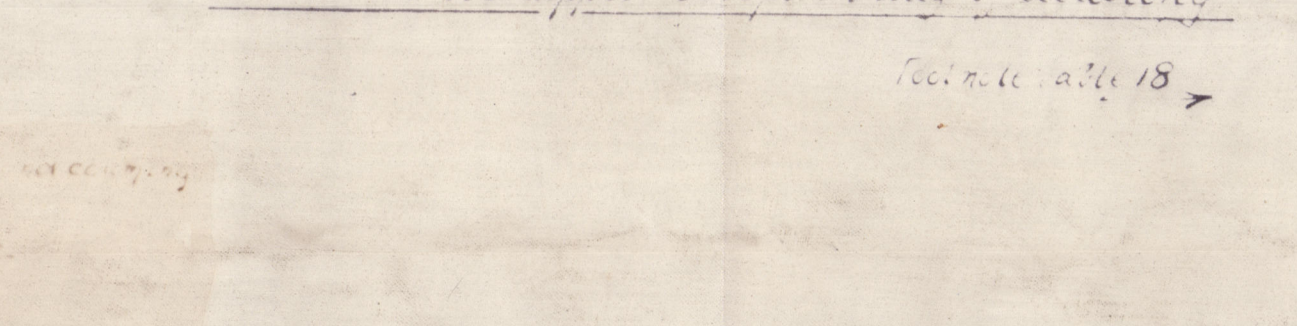

Notes: 3. Main Deck Beams.

Notes: 4. Bridge Deck Beams.

Notes: 5. Collision Bulkhead.

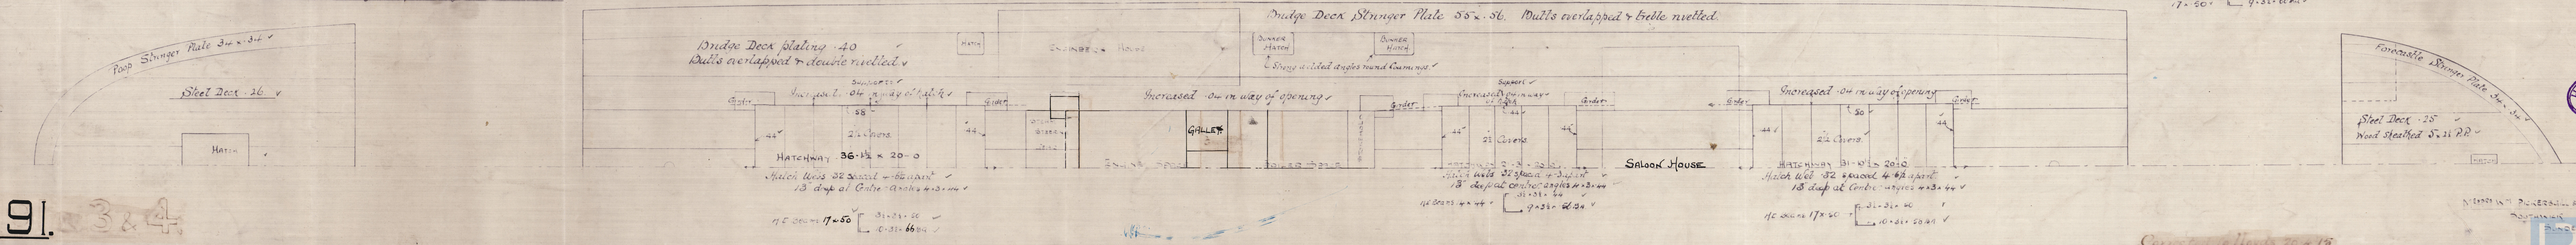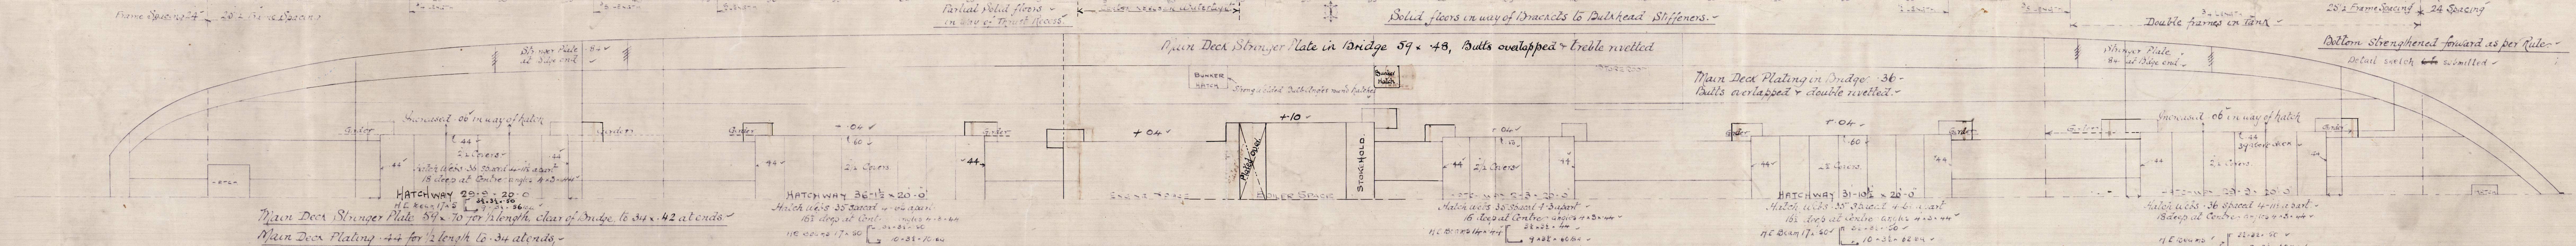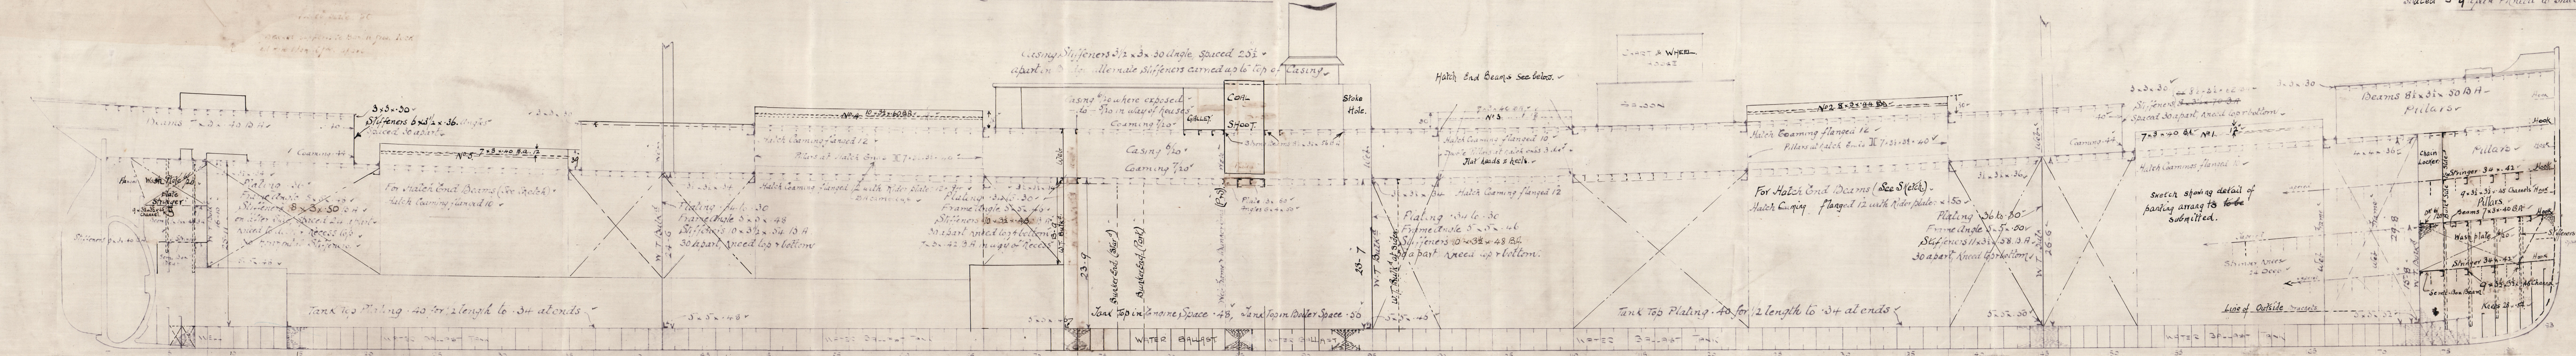

No 191. 3 & 4






"Dirphys"  
ex  
S.S. SWINDON

PICKERSGILLS No 191

PROFILE AND DECK PLANS  
(AS FITTED)

SLD RPT No 26966

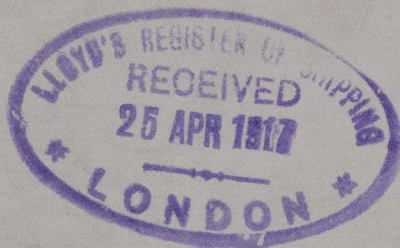

DIRPHYS.

W26 - 0170



© 2021

Lloyd's Register  
Foundation