

N<sup>o</sup> 564

# MIDSHIP SECTION

STEEL SCREW STEAMER.

TO CLASS 100 A. LLOYDS

DIMS: 112'-0" B.P. 21'-6" MLD x 3'-9" MLD

SCALE 1/2 INCH

2413

Messrs Lloyd's Surveyors  
Hull

9/1/13 RK

## NUMERALS

B + O ----- 31.25

L x (B + O) ----- 3500.00

## PROPORTIONS

OUT 11.48' ----- 11.52

d ----- 8.59

Q.D. d ----- 11.59

## EQUIPMENT N<sup>o</sup>.

L x (B + O) ----- 3,500.

Q. DECK. 38.35 x 3 ----- 116

FORECASTLE. 18.75 x 6.5 ----- 91

BRIDGE. 7 x 7.5 ----- 39

CASING &c. 35 x 6.5 ----- 113

3859

## EQUIPMENT

2 ANCHORS 6 1/4 CWTs STOCKLESS

1 ANCHOR 1 3/4 " Ex STOCK


1 " 3/4 " " "

135 FATHOMS. 13/16 STUO CHAIN CABLE

45 " 2" STEEL WIRE

75 " 6" OR 2 1/4 STEEL WIRE

30 " 4" HEMP.

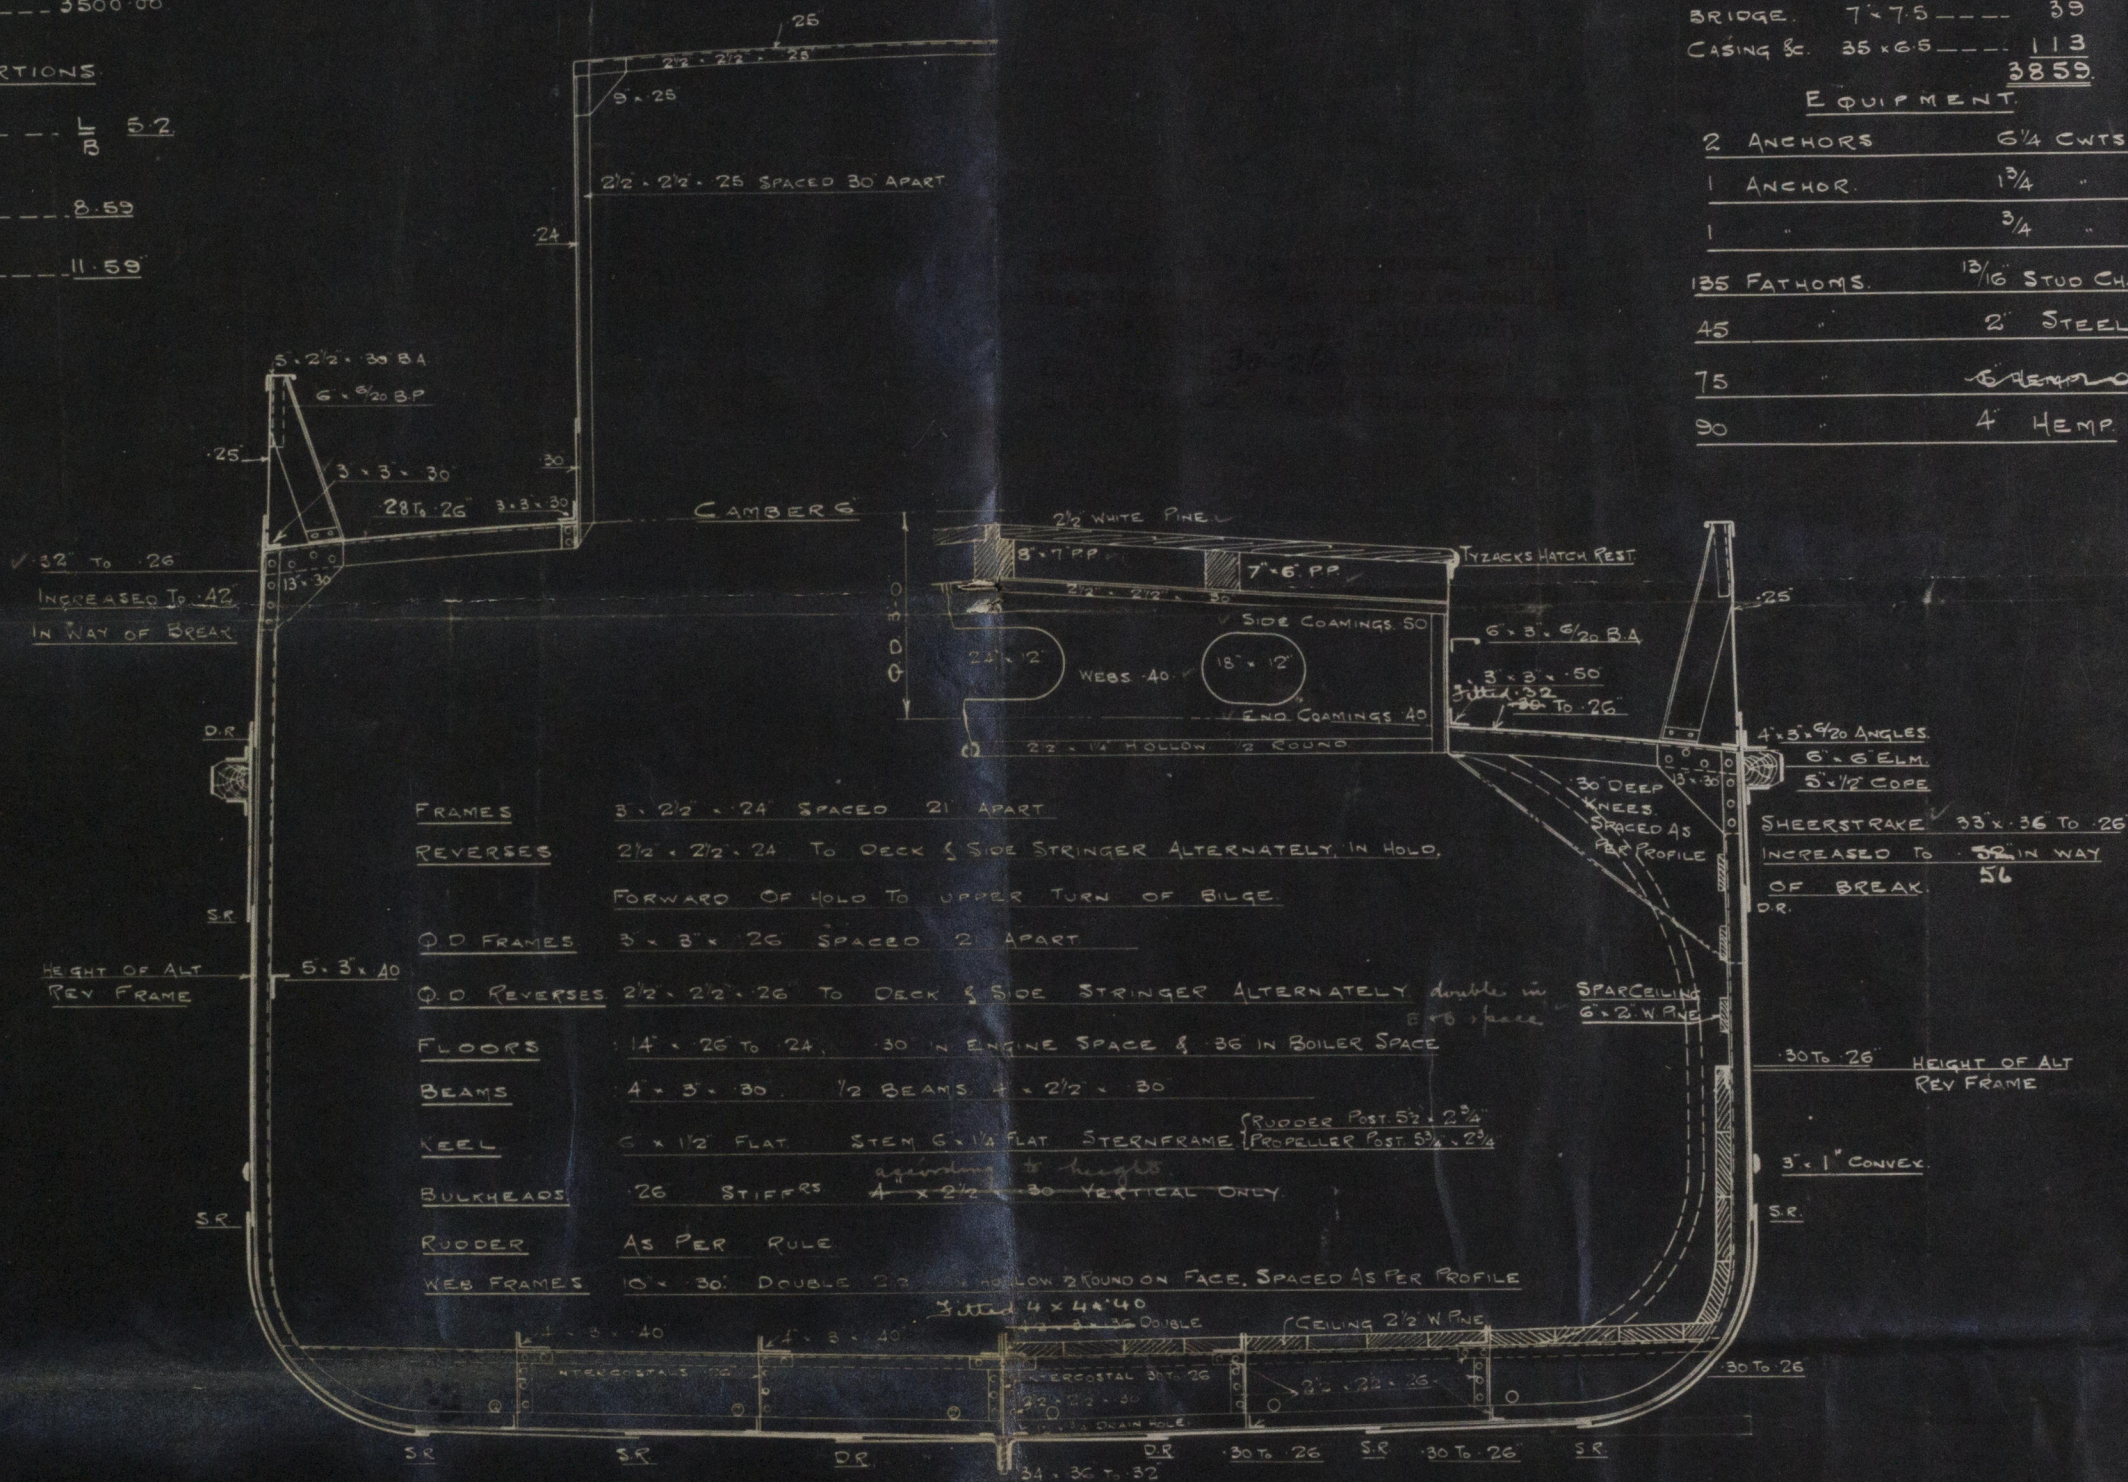

- FRAMES 3 x 2 1/2 x 24 SPACED 21 APART
- REVERSES 2 1/2 x 2 1/2 x 24 TO DECK & SIDE STRINGER ALTERNATELY IN HOLD, FORWARD OF HOLD TO UPPER TURN OF BILGE.
- Q.D. FRAMES 5 x 3 x 26 SPACED 2 APART
- Q.D. REVERSES 2 1/2 x 2 1/2 x 26 TO DECK & SIDE STRINGER ALTERNATELY AVAILABLE IN B + O SPACE
- FLOORS 1 1/4 x 26 TO 24, 30 IN ENGINE SPACE & 36 IN BOILER SPACE
- BEAMS 4 x 3 x 30, 1/2 BEAMS 4 x 2 1/2 x 30
- KEEL 6 x 1 1/2 FLAT STEM 6 x 1 1/2 FLAT STERNFRAME RUDDER POST 5 1/2 x 2 1/4 PROPELLER POST 6 1/2 x 2 1/4
- BULKHEADS 26 STIFFERS 4 x 2 1/2 x 30 VERTICAL ONLY
- RUDDER AS PER RULE
- WEB FRAMES 10 x 30 DOUBLE 22 x 10 HOLLOW 2 ROUND ON FACE, SPACED AS PER PROFILE

## RIVETING

ALL SHELL BUTTS TO BE OVERLAPPED & DOUBLE RIVETED EXCEPT GABBOARD & SHEERSTRAKE WHICH ARE TO BE STRAPPED & DOUBLE RIV<sup>d</sup>  
DECK STRINGER BUTTS OVERLAPPED & DOUBLE RIVETED FORE & AFT  
LANDING EDGES AS SHOWN

Glenora  
13.1.13



© 2020  
Lloyd's Register  
Foundation



1

RAYMOND (Built at  
Delby

H 21

h-h.

Spene 1913)

old ch. Hurl 26532

Mid Ship Section  
(Ware com)

File with F.E.  
plans.



© 2020

Lloyd's Register  
Foundation

WZ60-0118