

13-1-13


112.0 x 2.12 x 0.511
112.0 x 2.12 x 0.511

N^o 564
MIDSHIP SECTION
STEEL SCREW STEAMER.
TO CLASS 100. A.I. LLOYDS.
DIMS: 112'-0" B.P. x 21'-6" MLD x 9'-9" MLD.
SCALE 1/2 INCH.

PLAN No. 2413
FOR ENCLOSURE TO
Messrs Lloyd's Surveyors
Hull FROM
J. & S. LLOYD LTD.
SHIPBUILDERS LTD.
DATE 9/1/13 RK

NUMERALS
B + D ----- 31.25
L x (B + D) ----- 3500.00.
PROPORTIONS
D/B 11.48 ----- 1/5 5.2
d ----- 8.59
Q.D. d ----- 11.59

EQUIPMENT NO.	
L x (B + D)	3,500.
Q. DECK.	38.55 x 3 ----- 116
FORECASTLE.	18.75 x 6.5 ----- 91
BRIDGE.	7 x 7.5 ----- 39
CASING &c.	35 x 6.5 ----- 113
3859.	
EQUIPMENT.	
2 ANCHORS	6 1/4 CWTs STOCKLESS
1 ANCHOR.	1 3/4 " Ex STOCK
1 " "	3/4 " " "
135 FATHOMS.	1 3/8" STUO CHAIN CABLE
45 " "	2" STEEL WIRE
75 " "	6 HEMP OR 2 1/4" STEEL WIRE
90 " "	4" HEMP.

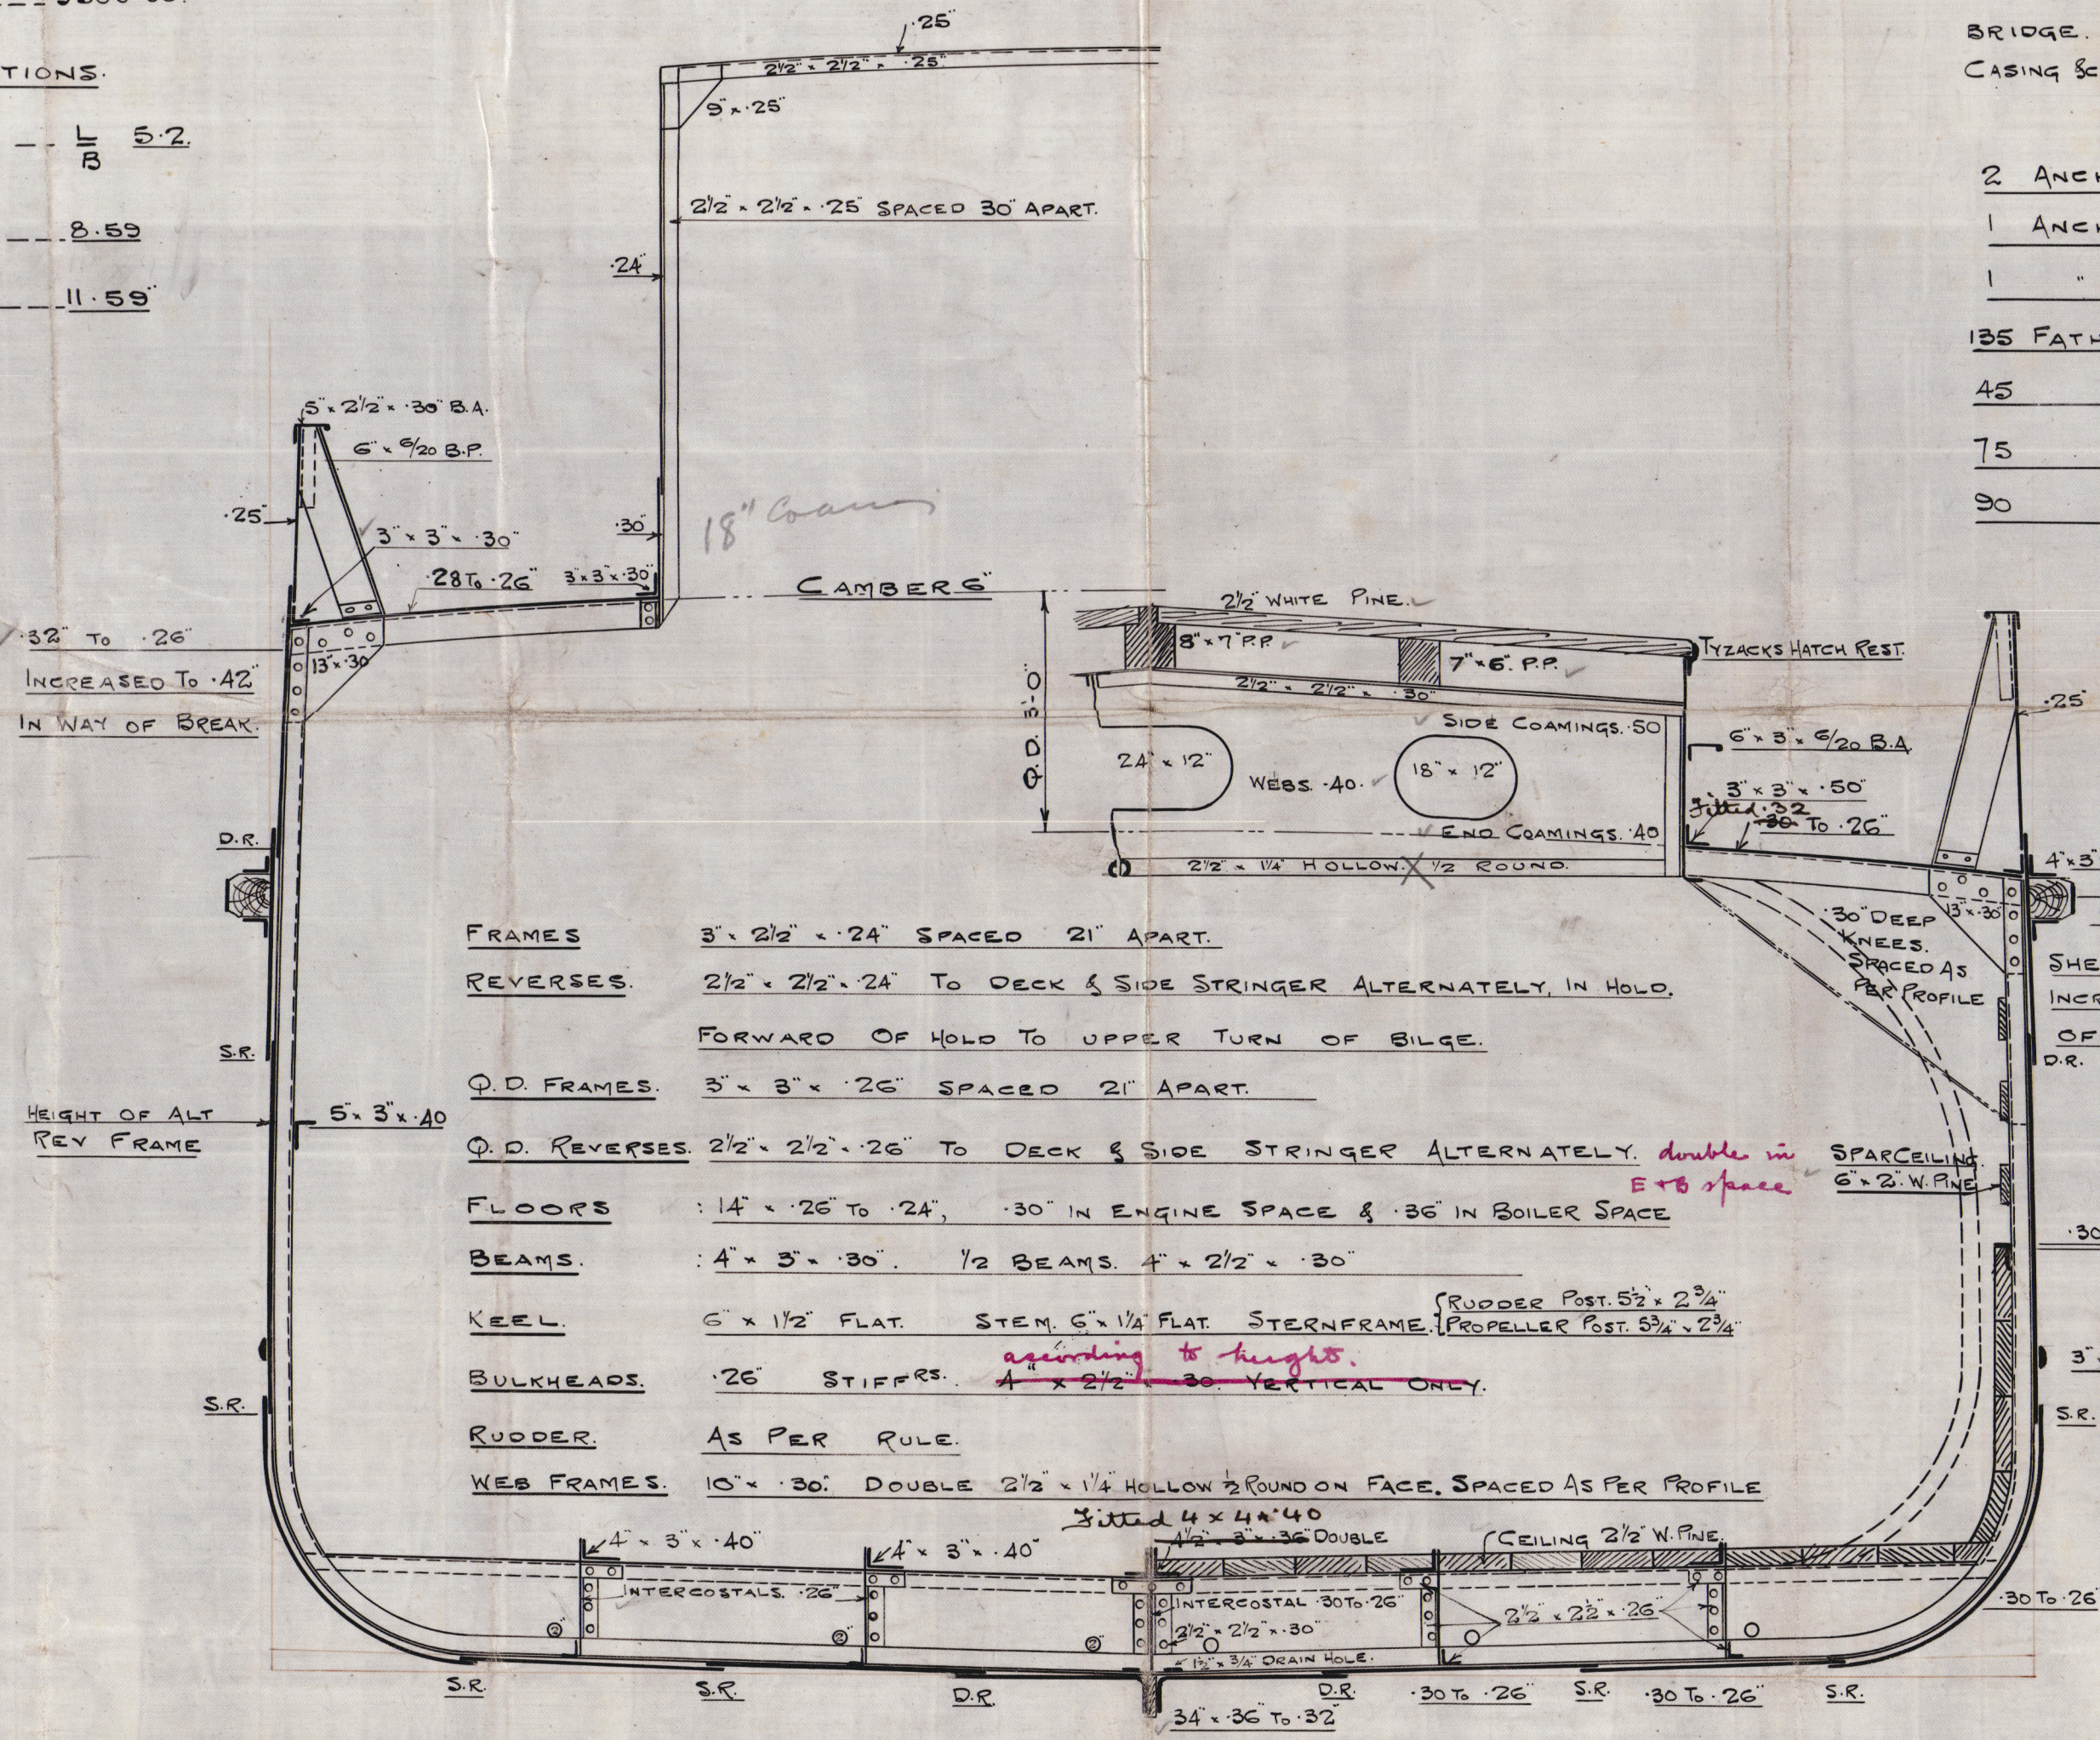

- FRAMES 3' x 2 1/2" x 24" SPACED 21" APART.
- REVERSES 2 1/2" x 2 1/2" x 24" TO DECK & SIDE STRINGER ALTERNATELY, IN HOLD, FORWARD OF HOLD TO UPPER TURN OF BILGE.
- Q.D. FRAMES 3' x 3" x 26" SPACED 21" APART.
- Q.D. REVERSES 2 1/2" x 2 1/2" x 26" TO DECK & SIDE STRINGER ALTERNATELY.
- FLOORS 1 1/4" x 26" TO 24", 30" IN ENGINE SPACE & 36" IN BOILER SPACE.
- BEAMS 4' x 5" x 30", 1/2 BEAMS 4' x 2 1/2" x 30".
- KEEL 6' x 1 1/2" FLAT. STEM 6' x 1 1/4" FLAT. STERNFRAME (RUDDER POST 5 1/2" x 2 3/4" PROPELLER POST 5 1/4" x 2 1/4").
- BULKHEADS 26" STIFFERS 4' x 2 1/2" x 30" VERTICAL ONLY.
- RUDDER AS PER RULE.
- WEB FRAMES 10' x 30" DOUBLE 2 1/2" x 1 1/4" HOLLOW 1/2 ROUND ON FACE, SPACED AS PER PROFILE.

RIVETING.
ALL SHELL BUTTS TO BE OVERLAPPED & DOUBLE RIVETED EXCEPT GARBOARD & SHEERSTRAKE WHICH ARE TO BE STRAPPED & DOUBLE RIV^d.
DECK STRINGER BUTTS OVERLAPPED & DOUBLE RIVETED FORE & AFT.
LANDING EDGES AS SHOWN.

Glenmona
13-1-13

$$112.0 + 21.5 \times 9.75.$$

26 JUL 1913

WZ60-0119