

DIMENS. 400' x 55' x 32'


Requirements of Section 20 of the dsh Rules to be complied with where applicable.

Flash Point of the oil fuel not to be less than 150° F.

Masts, windlass, winches, steering gear and donkey boiler

to be supported to Surveyor's satisfaction



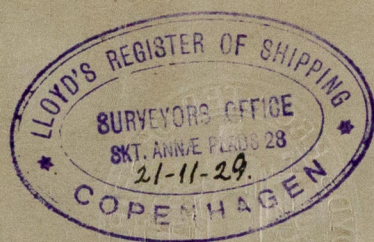

PROFILE AND DECK PLAN

Twin Screw Motor Tank Vessel

Yard No 44

Nakskov Skibsværft,  
Nakskov.

M/s. "Henrik Ameln", of Oslo.  
Cym. Rpt. No 8494.

N.N. "South America"

W261-0032



© 2019

Lloyd's Register  
Foundation