

















SHIP NO 44

MIDSHIP SECTION & DETAILS

DIMENSIONS 400' - 55' - 32'

TO CLISS LLOYD'S * 100 #1 CARRYING PETROLEUM IN BULK.

SCALE $\frac{1}{2}$ " = $\frac{1}{4}$ " = 1'-0"

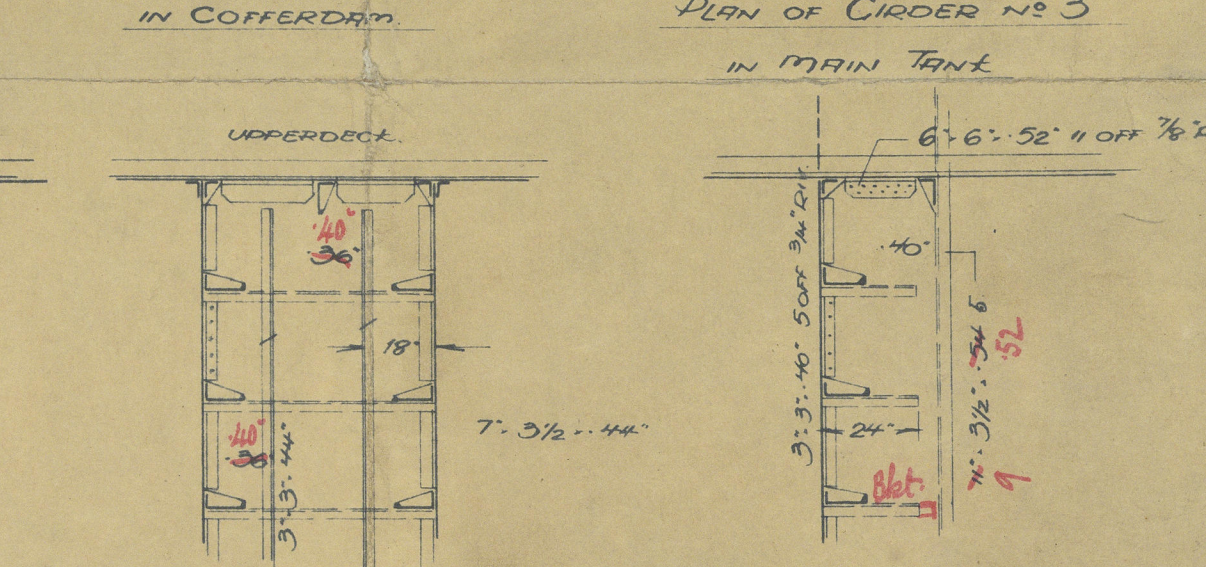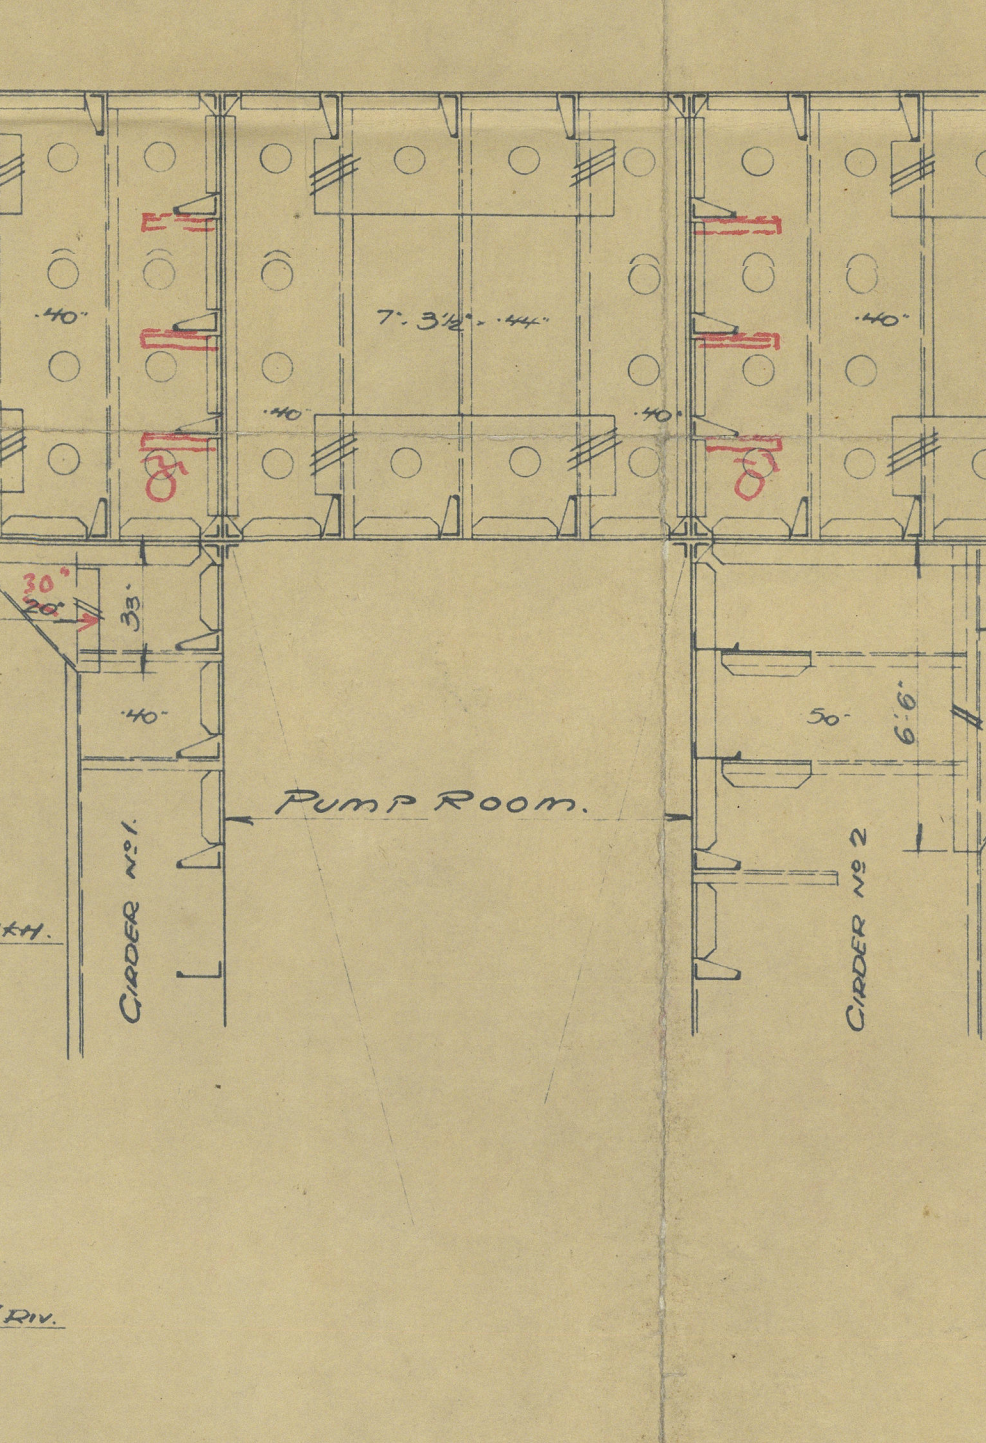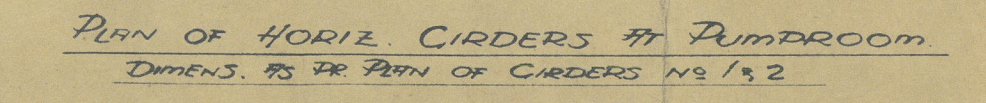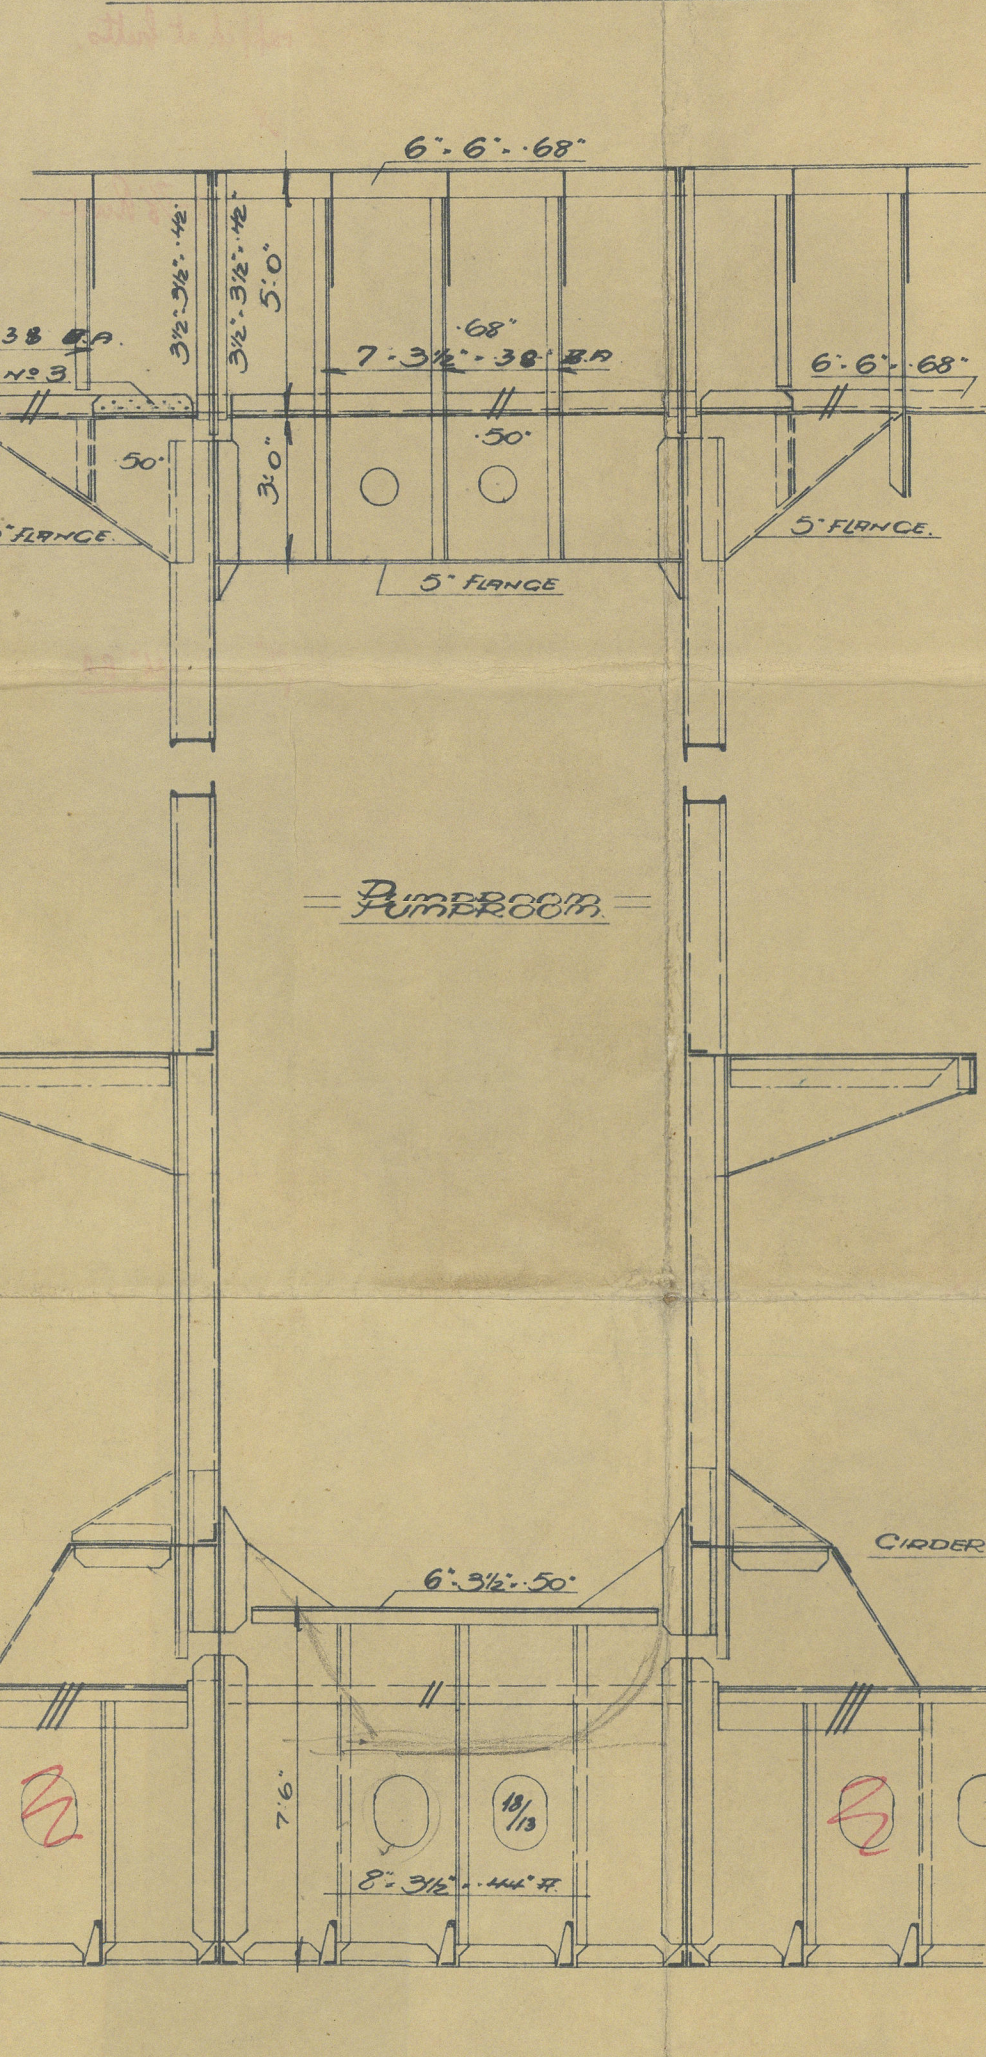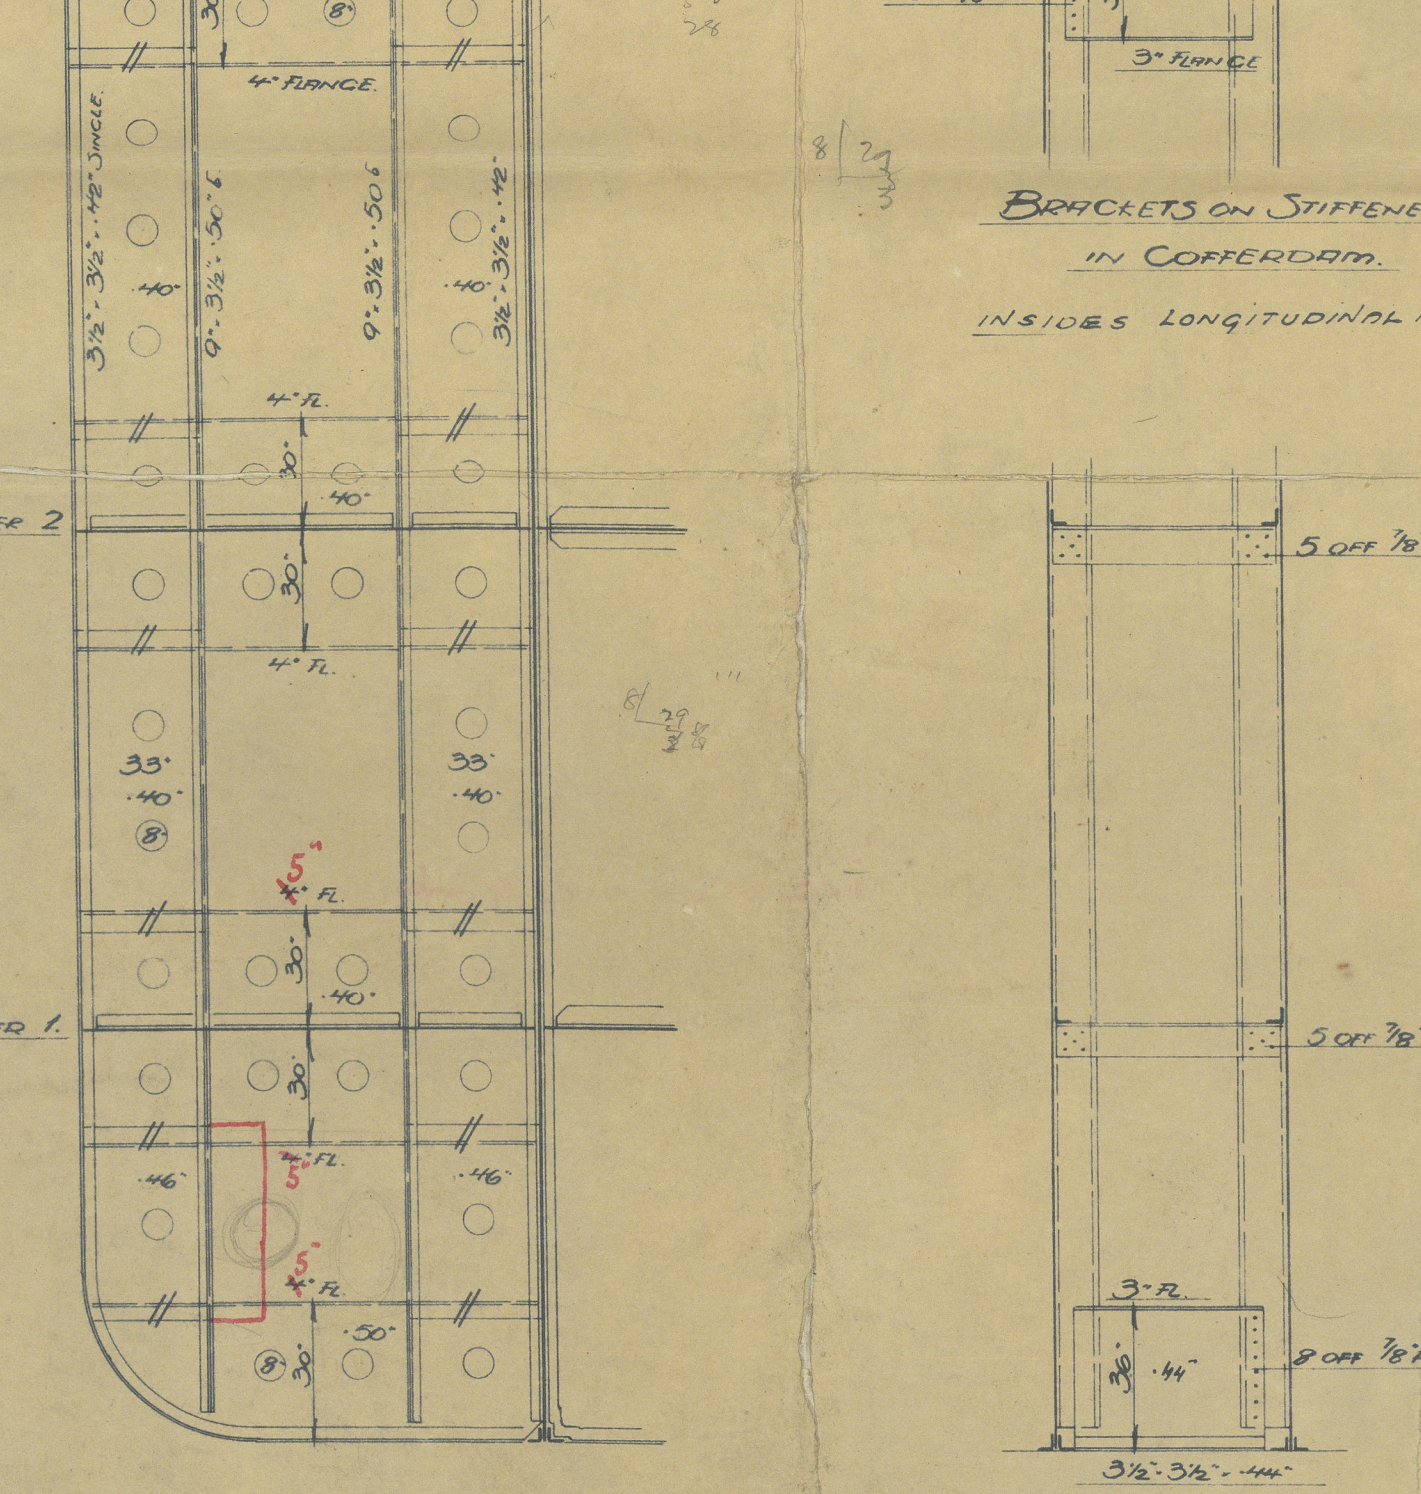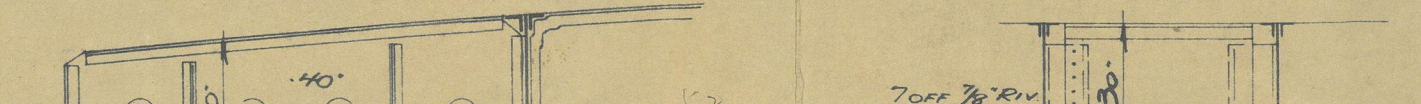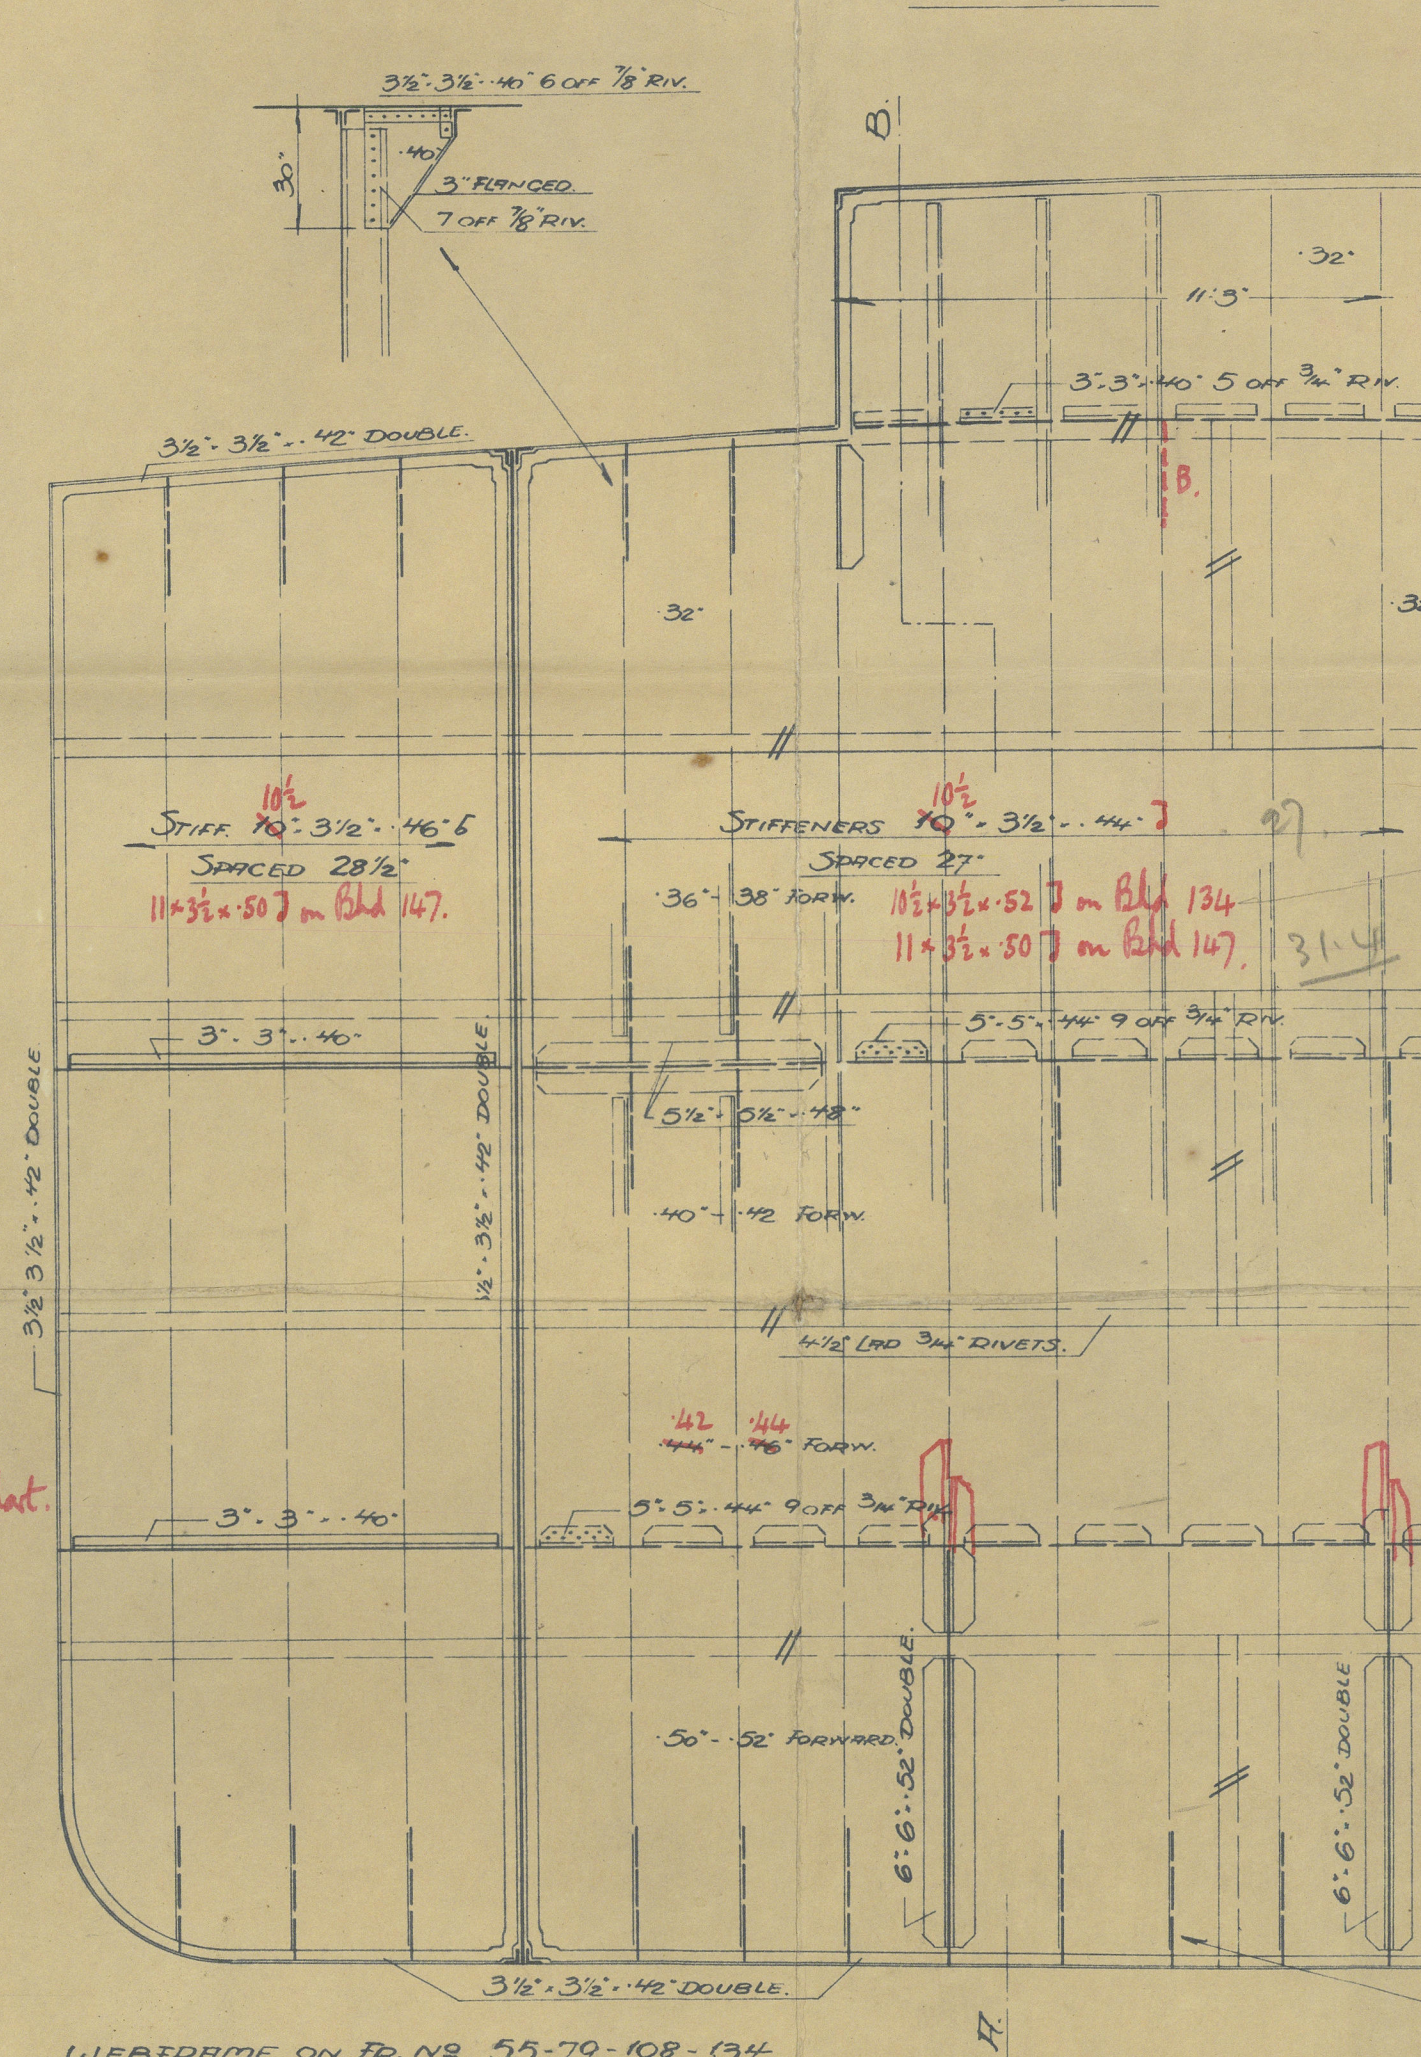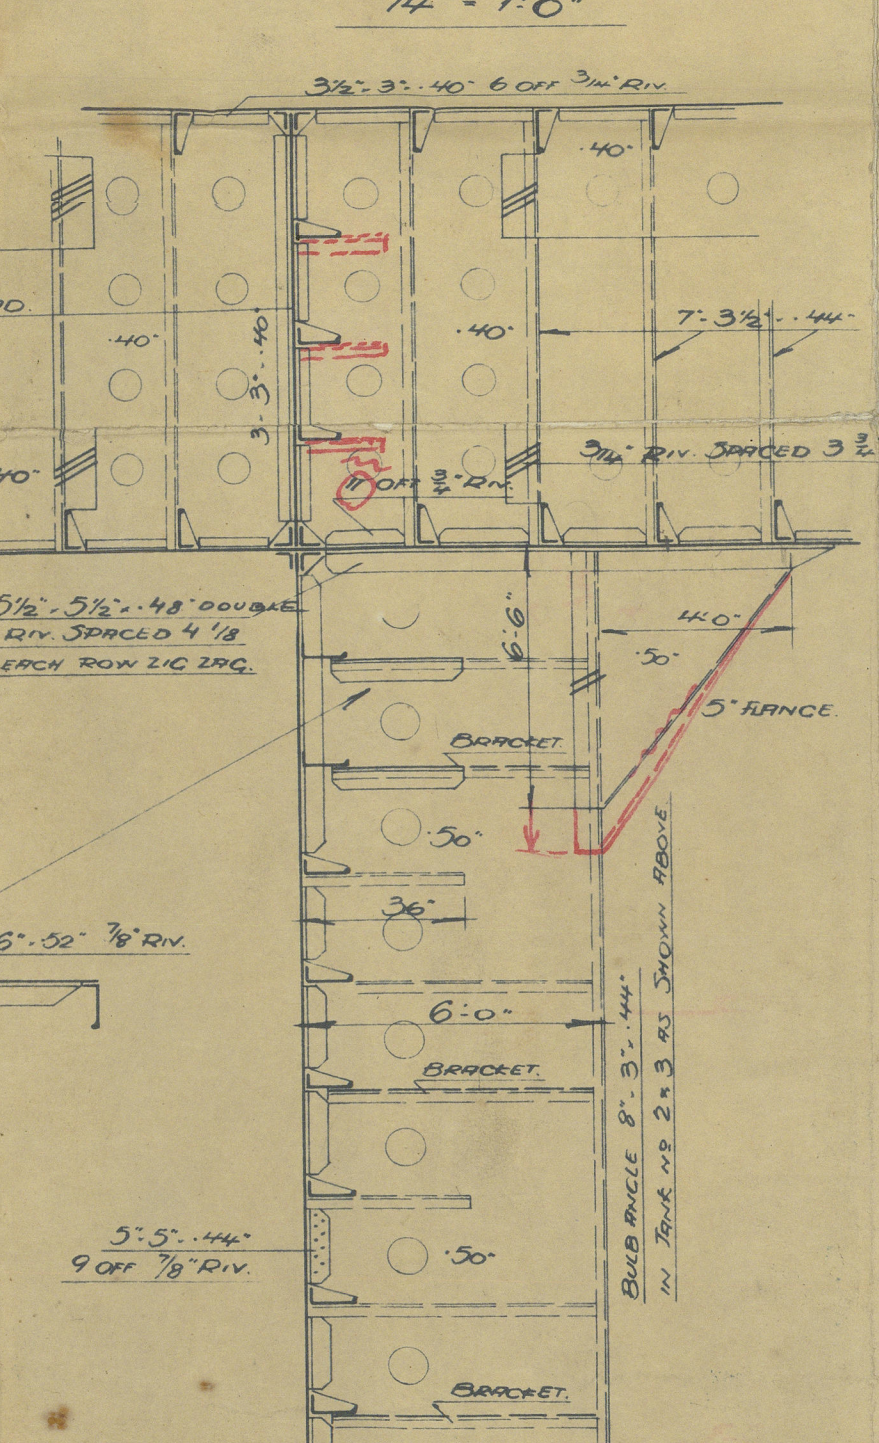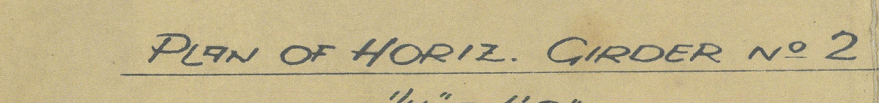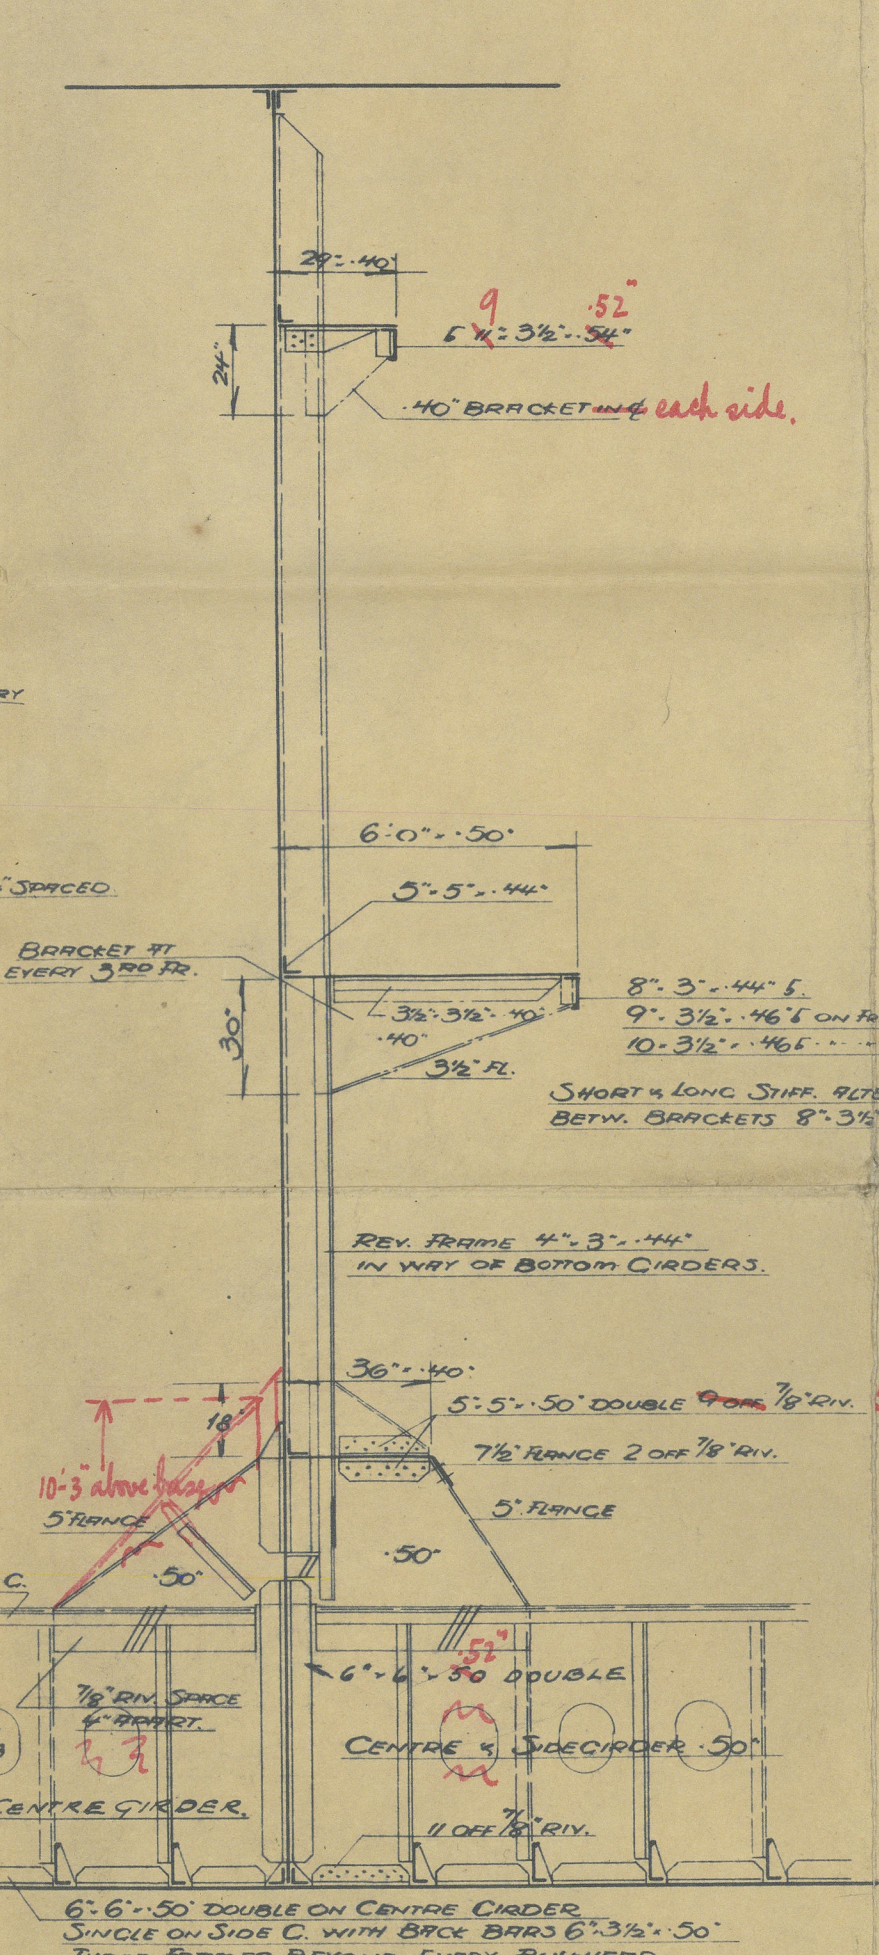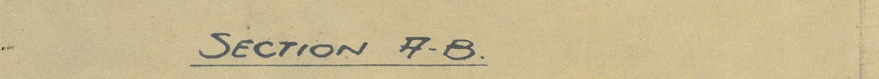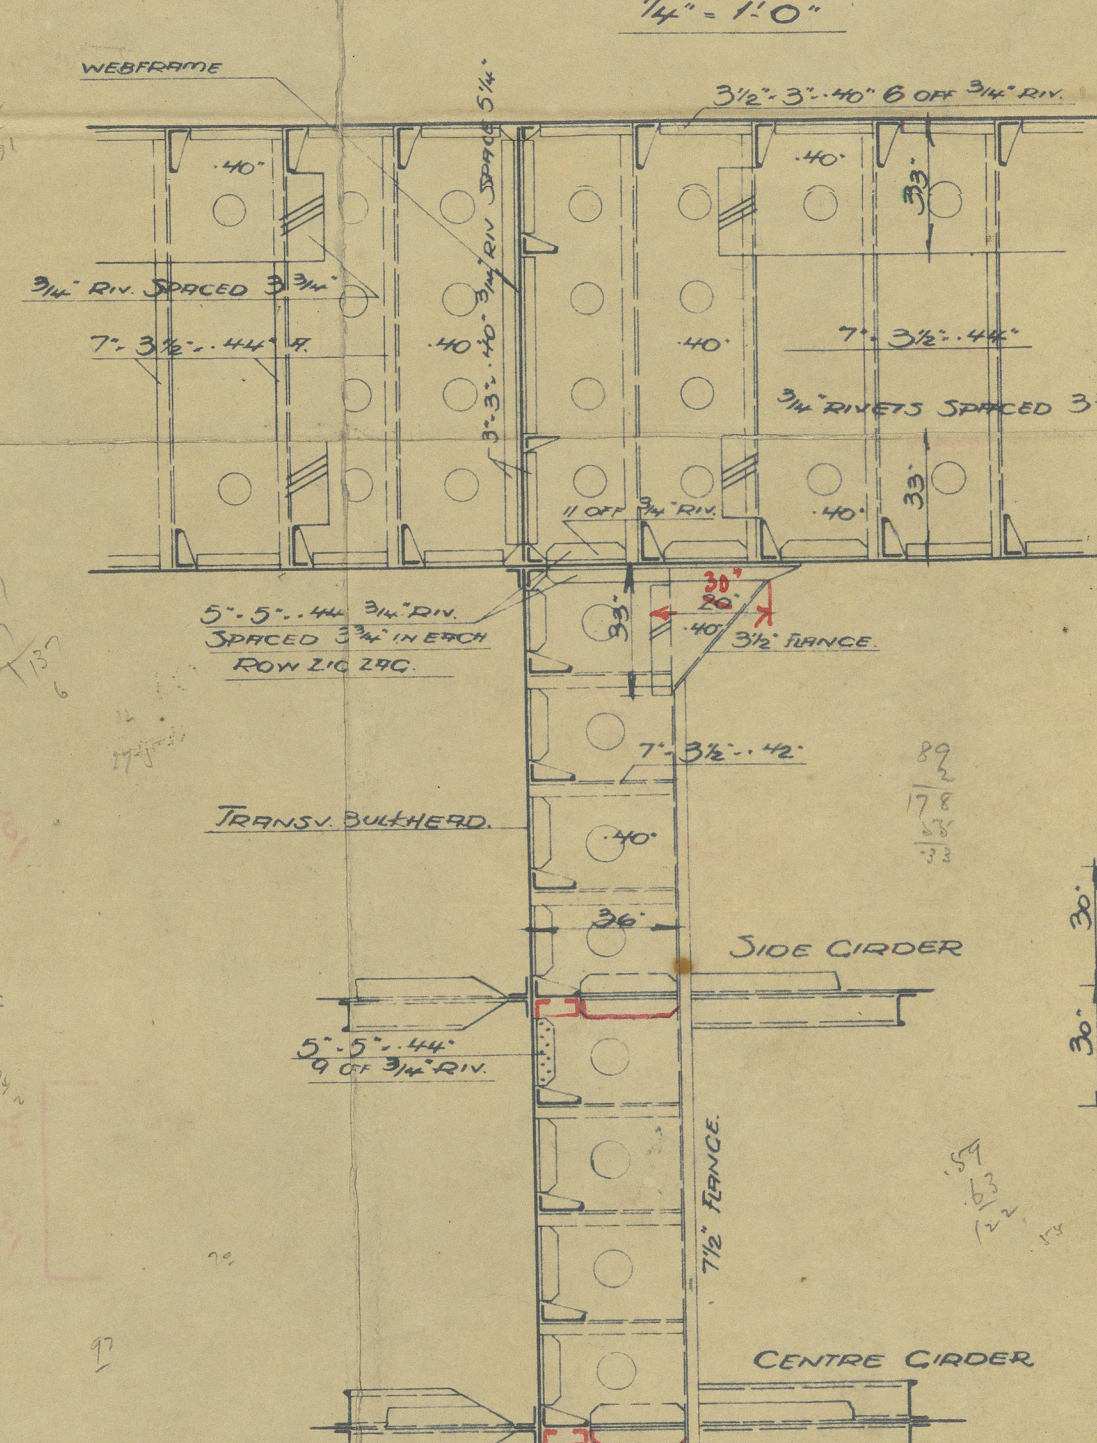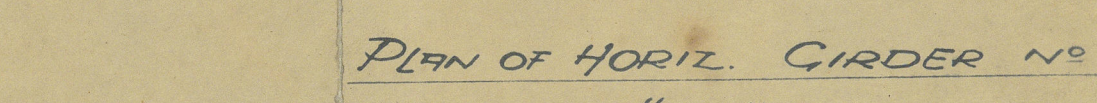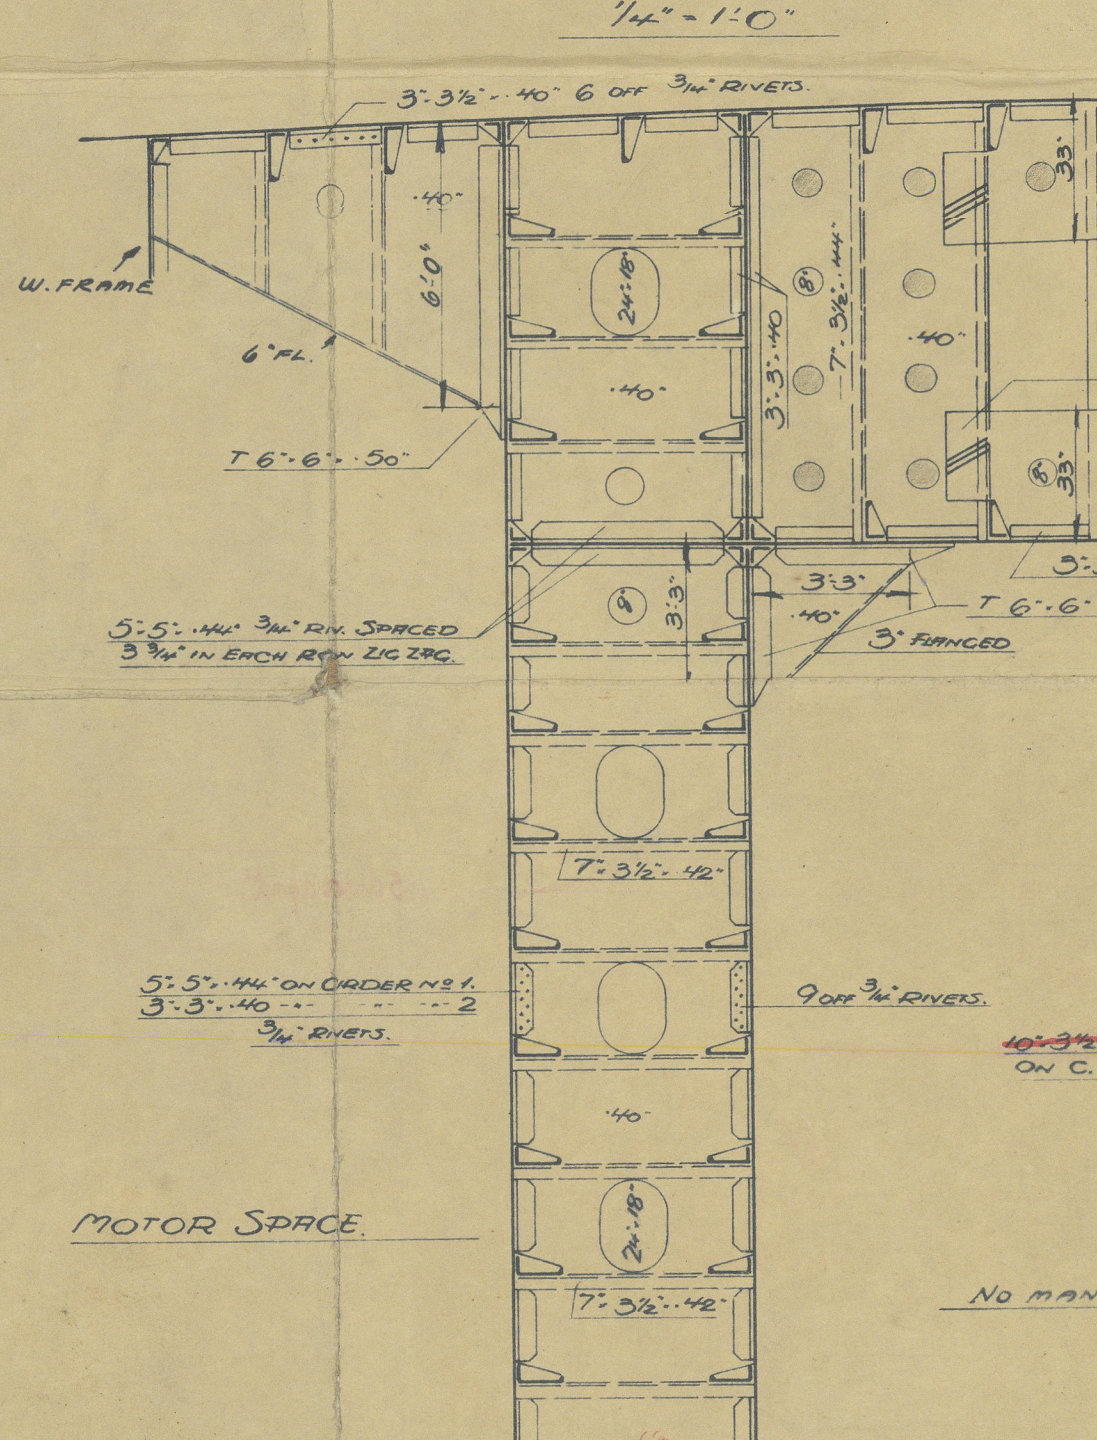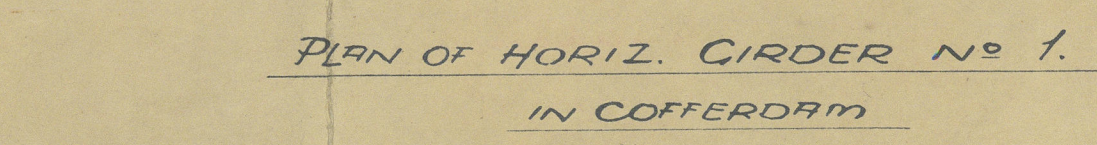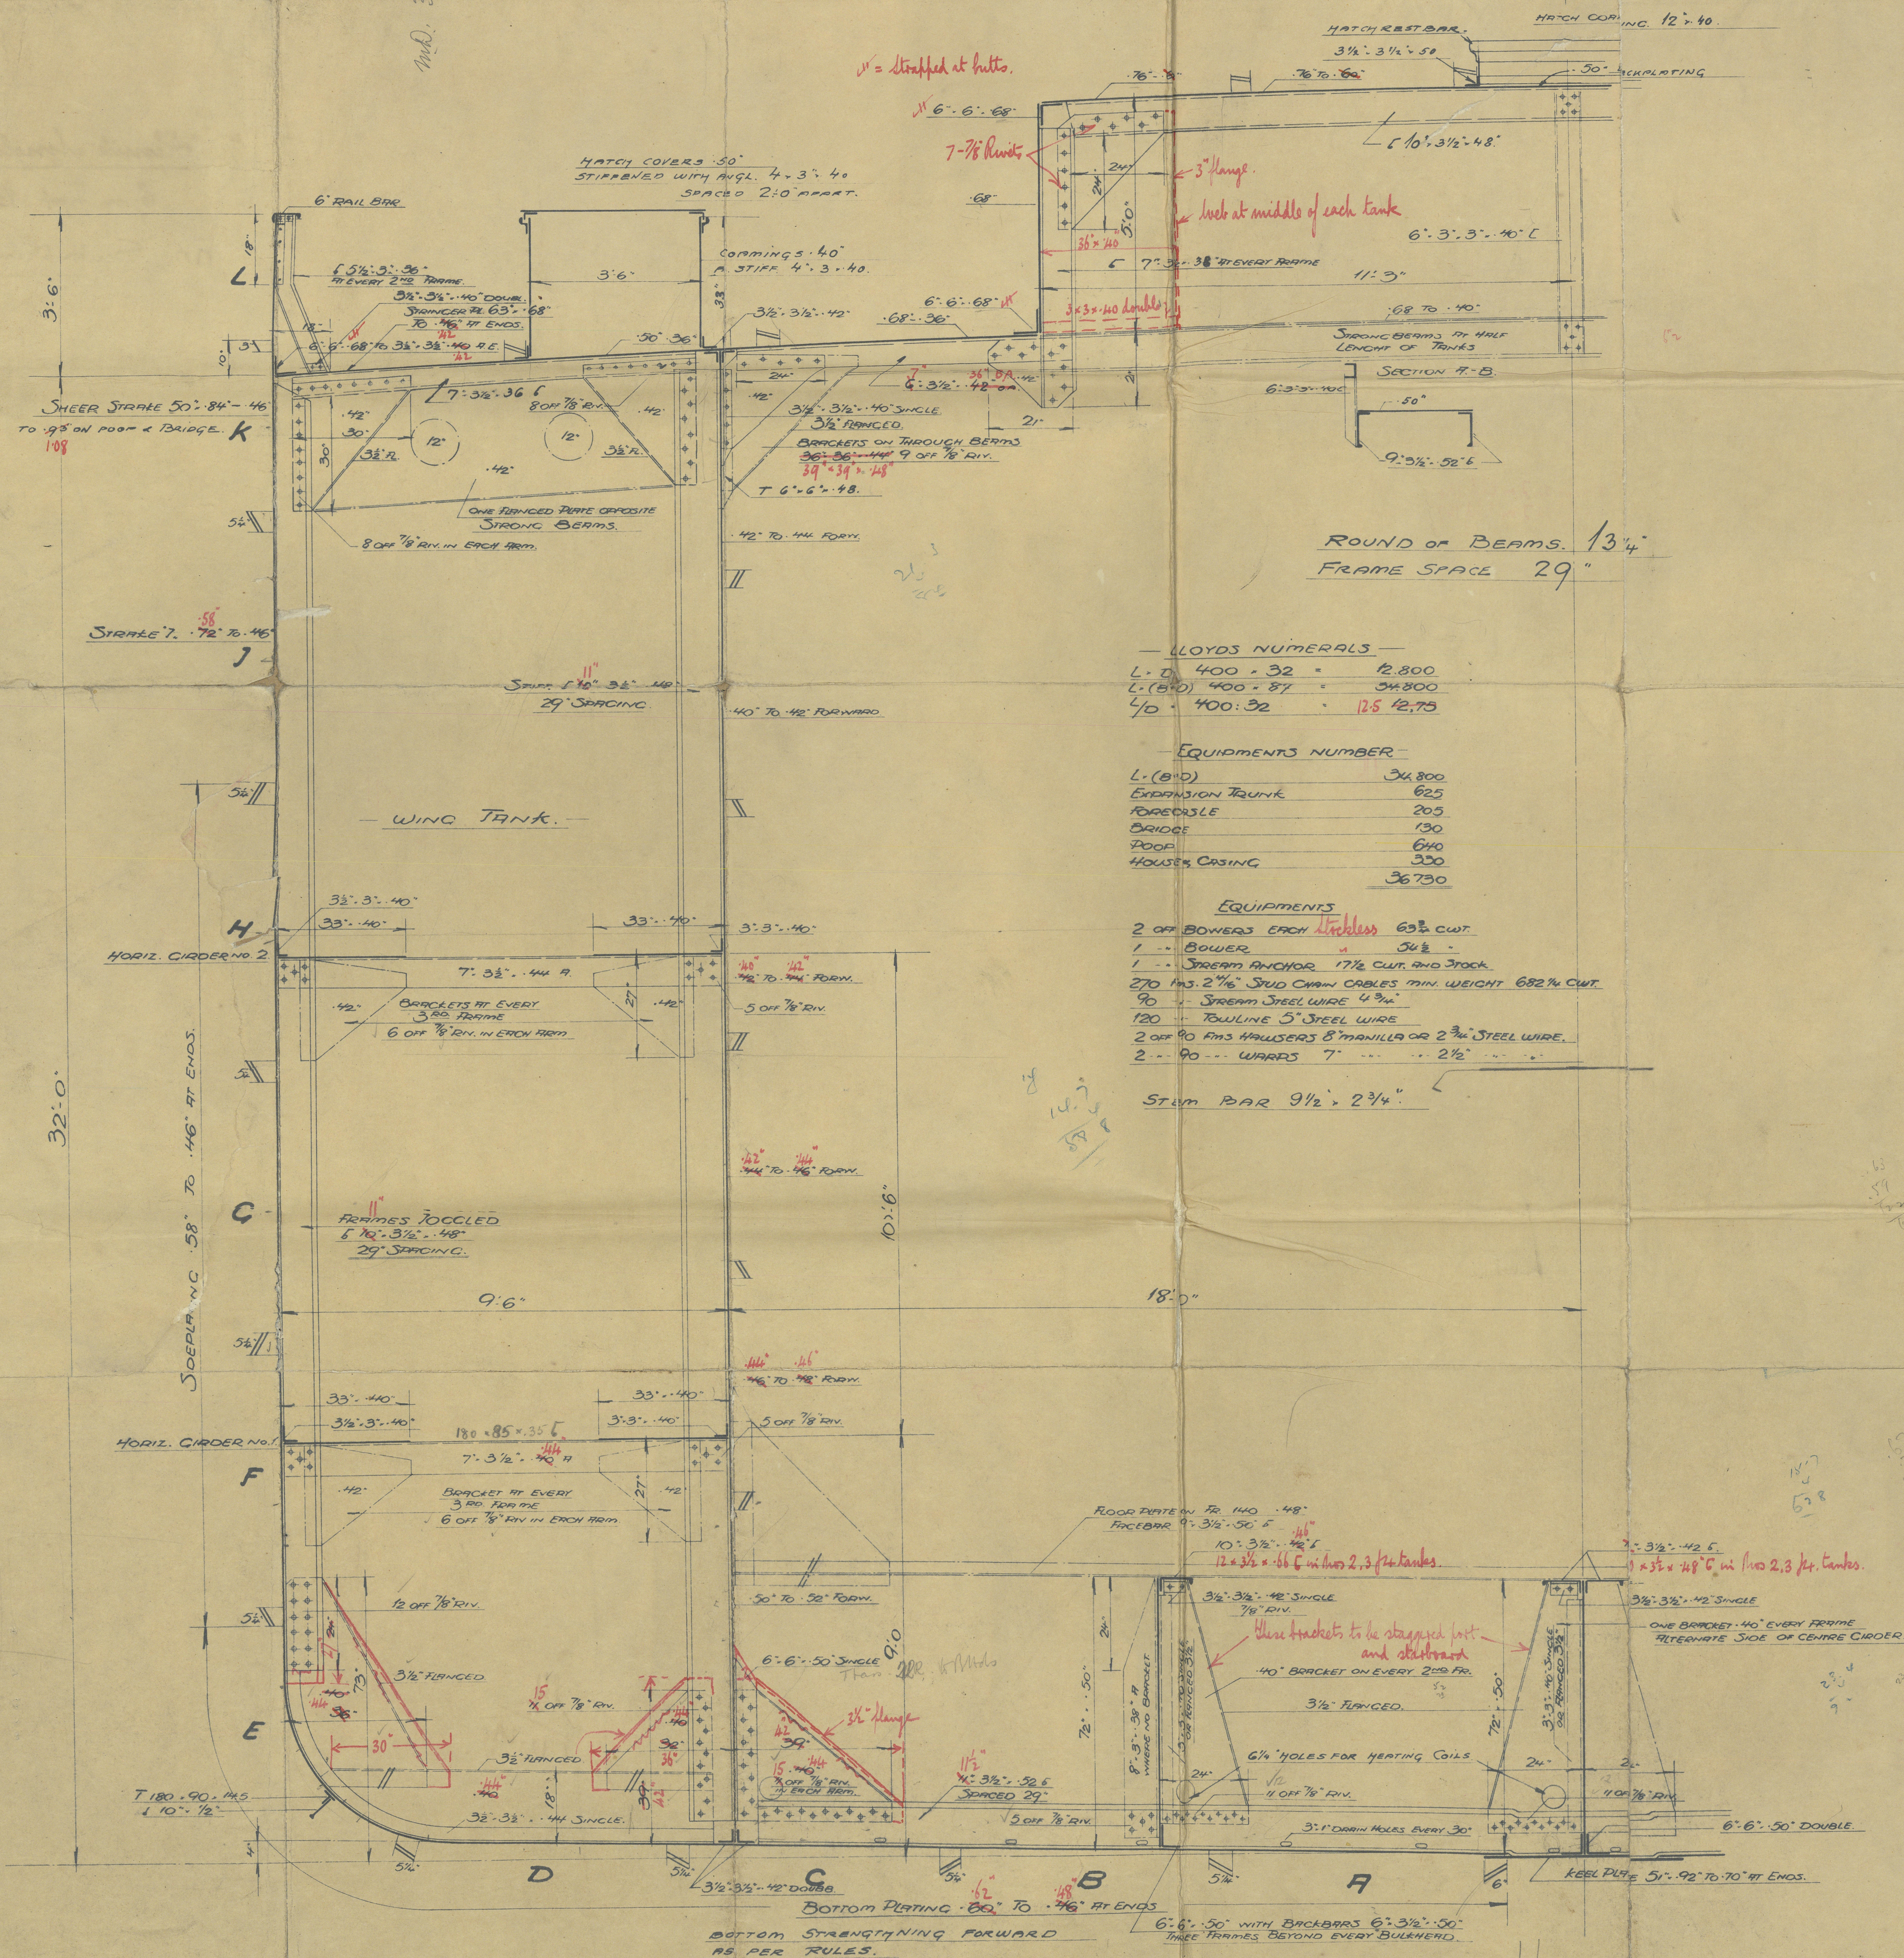

M/s "South America"

^{ex}
"Henrick Ameln"

Gpn 8494.

Midship Section.

W261-C036



© 2019

Lloyd's Register
Foundation