


HOLLOW FORGED SEAMLESS STEEL BARREL FOR BOILER STEAM DRUM
 DEPRESSIONS OCCURRING ON INSIDE AND PROPOSED
 RELATIVE POSITION OF SAME TO TUBES.



CONTRACT NO 932

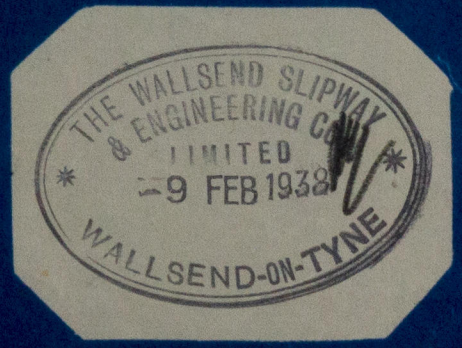

Noted. J. Mac
 12/4/38

25
 29/1/1938

SKETCH NO 932
 6

W251-0216

Contract No 932.

Steam drum for W.T. Roders
Sketch showing position of
depressions on inner surface.

W261 - 0216



© 2019

Lloyd's Register
Foundation