


STEEL BOILER 10-6 DIA 10-0 LONG 180 LBS W.P. LLOYDS





4740

4/6/14

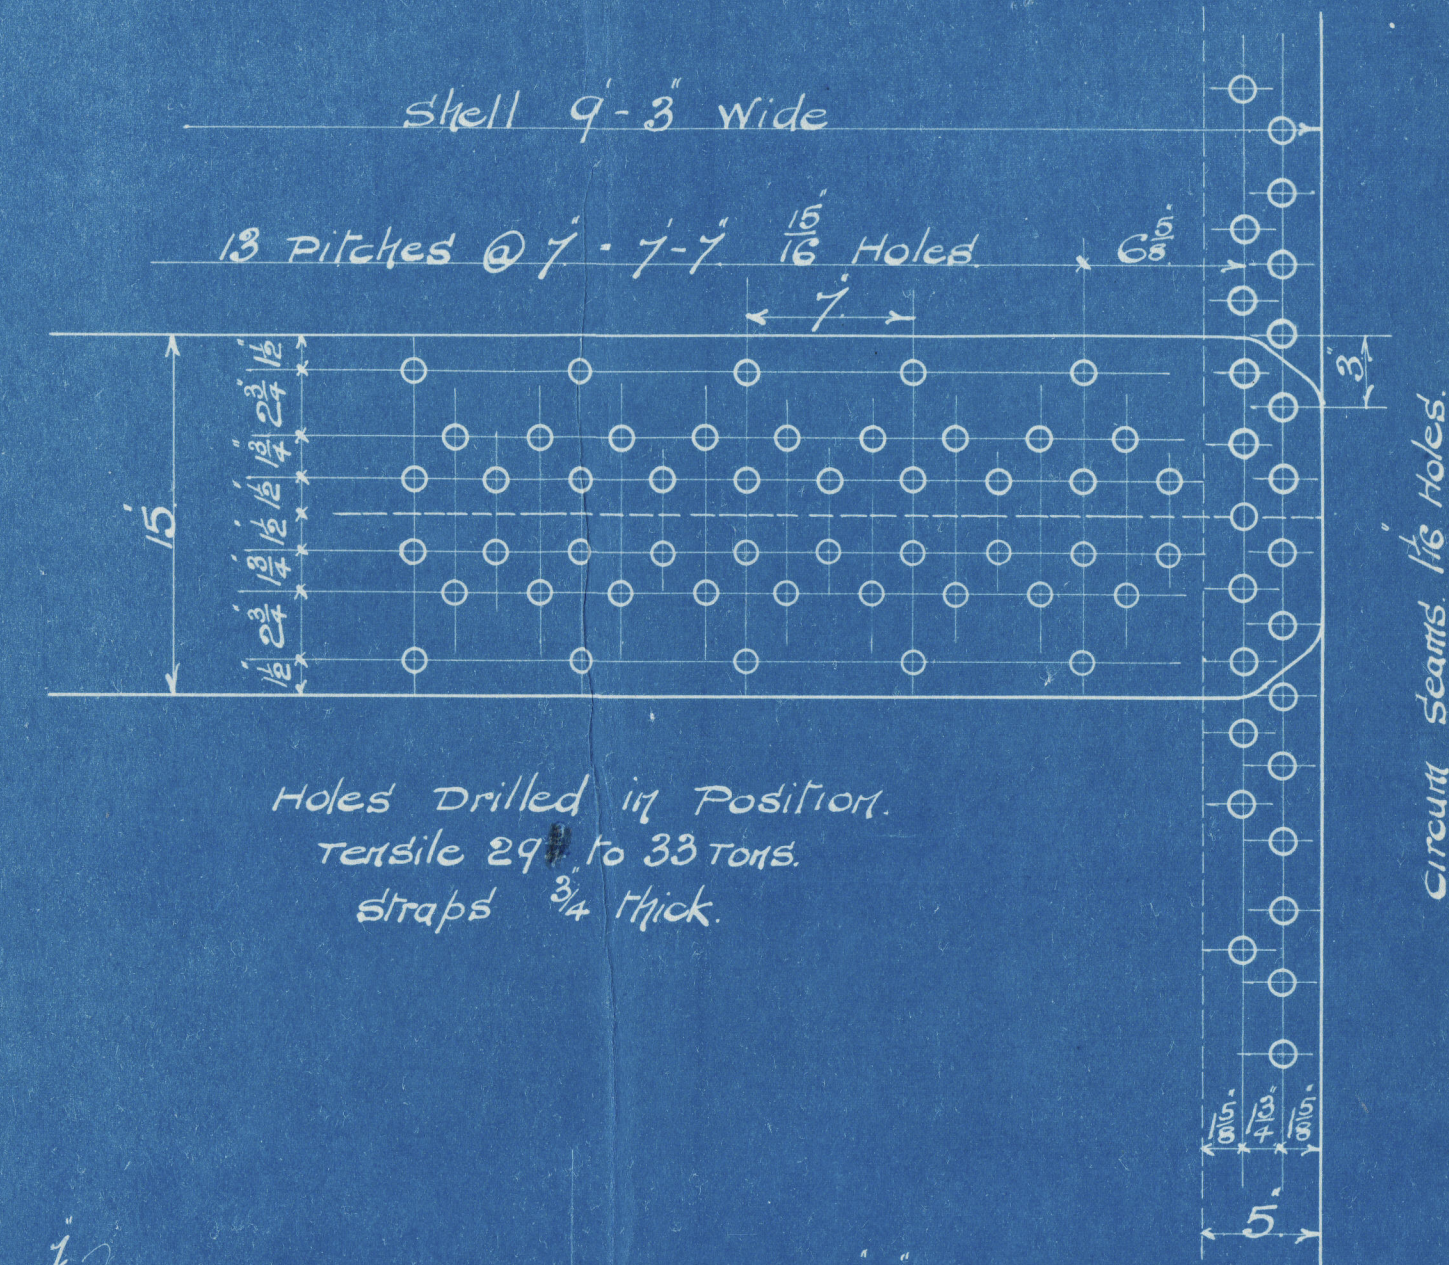

Heating Surface 990 sq ft
Grate Area 5-0 Bars 287 sq ft

Riveting of Circum Seams Above FF.

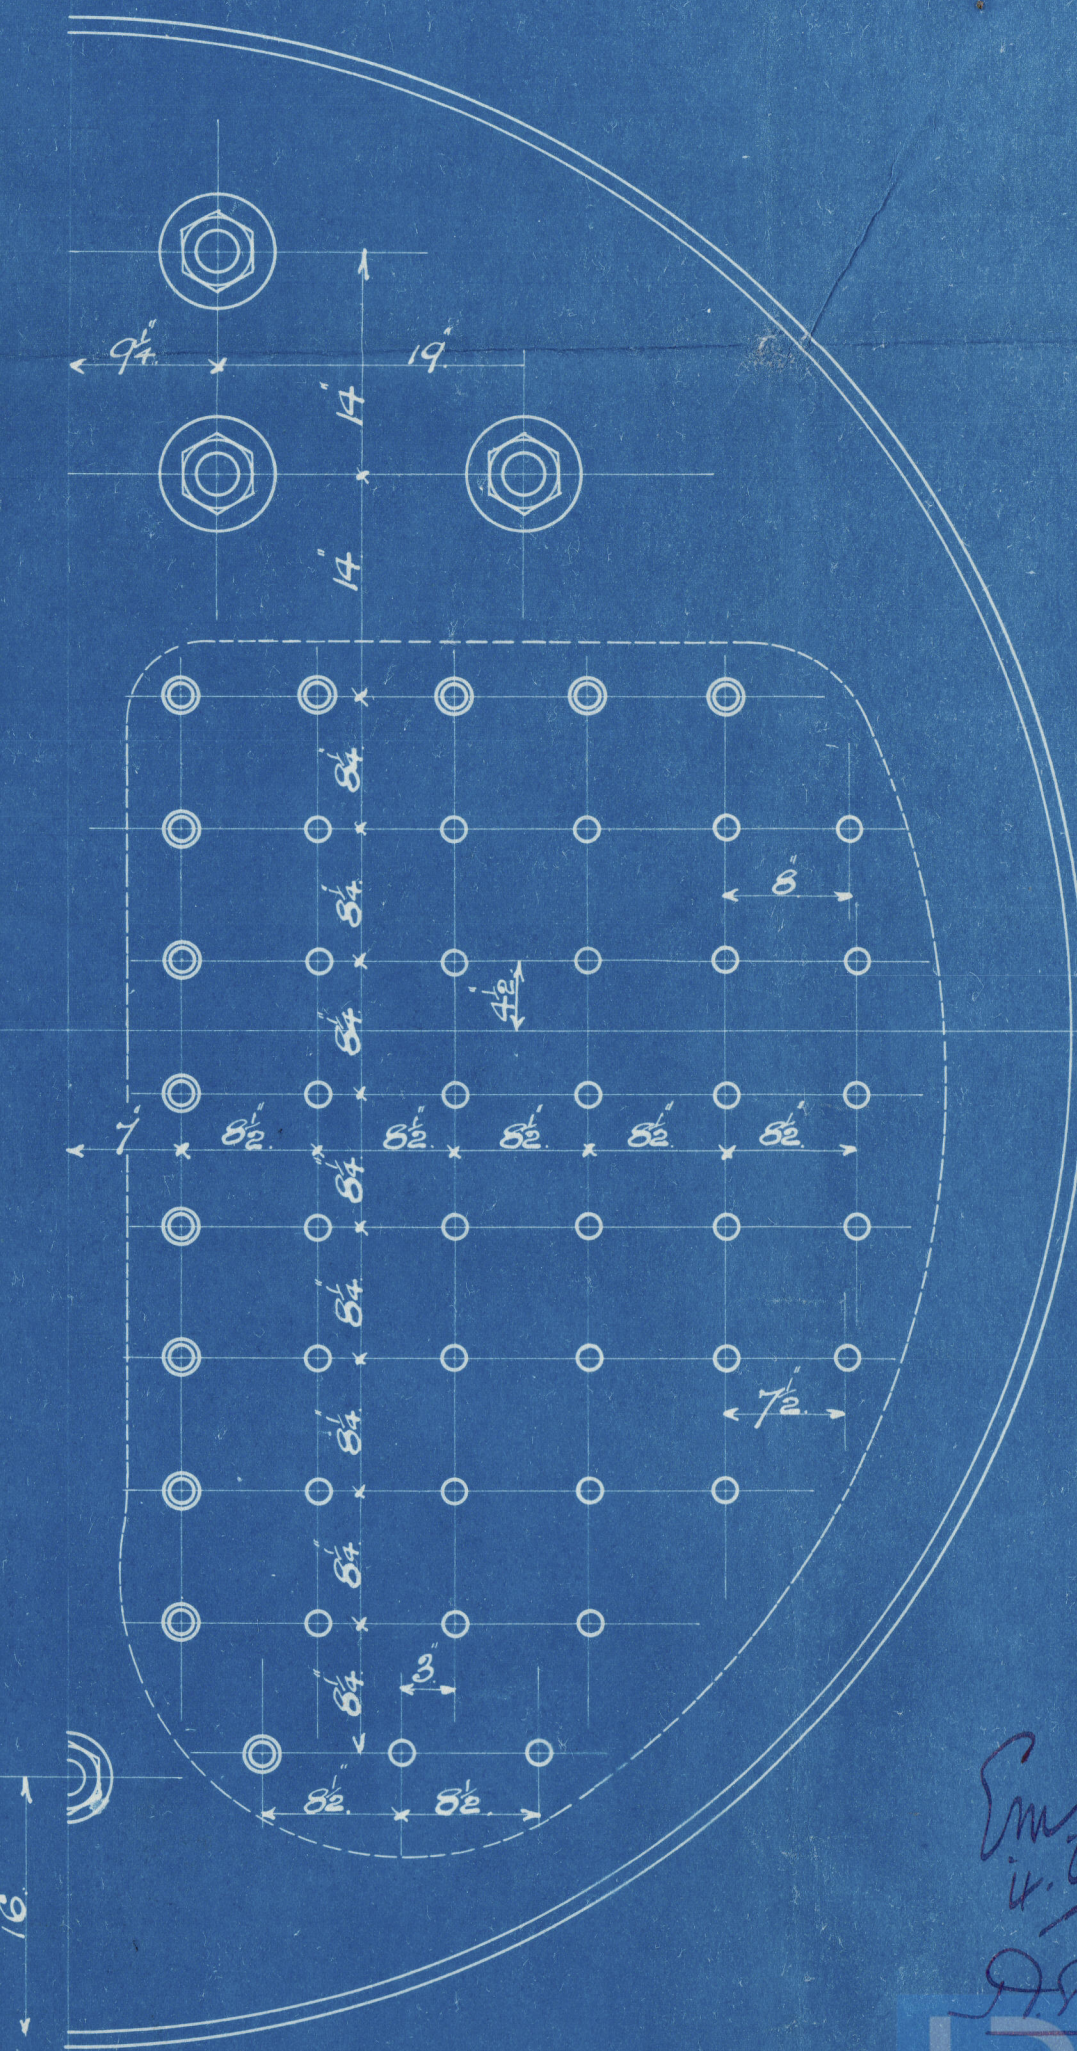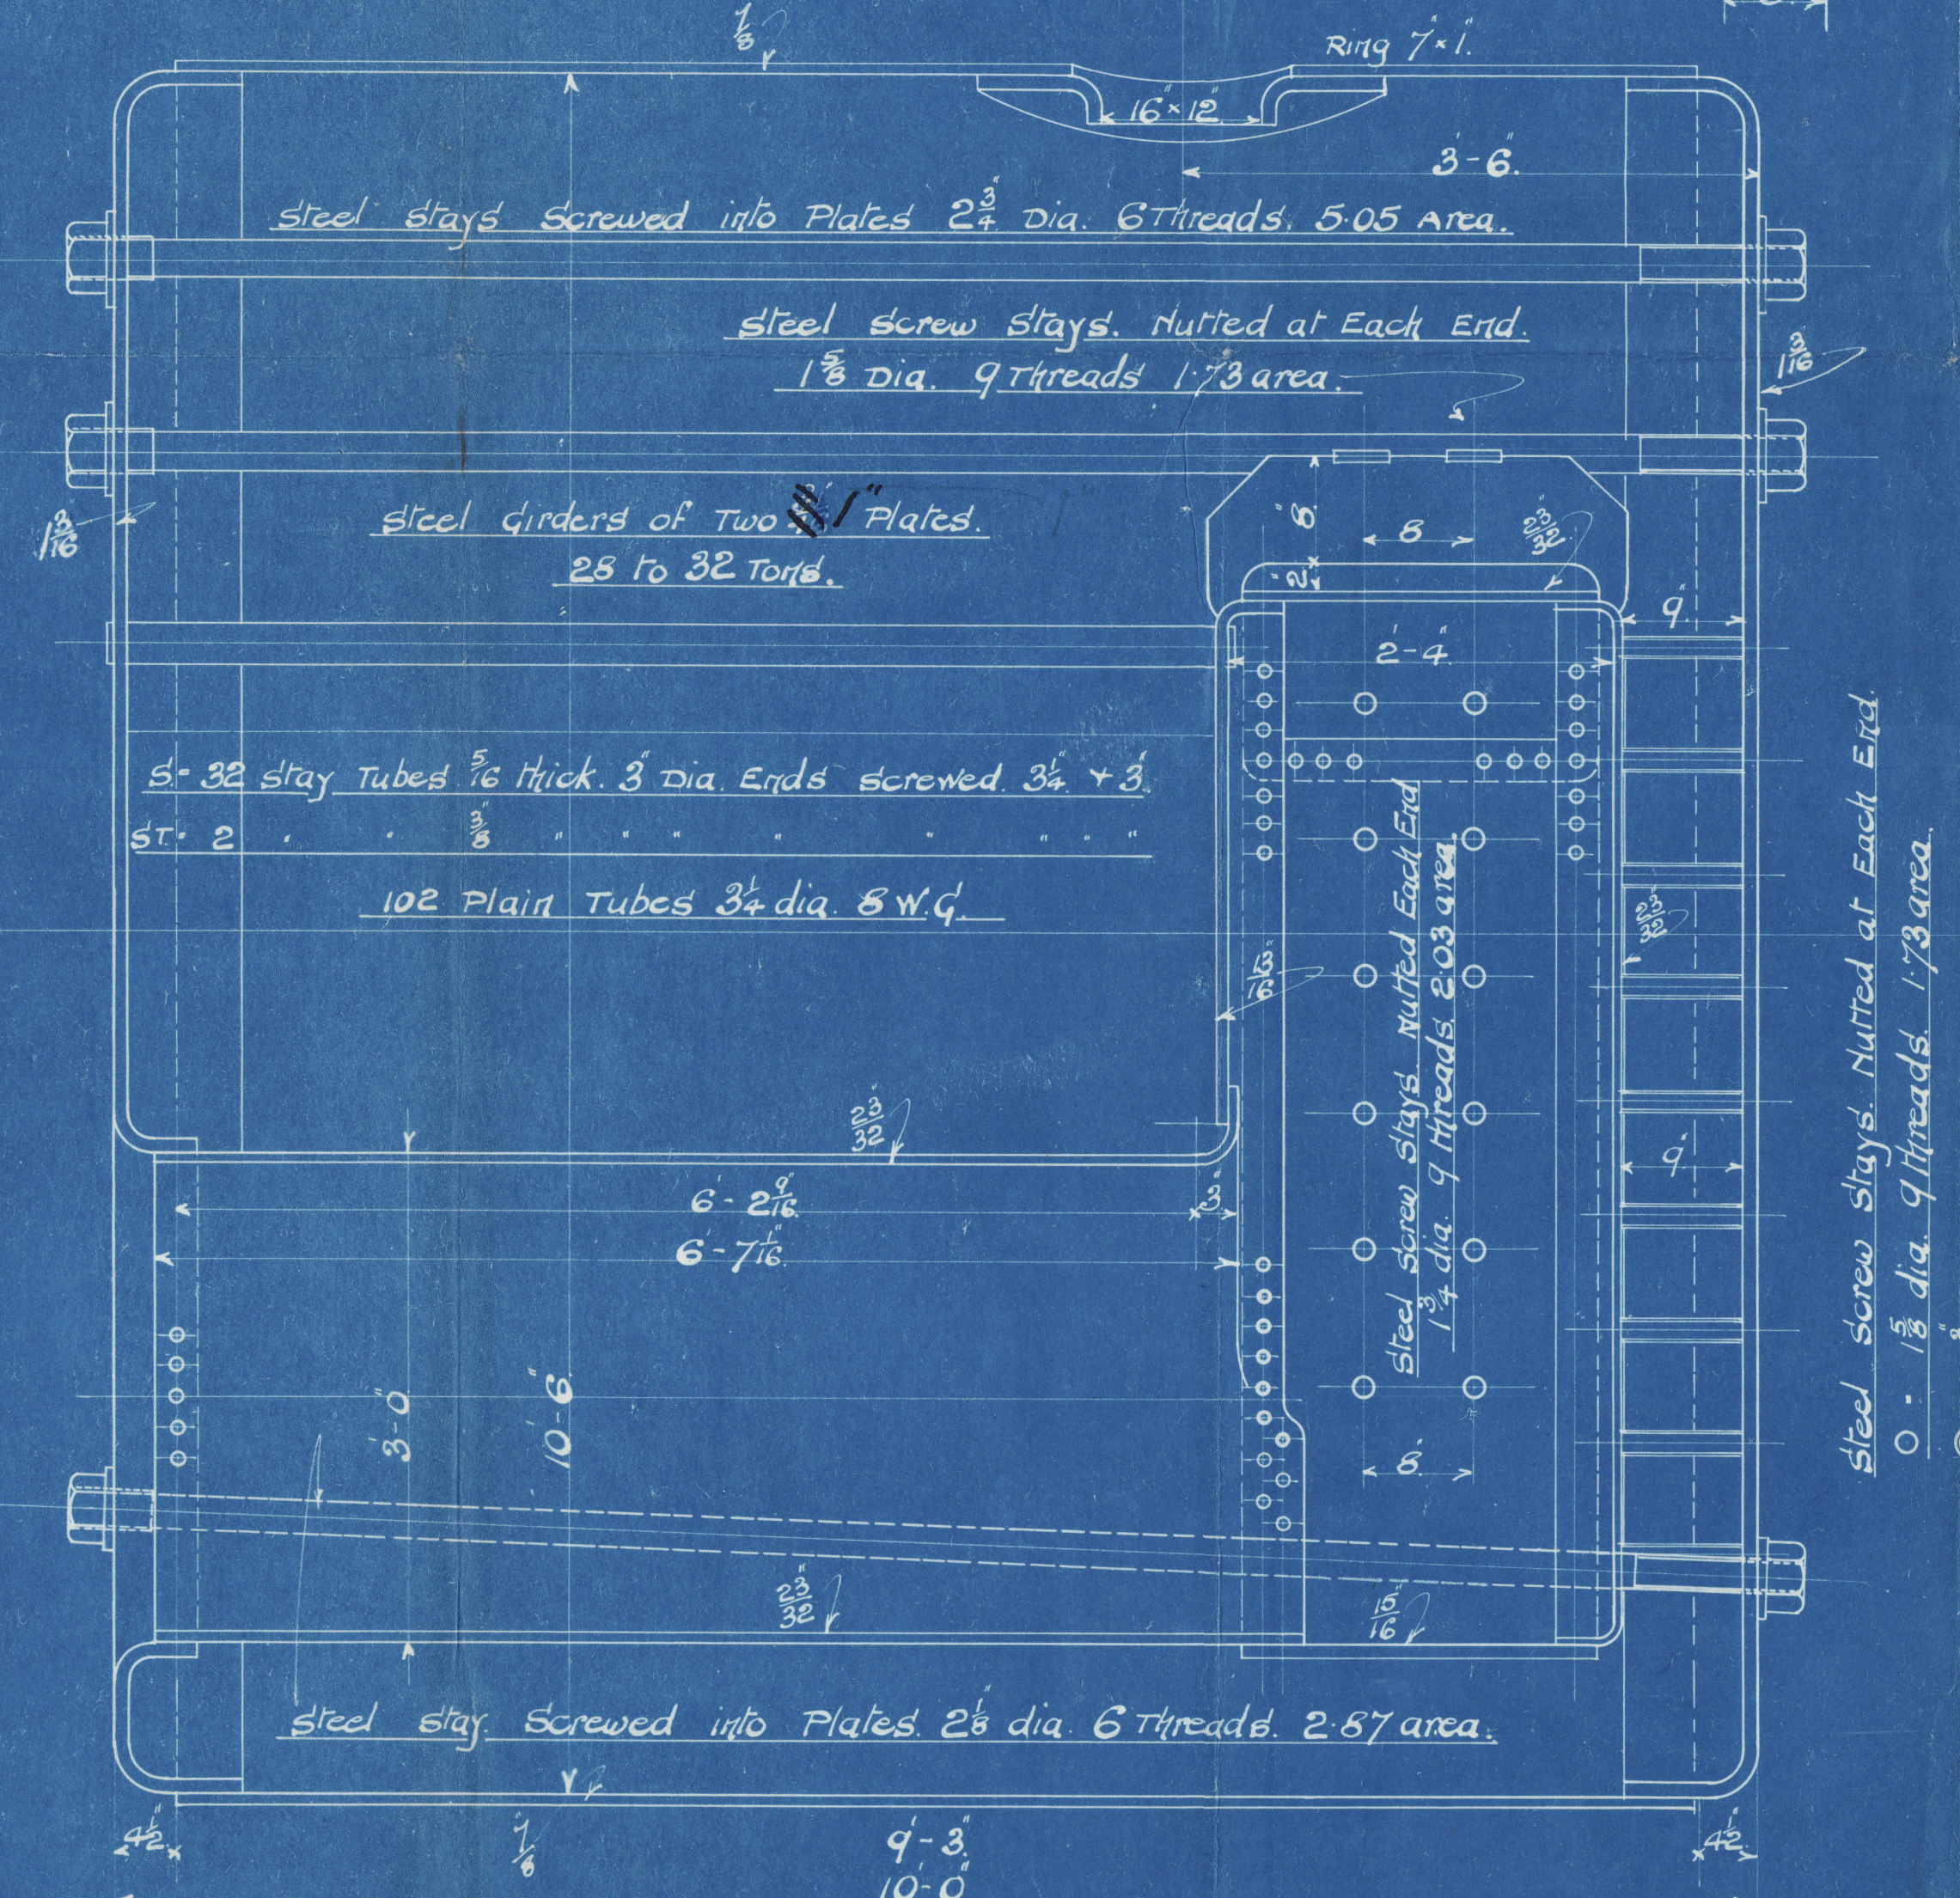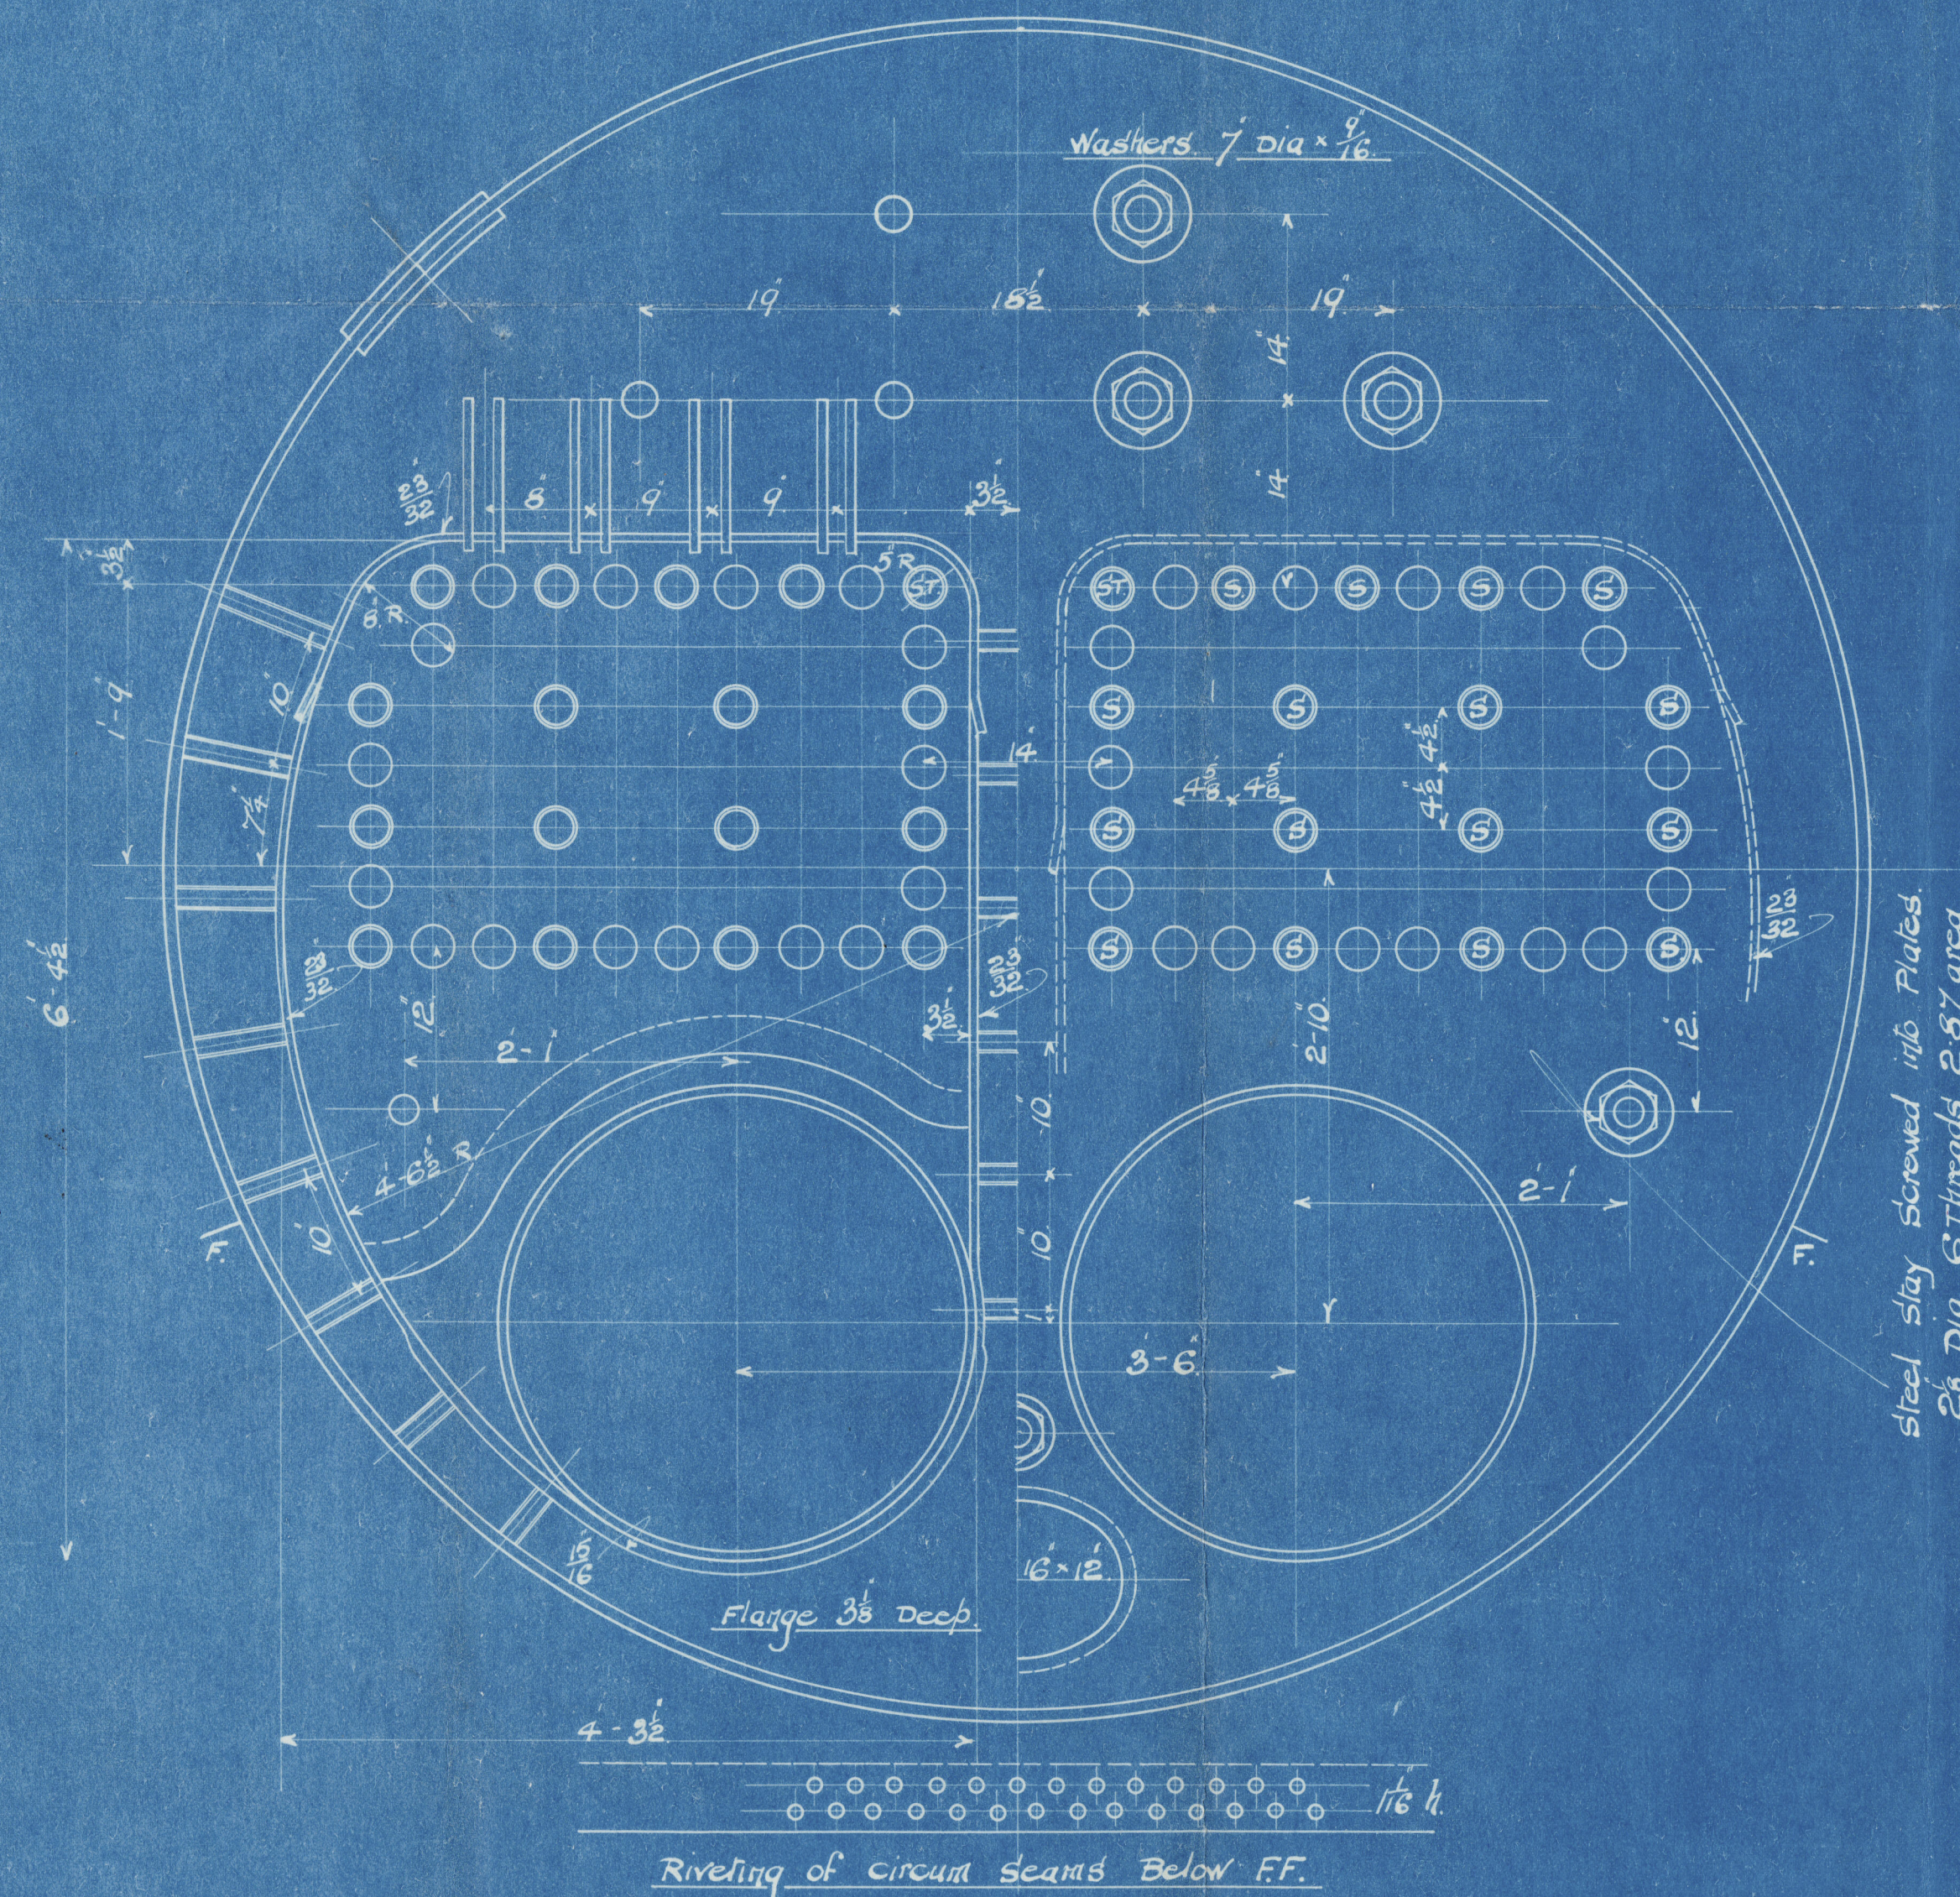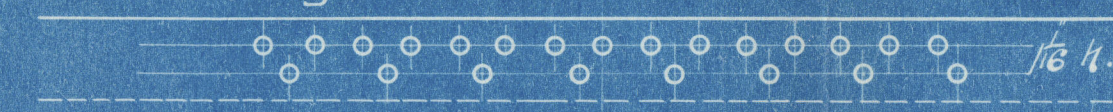

LLOYD'S REGISTER
MIDDLESMOUTH
30.5.14

W.P. 180 LBS
4/6/14

Lloyd's Register
Foundation

W262-0017

Thos Riley Bros Ltd

Boiler No. 4740

for

Thos Sir Jas Laing & Son Ltd.

S. S. No. —

Working Press 180 lbs



No. 5370
LLOYD'S TEST
360 lbs.
29.8.14. J.K.

Lab Rpt No. 8624.

of "Stockwell."

n. n. "Stamwell"

Sld. 26290



© 2019

Lloyd's Register
Foundation

W262-0017