


Particulars of 2 Boilers.		
Heating Surface of Tubes	- -	4948 sq.ft.
- - - - - Furnaces		380 " "
- - - - - Comb. Chamb.	--	595 " "
- - - - - Back Tube Plates		116 " "
Total Heating Surface		= 6039 sq.ft.
Grate Surface		= 147 sq.ft.

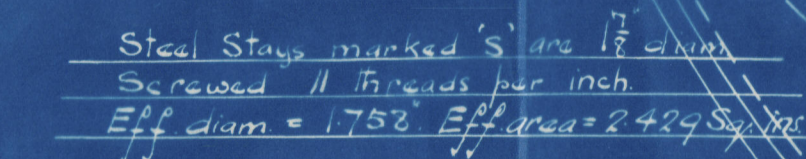

W262-0044



Central No

824

In Arives Jan

May 00 824

180 ll. m.p.

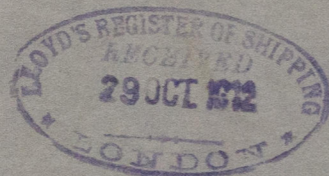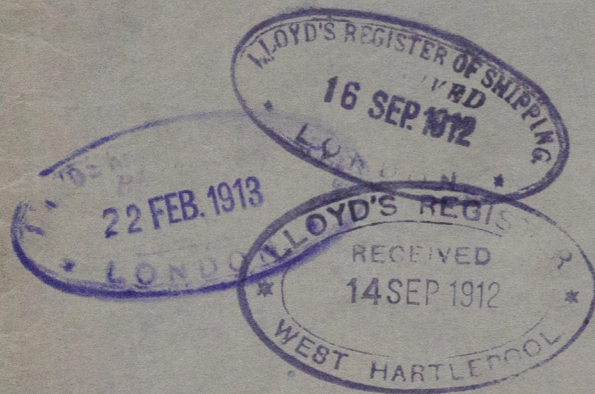

S.S. "Pensilva"^u

Apl Dpt. No. 14659.

n. n. "Sloga"⁷

W262-0044



© 2019

Lloyd's Register
Foundation