








MIDSHIP SECTION.

W. GRAY & Co's^s No 824 1828 1833

(824 "Pensilva") Hartpl. Rpt. no. 14659.
N.N. SLOSE

(828 "Penkallow") Hartpl Rpt no. 14702

(833. "Penmorrah" Hpl report No. 14780)

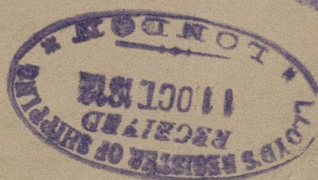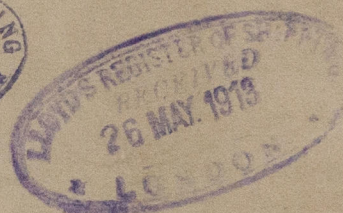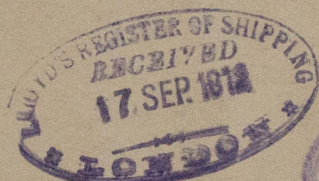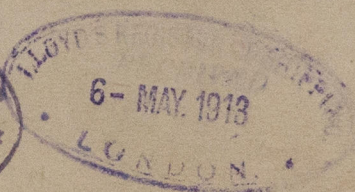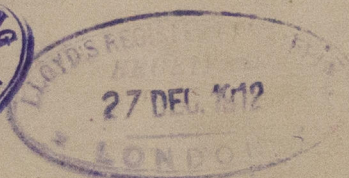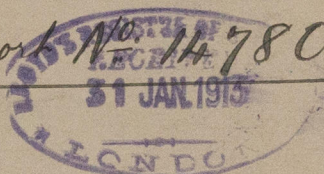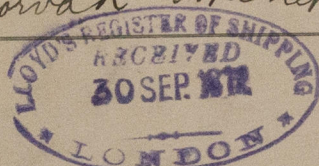

© 2019

Lloyd's Register
Foundation

W262-0045