

PROFILE.

SCALE 3" = ONE FOOT


Bridge Deck Beams 8 1/2" x 3" x 46 Bolt Angles Knees 20" x 40"
 " " " 7" x 3" x 40 " " "

Upper Deck Beams

Beams under P. B. & J. 8 1/2" x 3 1/2" x 50 Bolt Angles Knees 36" x 52"
 " " " 7" x 3" x 42 " " "
 Two Beams outside Bridge 9" x 3 1/2" x 50 " " "
 " " " 8 1/2" x 3" x 50 " " "
 Beams in Peaks 6" x 3" x 40 " " " 21" x 42"

Hold Deck Beams 10" x 5 1/2" Bolts 2 angles 3 1/2" x 40 Knees 25" x 54"
 End Beams 1/2 L. 9" x 44 " 2" x 3 1/2" x 34 " " "

19.9.12
 3.10.12
 (No 828) 30.12.12
 (No 833) 31.1.13

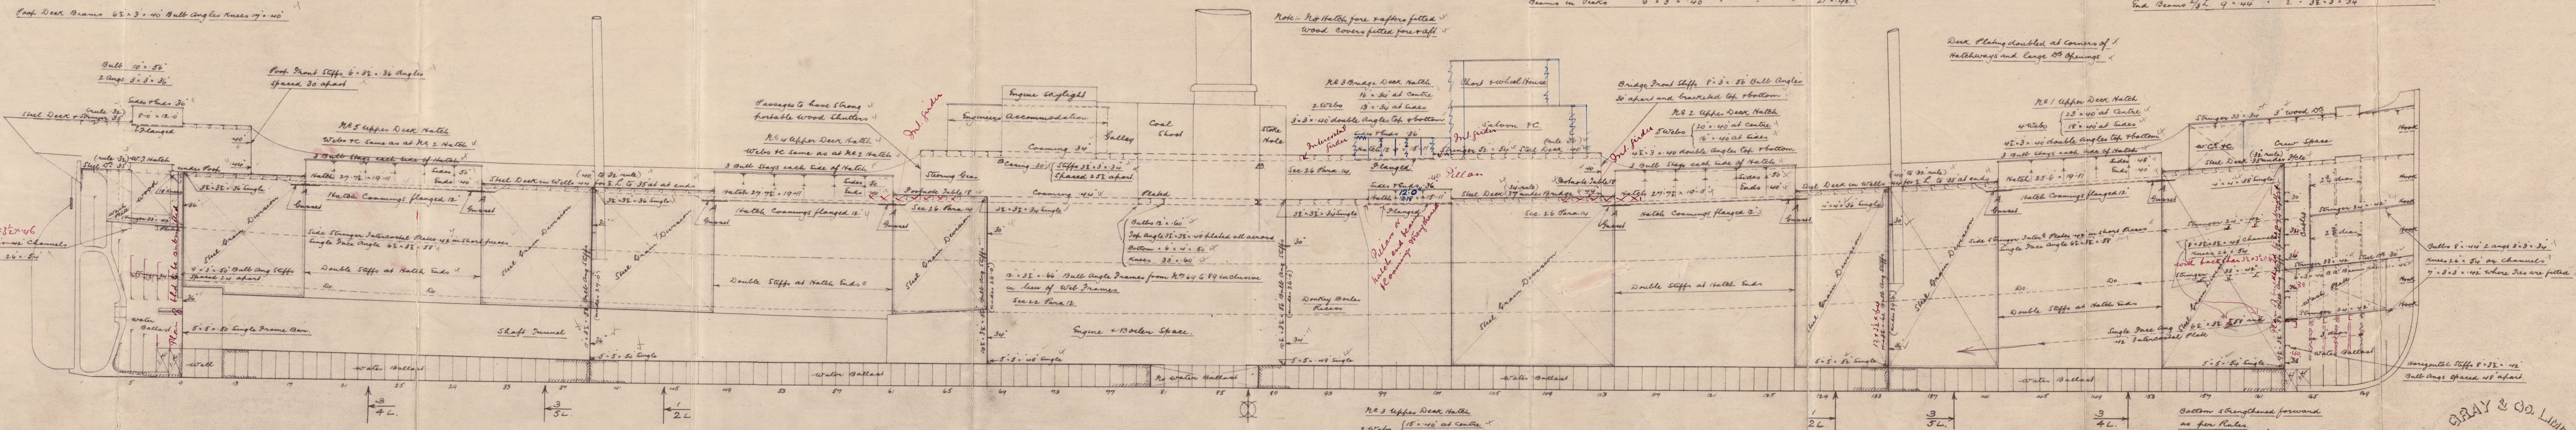


824 828. 833

824

GRAY & CO. LIMITED
 262-0046
 19.9.12







PROFILE

W. GRAY & Cos'. s/s N° 824 828

 Sloga Σ no. 1833
(824 Peninsula) 14659 HPL. RPT.

(828 Penhallow). Hpl Rpt no. 14702

(833 Penmorva) Hpl report N° 14780

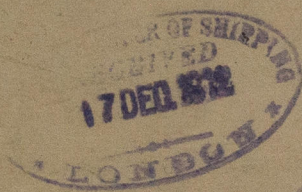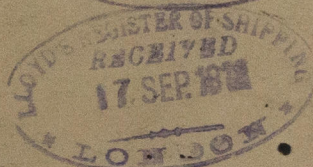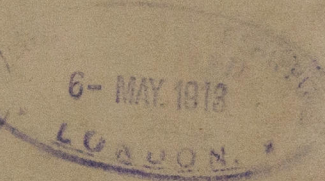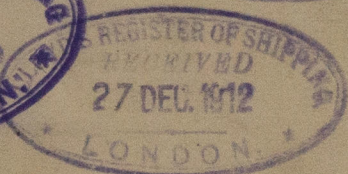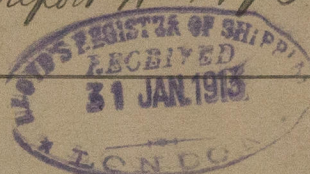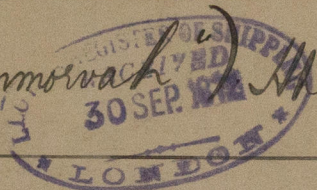

© 2019

Lloyd's Register
Foundation

W262-0046